


OVERALL LENGTH 26.1"

SECTION OF BOTTOM GUDGEON  
SCALE 3" = 1 FOOT

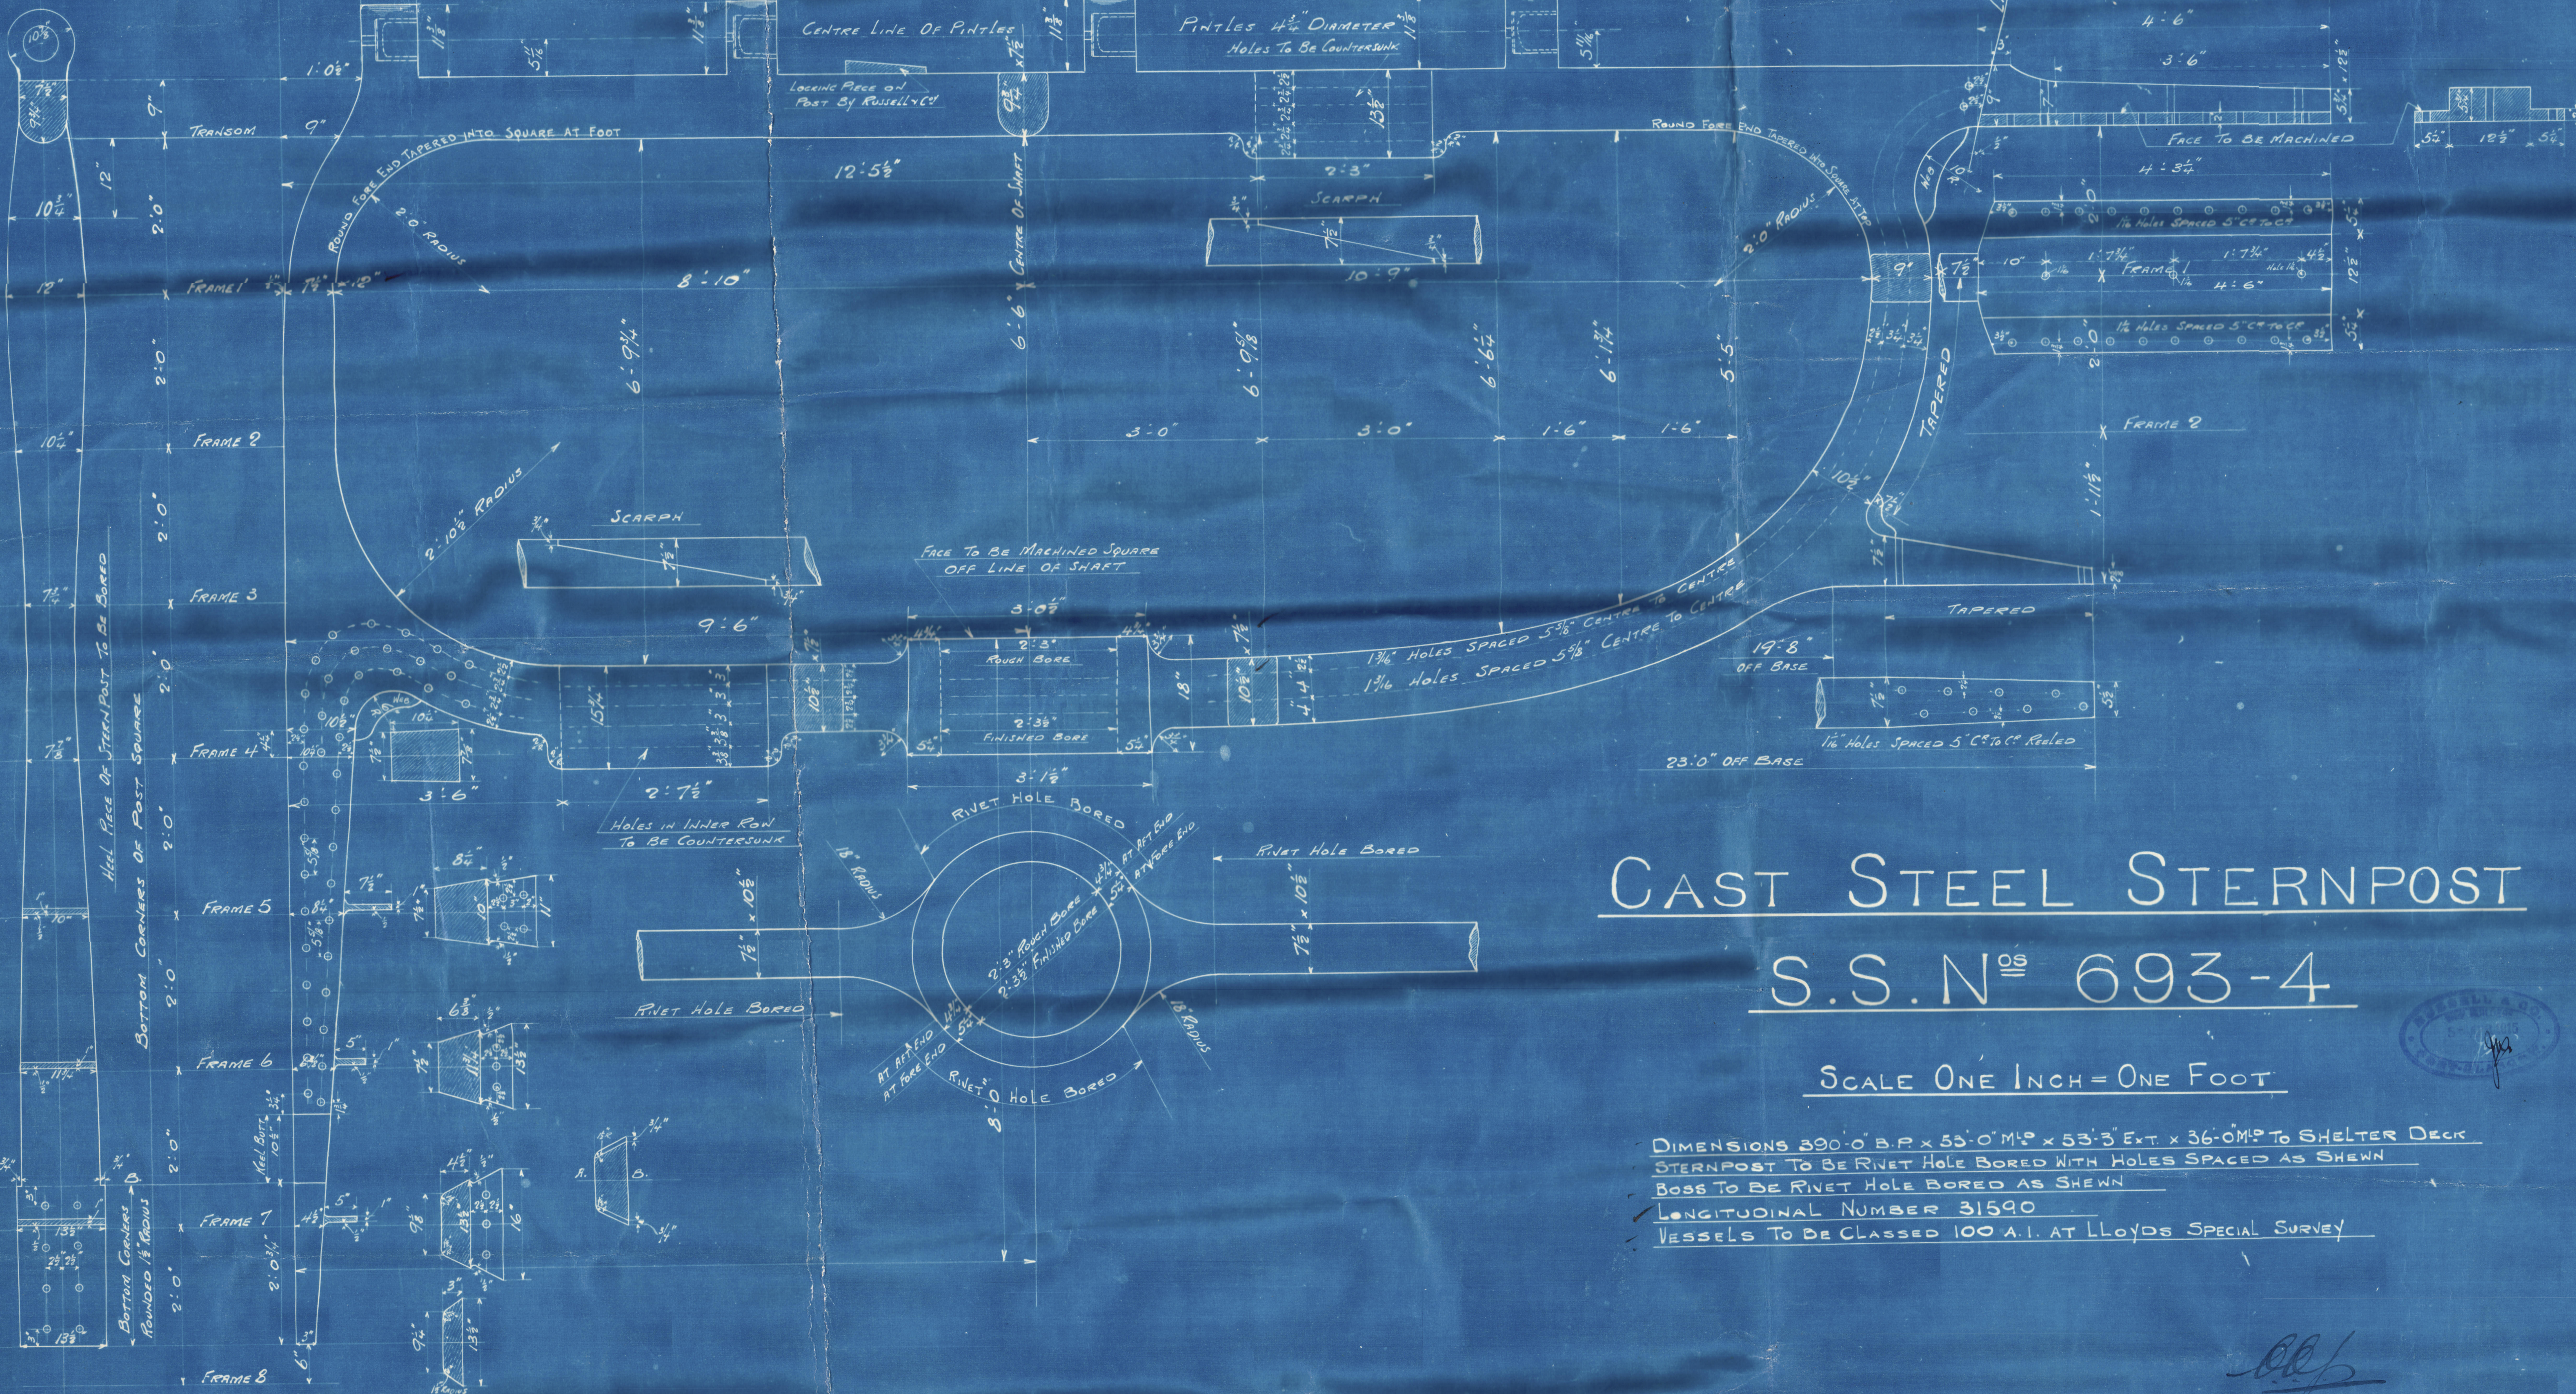


CAST STEEL STERNPOST  
S.S.N<sup>os</sup> 693-4

SCALE ONE INCH = ONE FOOT

DIMENSIONS 890'-0" B.P. X 53'-0" M.D. X 53'-5" EXT. X 36'-0" M.D. TO SHELTER DECK  
STERNPOST TO BE RINET HOLE BORED WITH HOLES SPACED AS SHOWN  
BOSS TO BE RINET HOLE BORED AS SHOWN  
✓ LONGITUDINAL NUMBER 31590  
VESSELS TO BE CLASSED 100 A.I. AT LLOYDS SPECIAL SURVEY

SECTION OF GUDGEONS & PINTLES FULL SIZE



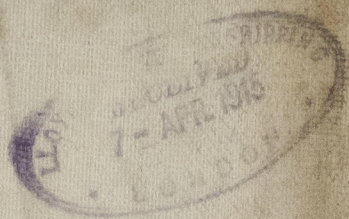


Musell Cor No 693-694

Cont Steel Stern Frame

Capo Noli

693 ~~Montilla~~

Shpt & Rpt No 17205

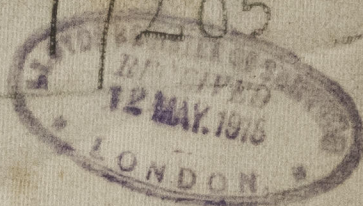

694 Rubiera

Shpt & Rpt No 17266



7.

"GAELIC STAR"

LI00-443600-019600



© 2021

Lloyd's Register  
Foundation