


Stern Post.
 Plans
 S.S. "Dane"
 Dublin Reports
 No 2688

4.11.05

— STERNPOST OF S.S. N^o 56. —

— SCALE ONE INCH = ONE FOOT. —

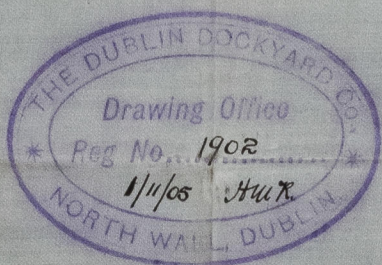

RIVETS $\frac{1}{8}$ DIA^s SPACED $5\frac{5}{8}$ C^s TO C^s

Query spacing of gudgeons. see sketch of pudder.

