4.11.05

RUDDER PLAN. S.S. No 56.

SCALE 1 INCH = ONE FOOT.

Rudder Plan
S.S. "Berne"
Dublin Repairs
No 2638.

THE DUBLIN DOCKYARD CO.
Drawing Office
Reg No. 1901
1/11/05
NORTH WALL, DUBLIN.

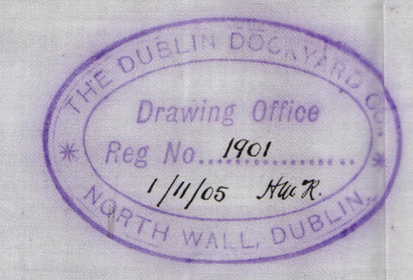

4.11.05

RUDDER PLAN. S.S. No 56.

SCALE 1 INCH = ONE FOOT.

Rudder Plan
S.S. "Bernus"
Dublin Reports
No 25638.

THE DUBLIN DOCKYARD CO.
Drawing Office
Reg No. 1901
1/11/05
NORTH WALL, DUBLIN.

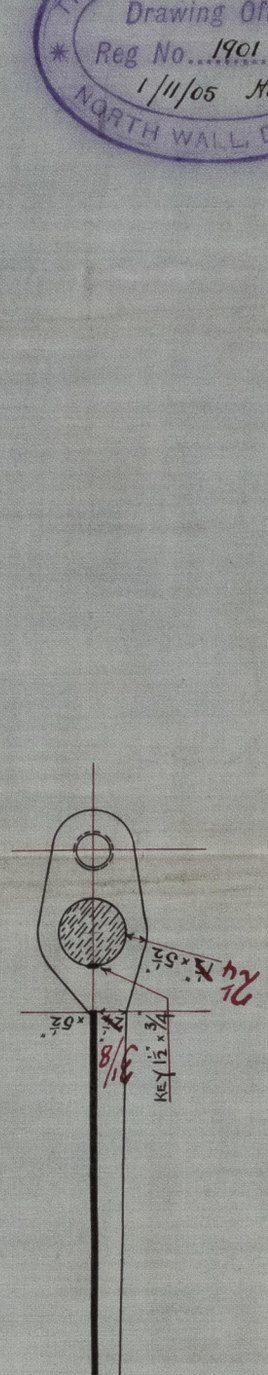

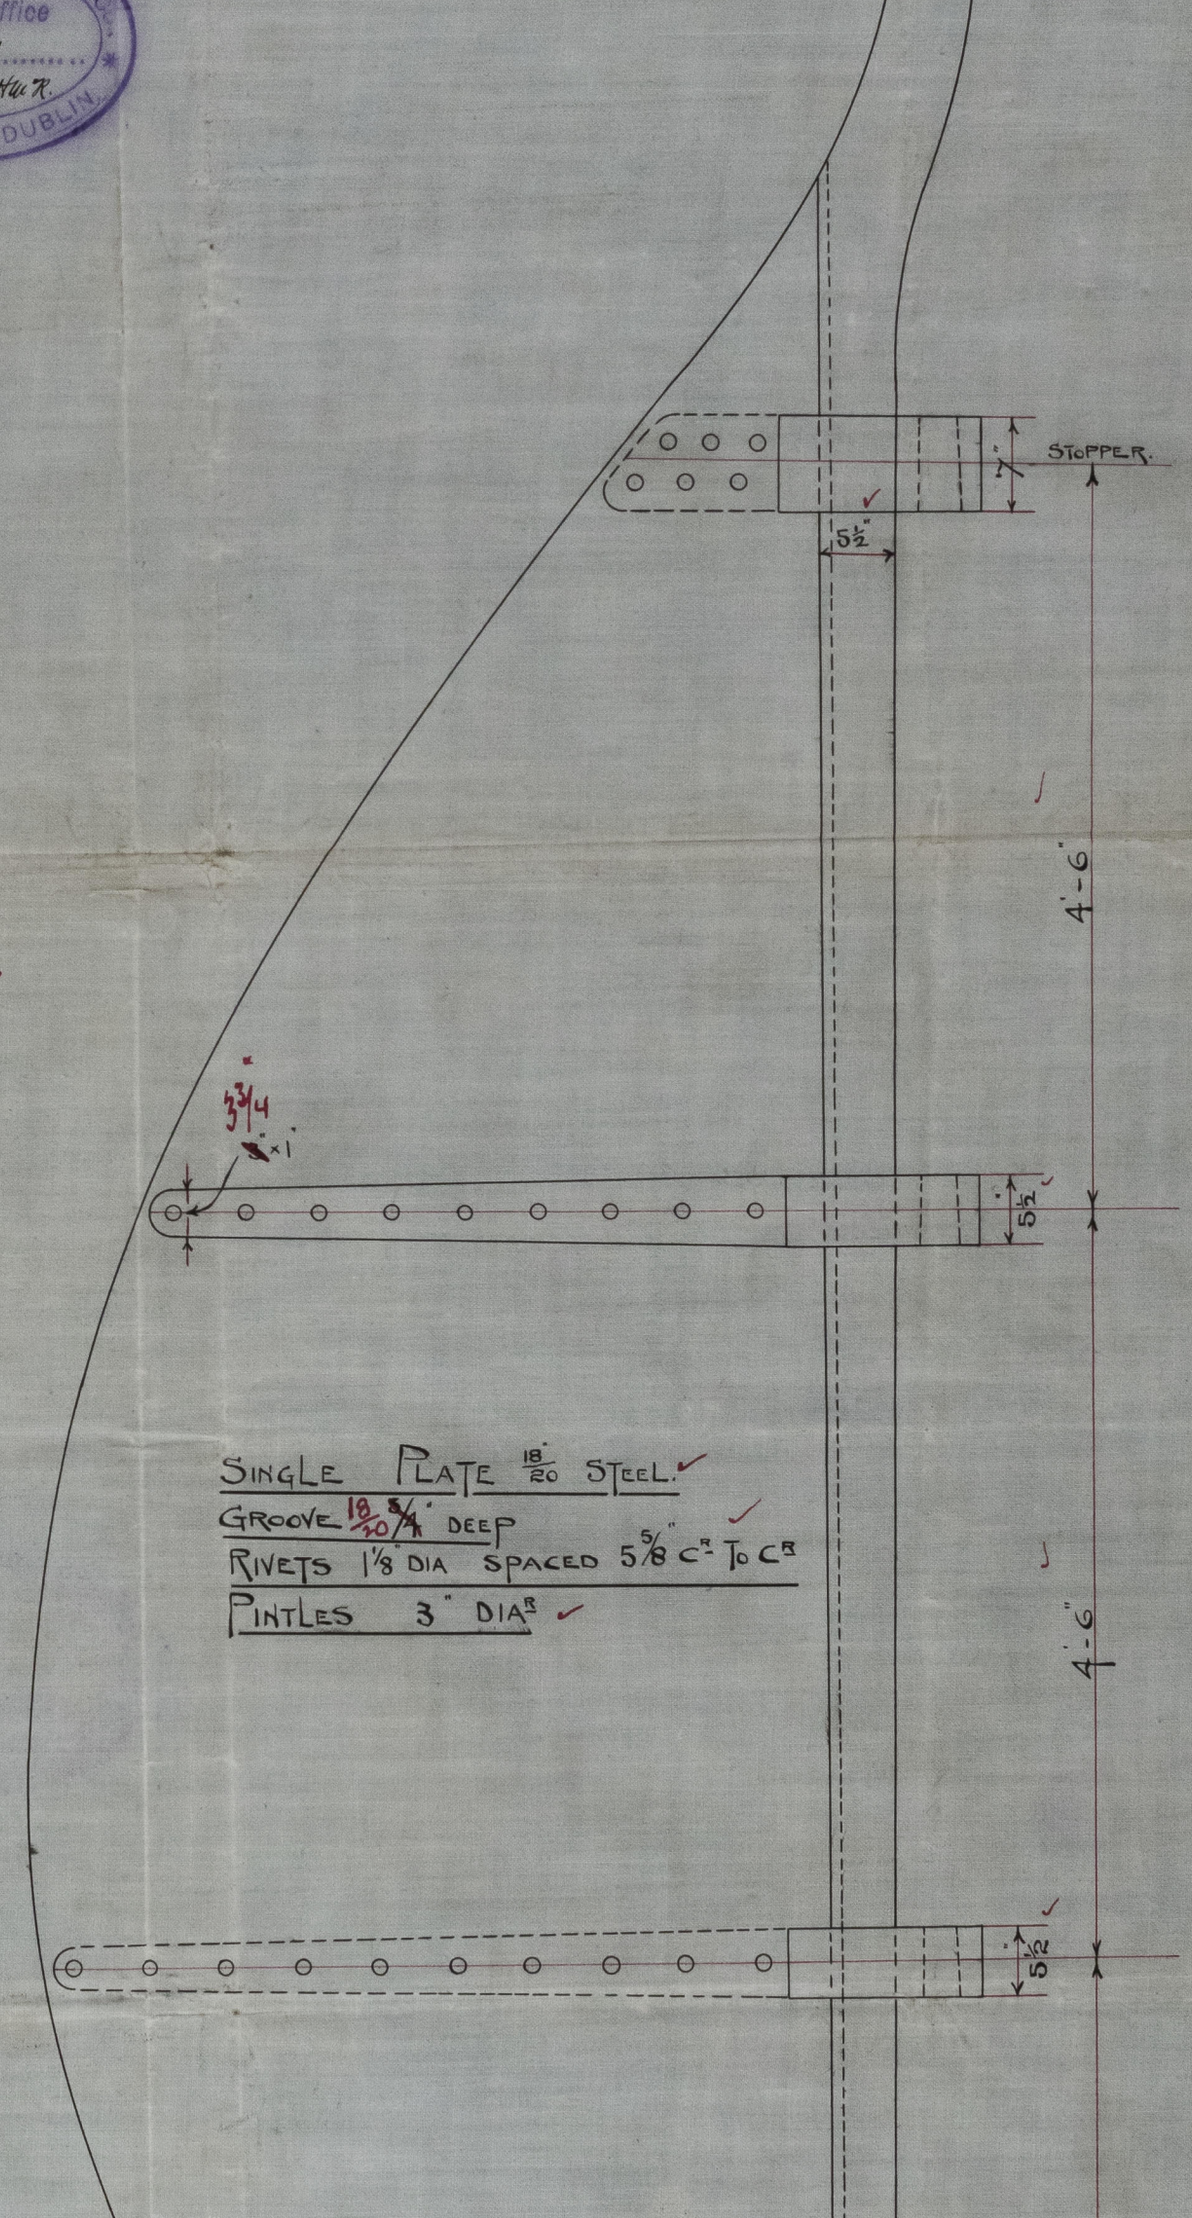

C.B.
4.11.05

© 2021
Lloyd's Register Foundation
009655-009666-0180