


"HULL SECTION."

EQUIPMENT.

NUMERALS.

FRAME № 28.

MIDSHIP SECTION.


Ferguson Bros (P. 3) Ltd
Lord N. 378. Empire Ritz 
Hull Sections
as fitted



© 2021

Lloyd's Register
Foundation

009667-009673-0180

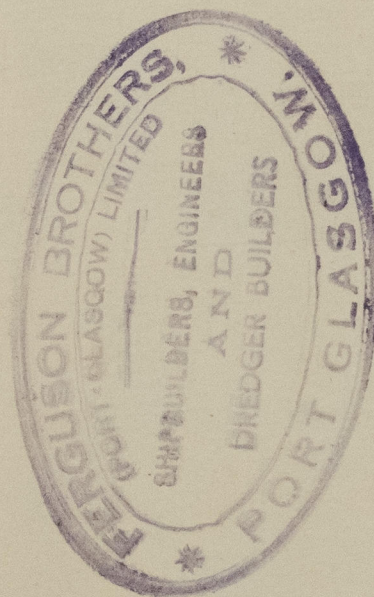

009667-009673-0180



© 2021

Lloyd's Register
Foundation