

**DIMENSIONS**

|                       |         |
|-----------------------|---------|
| LENGTH OVERALL        | 100'-0" |
| LENGTH BETWEEN PERPS  | 83'-0"  |
| BREADTH MOULDED       | 33'-3"  |
| DEPTH AT SIDE MOULDED | 25'-0"  |
| LOAD DRAFT ABOUT      | 25'-0"  |

2

APPROVED  
OFFICE OF THE  
NAVY  
NAVY DEPARTMENT  
WASHINGTON, D.C.

APPROVED  
NEW YORK  
JAN 10 1918

NOT SUBJECT TO APPROVAL OF  
NAVY DEPARTMENT  
SECTION IN ORDER TO FACILITATE  
SECURING MATERIAL

10000 TON OIL TANKER  
LLOYD'S REGISTER  
LLOYD'S REGISTER  
LLOYD'S REGISTER




PROFILE  
~~General Arrangement~~ & Decks.

S/S. Betterton Report No 4980

PLANS TRANSFERRED  
TO SISTER VESSEL

M/M. 9692

BIDWELL

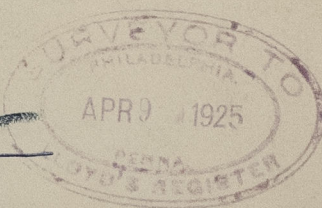

© 2021

<sup>84</sup>  
Lloyd's Register  
Foundation

009689-009696-0172