

VAN YLIET & CO
HARDINXVELD — HOLLAND

TO CLASS 100 A1. LLOYD

VAN VLIET & CO

HARDINXVELD — HOLLAND.

(1986) 24.11.09
28.12.09
3-2-10
19-4-10

RIVETS THRO' FRAMES & SHELL
IN AFTER PEAK SPACED 6 DIA.

✓ RIVETS IN LANDING EDGES FORMING FLAT OF BOTTOM
FOR $\frac{1}{2}$ OF $\frac{3}{16}$ L. SPACED 4 DIA: RIVETS IN
PLATING & FRAMES $5\frac{1}{2}$ DIA'S & FRAMES
DOUBLED FOR $\frac{1}{2}$ OF $\frac{3}{16}$ L & BOTTOM STRENGTHENED
AS PER RULES, RIVETS THRO' FRAMES
& SHELL IN PEAK TANK SPACED
6 DIA. C. TO C.

27
24 11/109
28 12/10



009710-



0024 Lloyd's Register Foundation

No. 22.
No. 86

Sister Vessel.



4
London Queen
Rotterdam report no 2. 6855
S.S. no. 82.
Profile and Deck plan.
S.S. no. 86 report = 7107

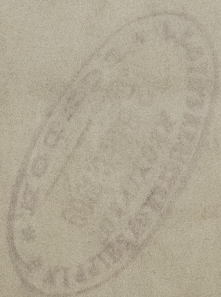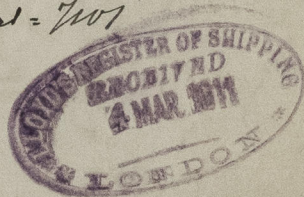

© 2020

Lloyd's Register
Foundation

0097102-009710-0024