

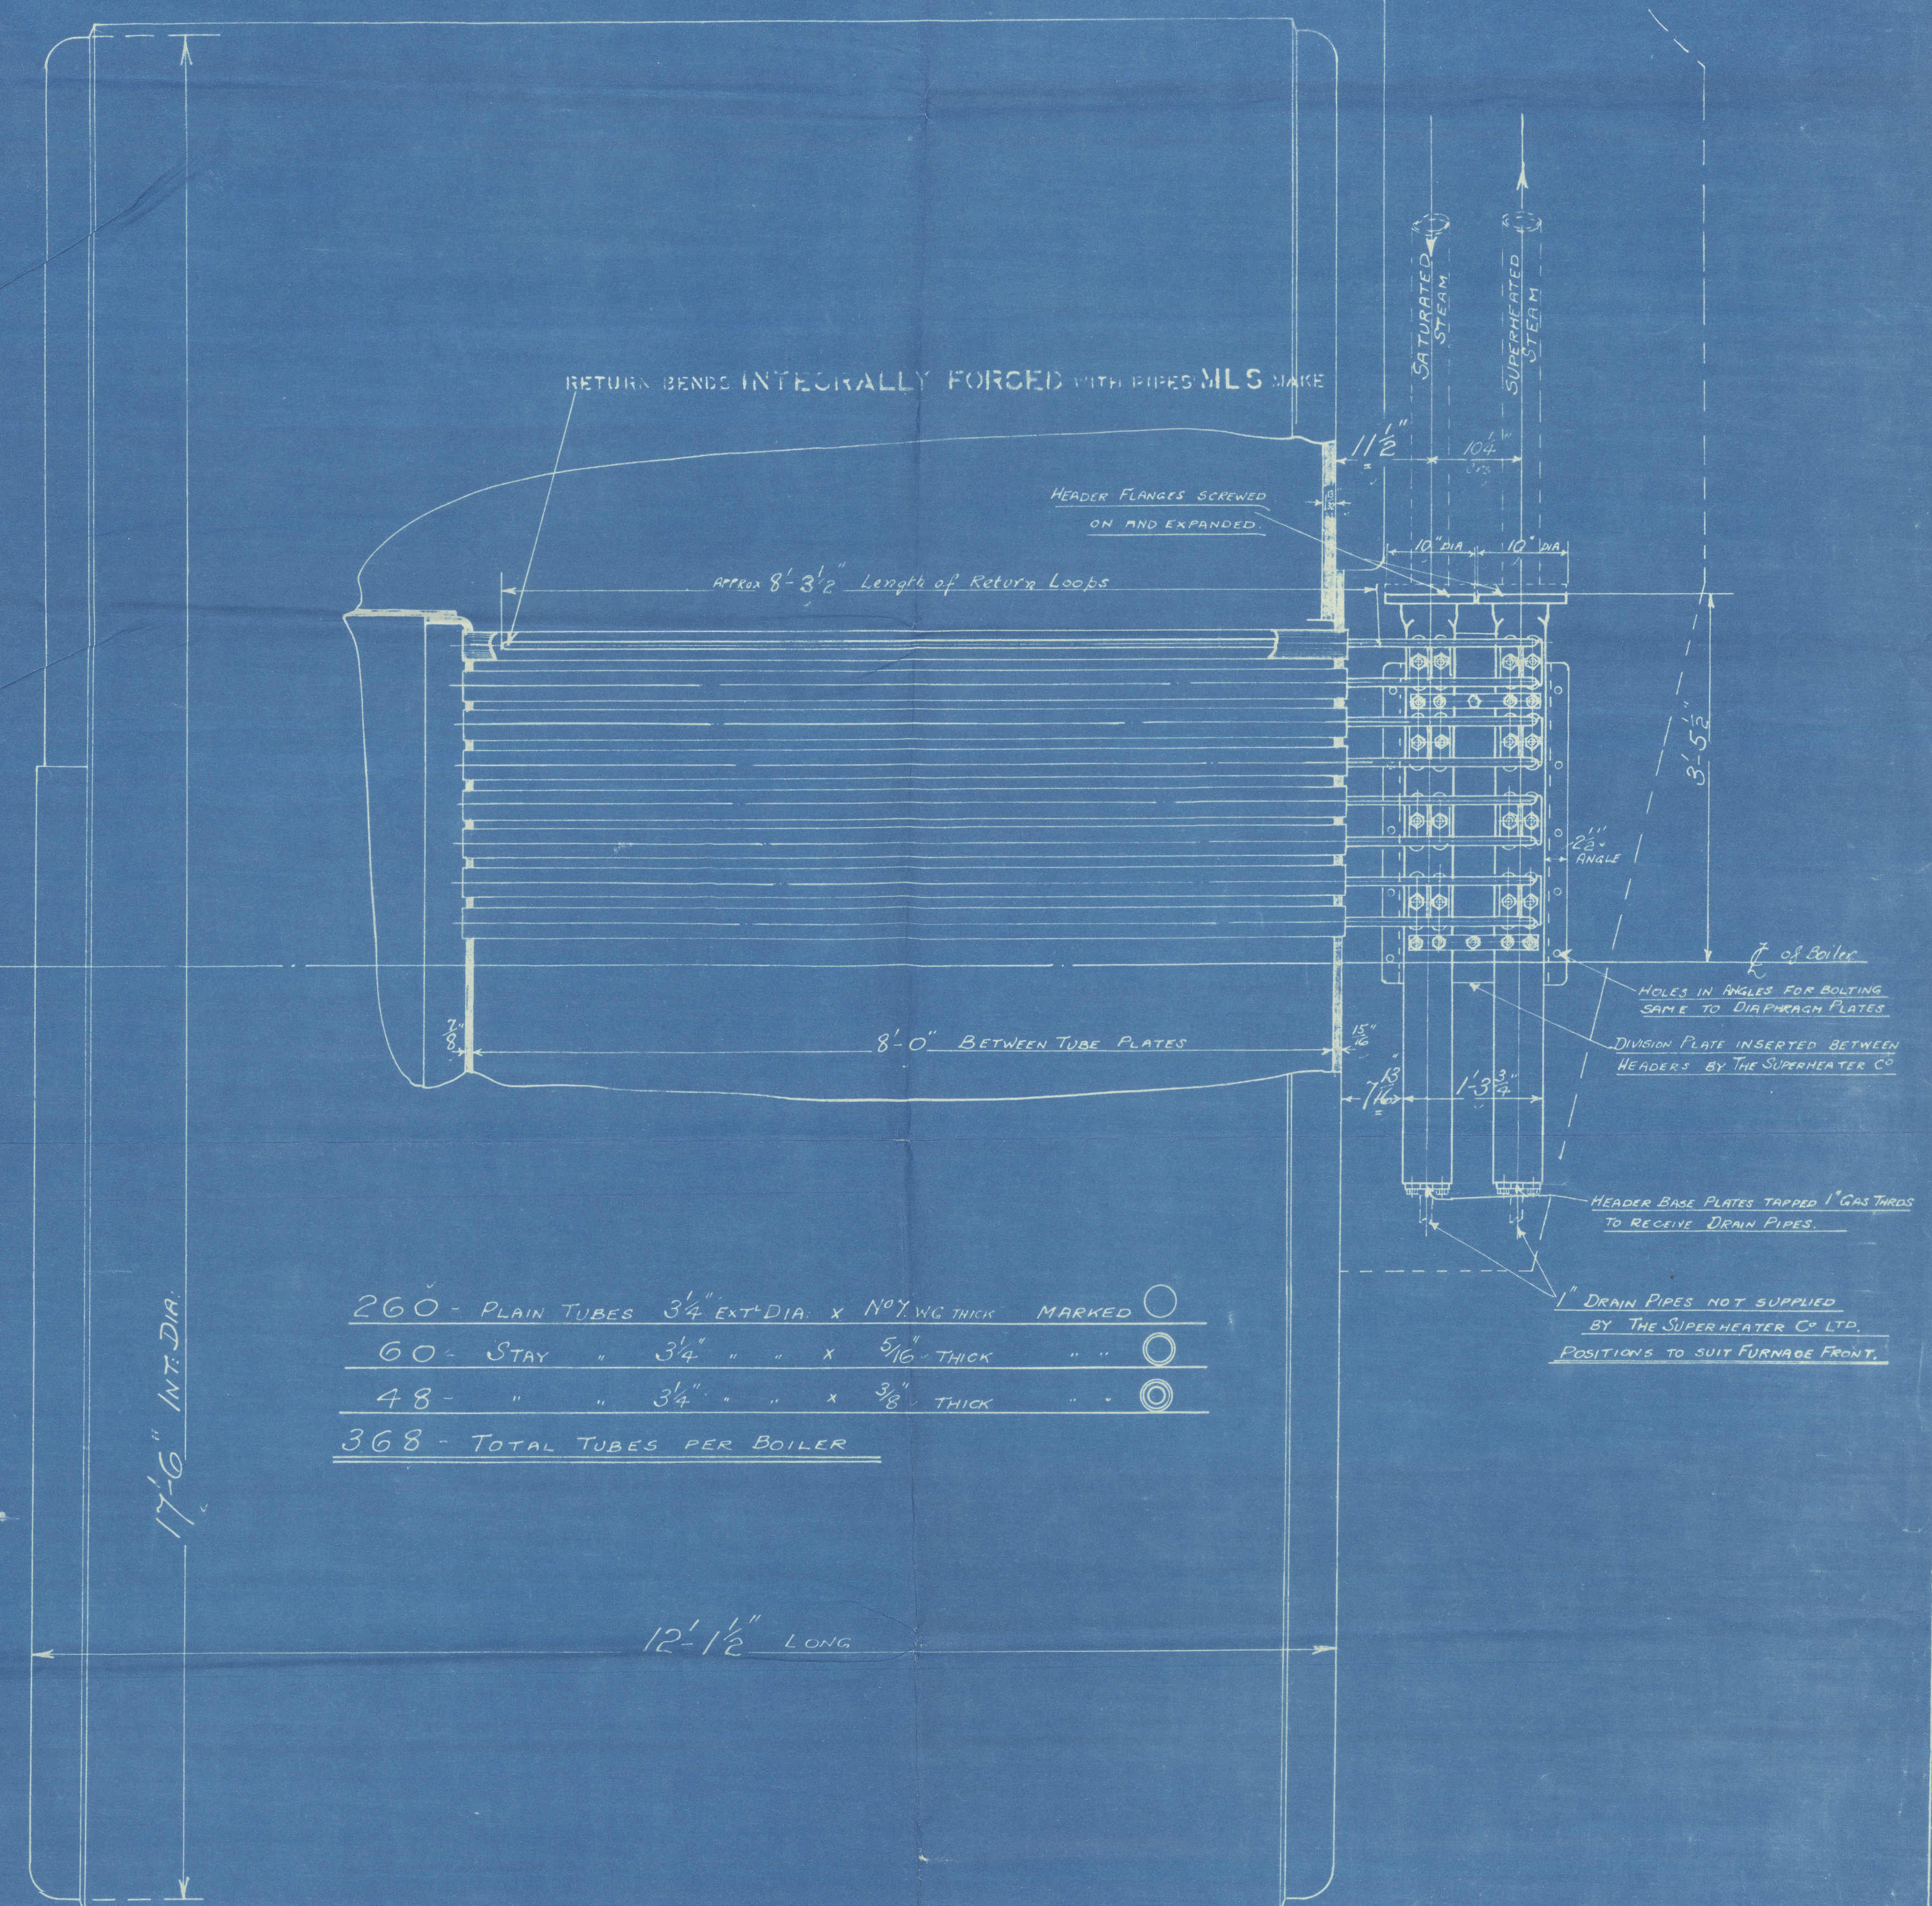


12/3/29

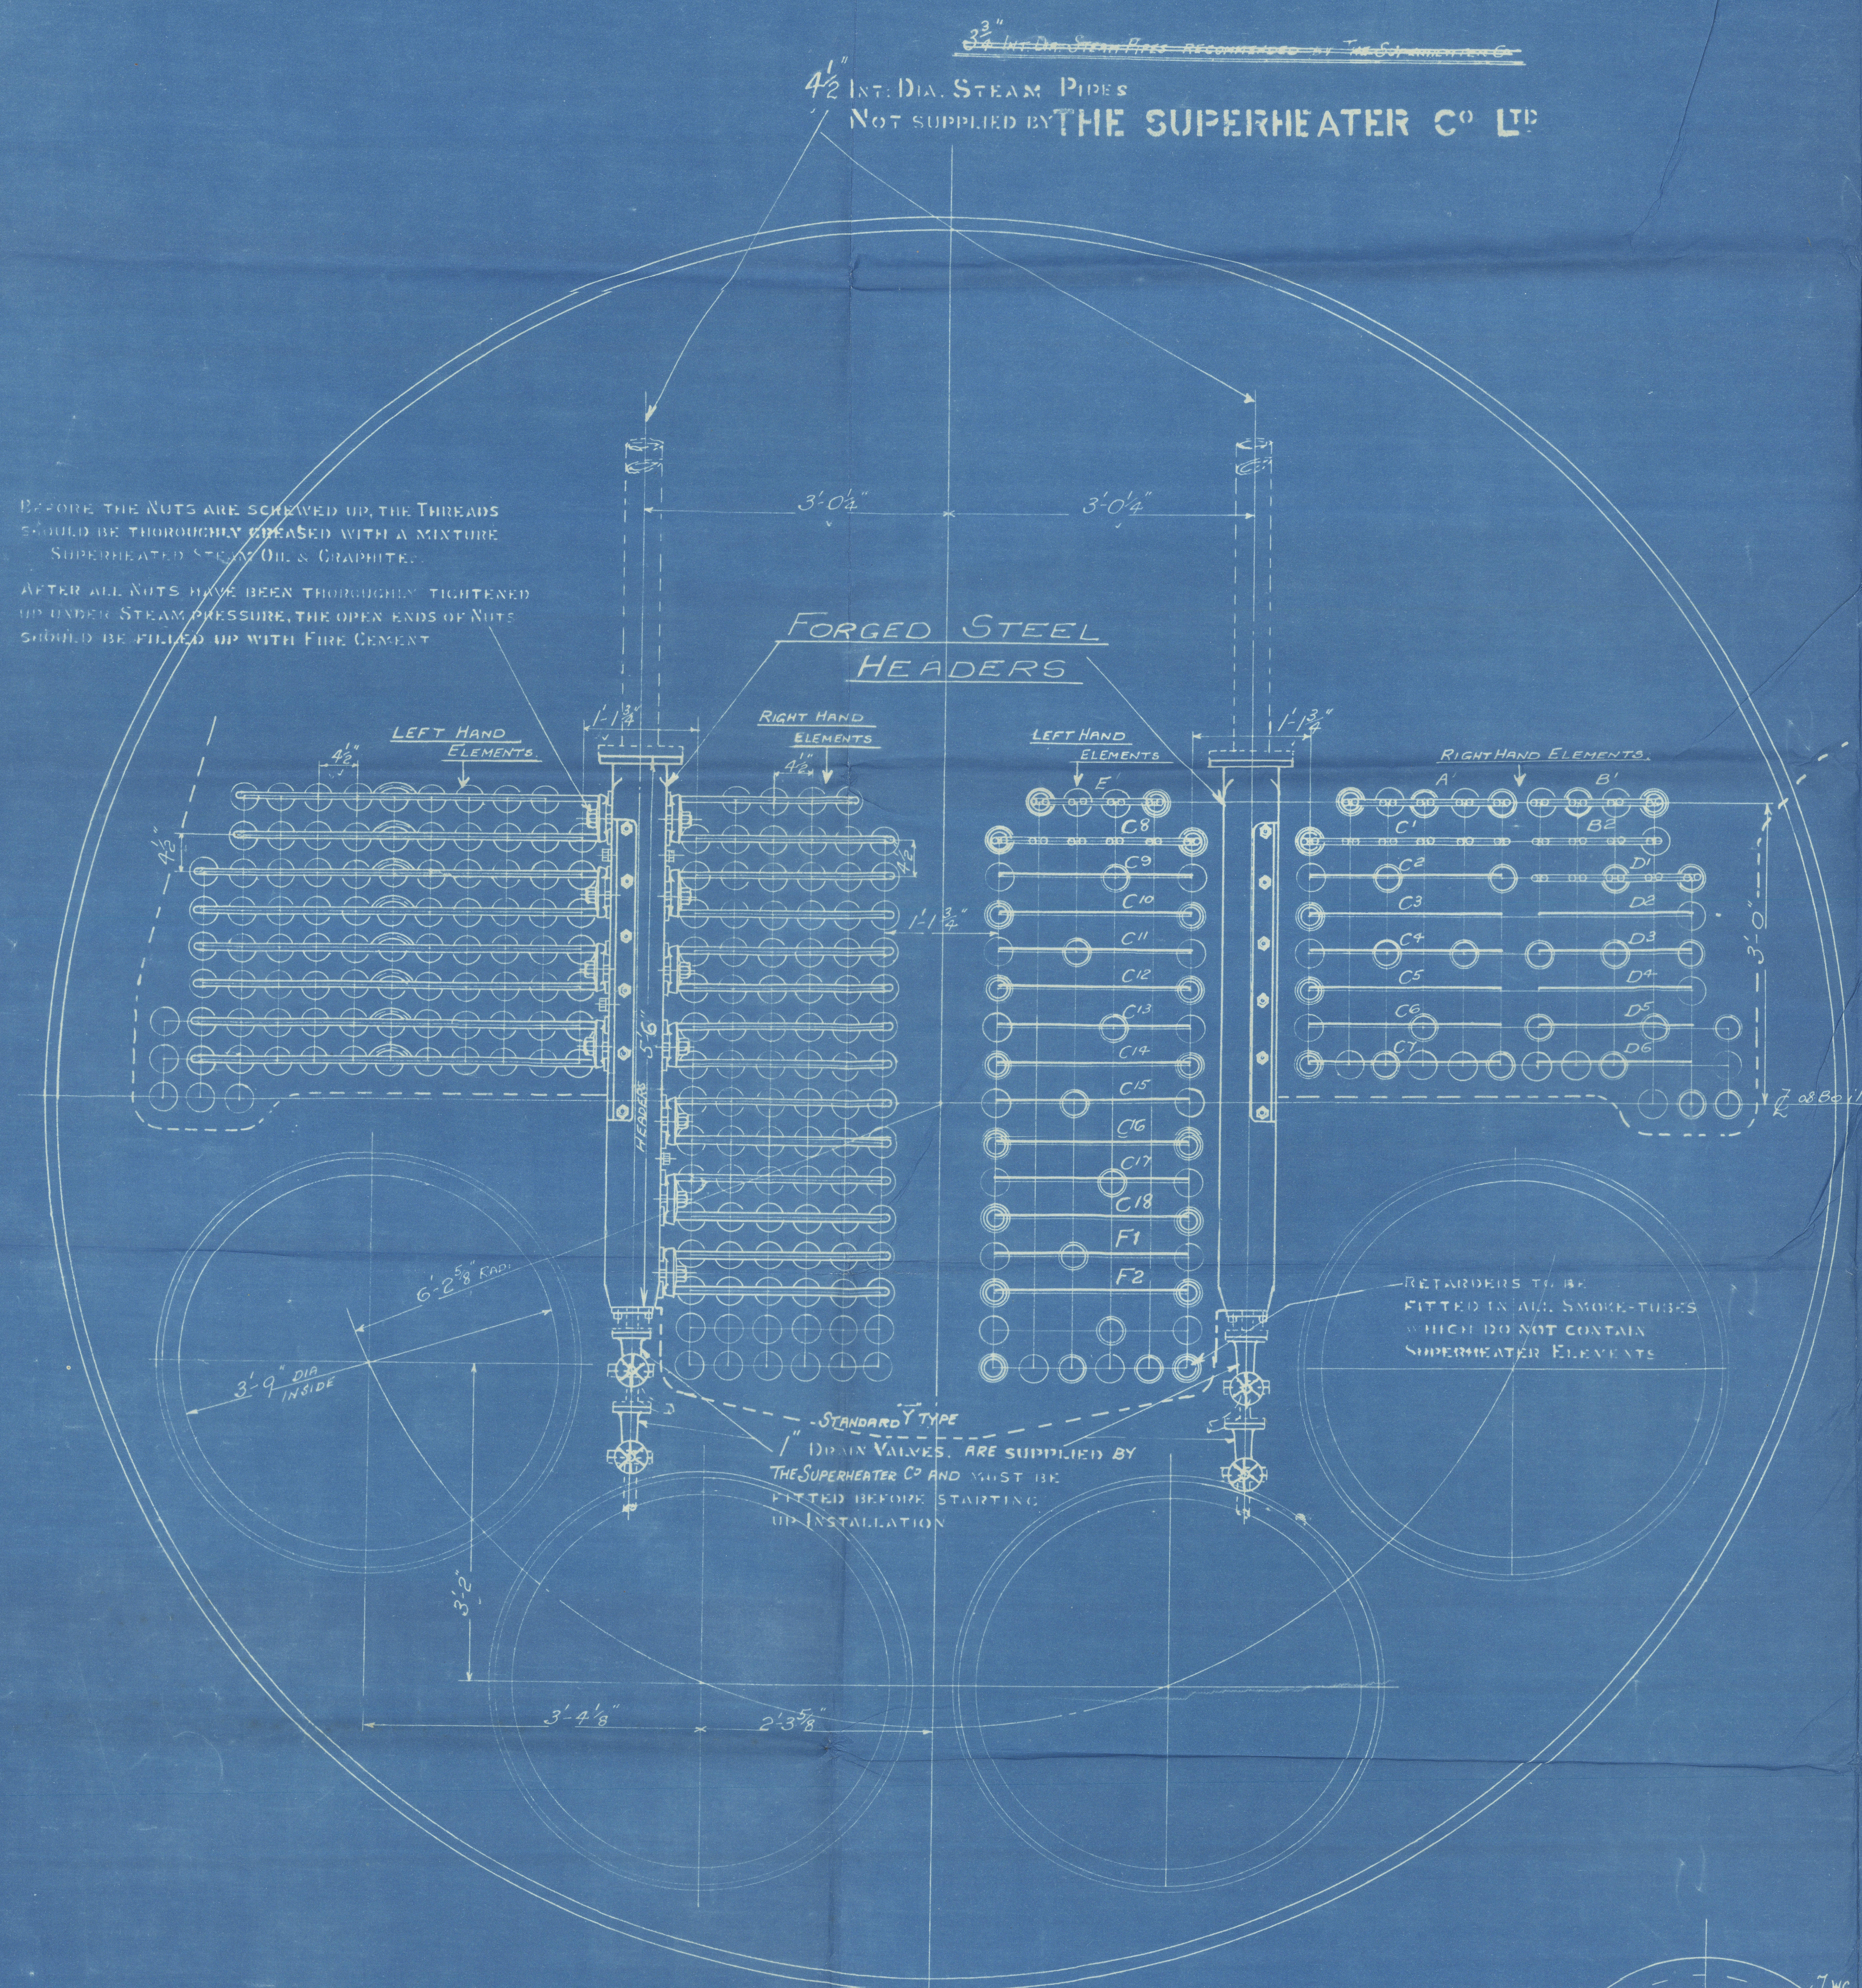

260 - PLAIN TUBES	3 1/4" EXT. DIA. X 1/4" WG THICK	MARKED	○
60 - STAY	3 1/4" " " X 5/16" THICK	" "	○
48 - " "	3 1/4" " " X 3/8" THICK	" "	○
368 - TOTAL TUBES PER BOILER			

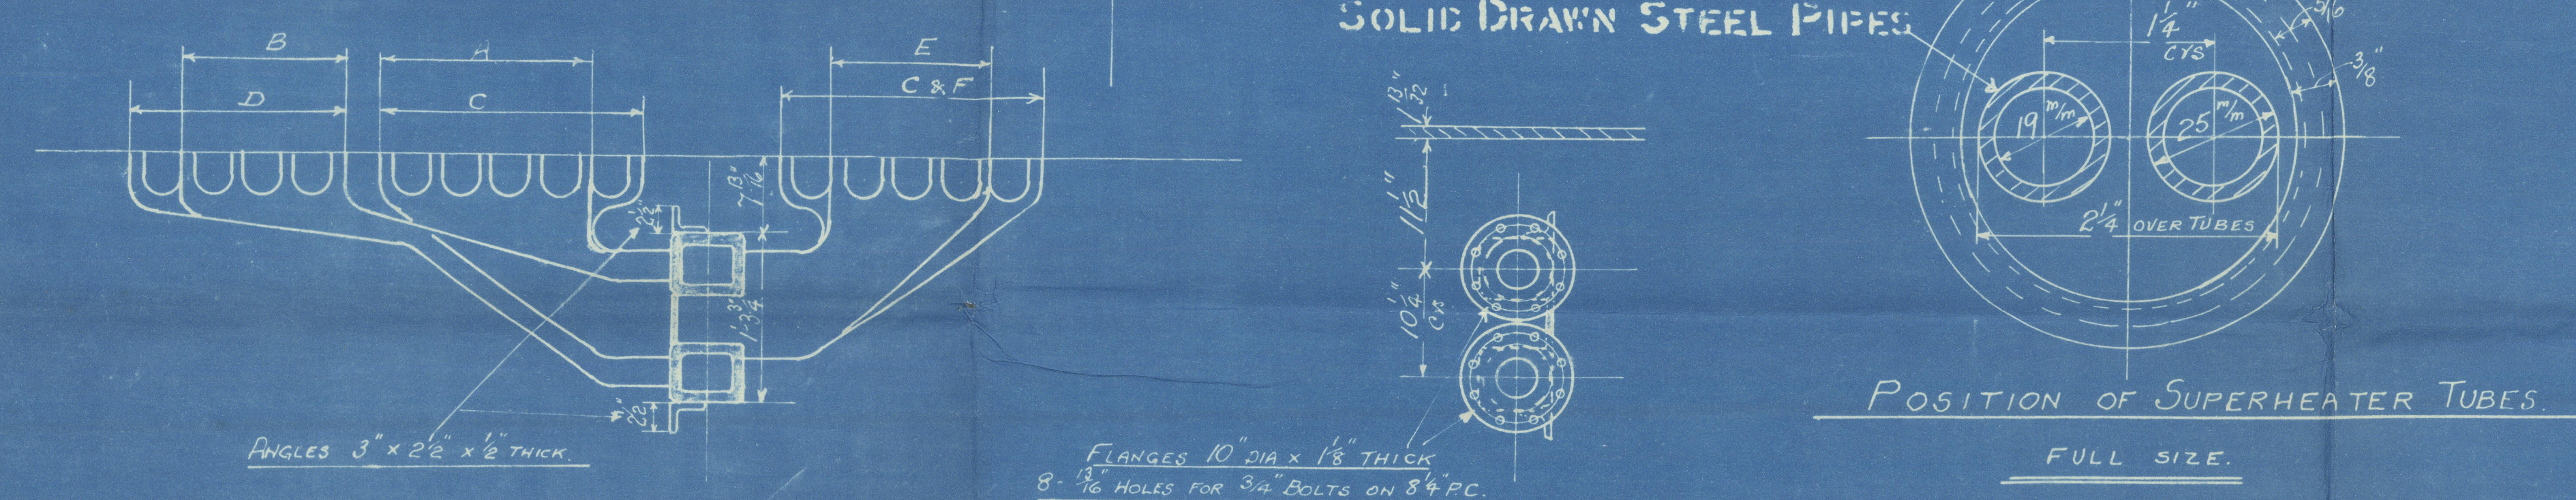

NUMBER OF SHIPS	ONE
NUMBER OF BOILERS	2 PER SHIP (COAL FIRED) N.D. (FORCED DRAUGHT)
WORKING PRESSURE	220 LBS PER SQ. IN. PER BOILER
GRATE AREA	=
HEATING SURFACE	= 3126 sq. ft. = 6252 sq. ft.
SUPERHEATED SURFACE	= 1500 sq. ft. = 3000 sq. ft.

THE SUPERHEATER CO LTD	
195 STRAND LONDON W.C 2	
TITLE ARRANGEMENT OF SUPERHEATER "S" TYPE	
REF. NO.	DRAWING NO.
3115	MN 4980

10 PASS LLOYDS SURVEY

TEST PRESSURE 660 LBS PER SQ. IN.

JOHN DICKINSON & SONS LTD

ENGINE NO. 900.

© 2020 Lloyd's Register Foundation

SCALE 1" = ONE FOOT

DRAWN BY TCD:JWS

19/2/29

THE DESIGN SHOWN ON THIS DRAWING IS PROTECTED BY PATENTS OWNED AND CONTROLLED BY THE SUPERHEATER CO LTD

Superheater Co. Ltd.

J. Dickinson & Sons

Cont. No. 900

Barham's Ship 267

General Agent

Mar Tesso

ex

S/S "Rajasthan"

© 2020

BUNDERLAND

RPT. No.

30186

Lloyd's Register
Foundation

009702-009710-0228