
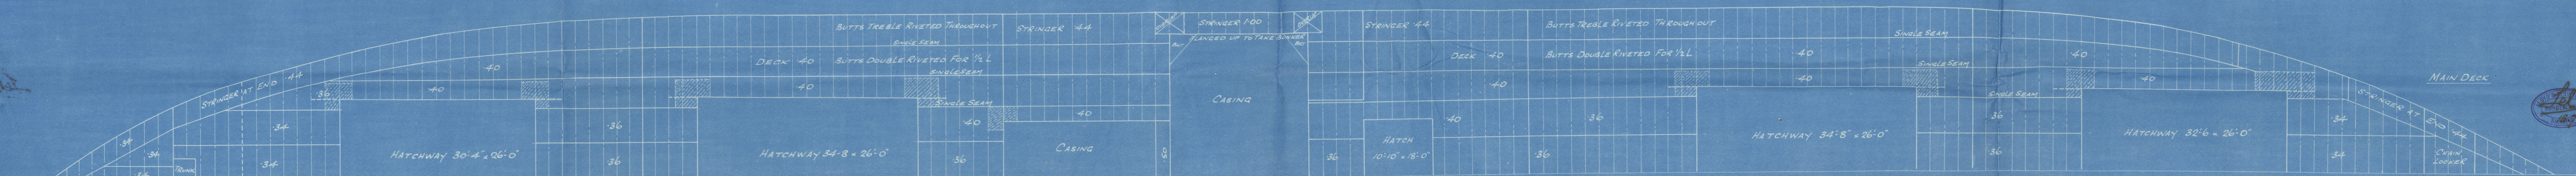
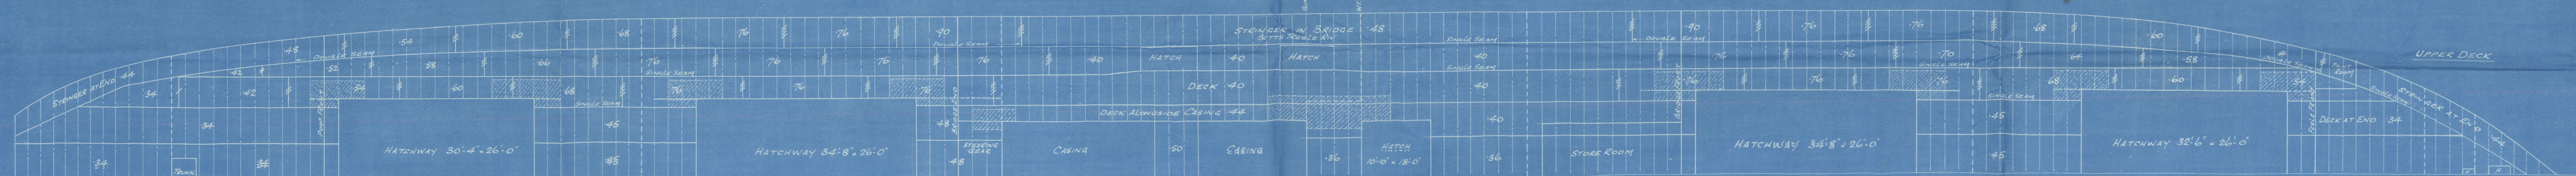
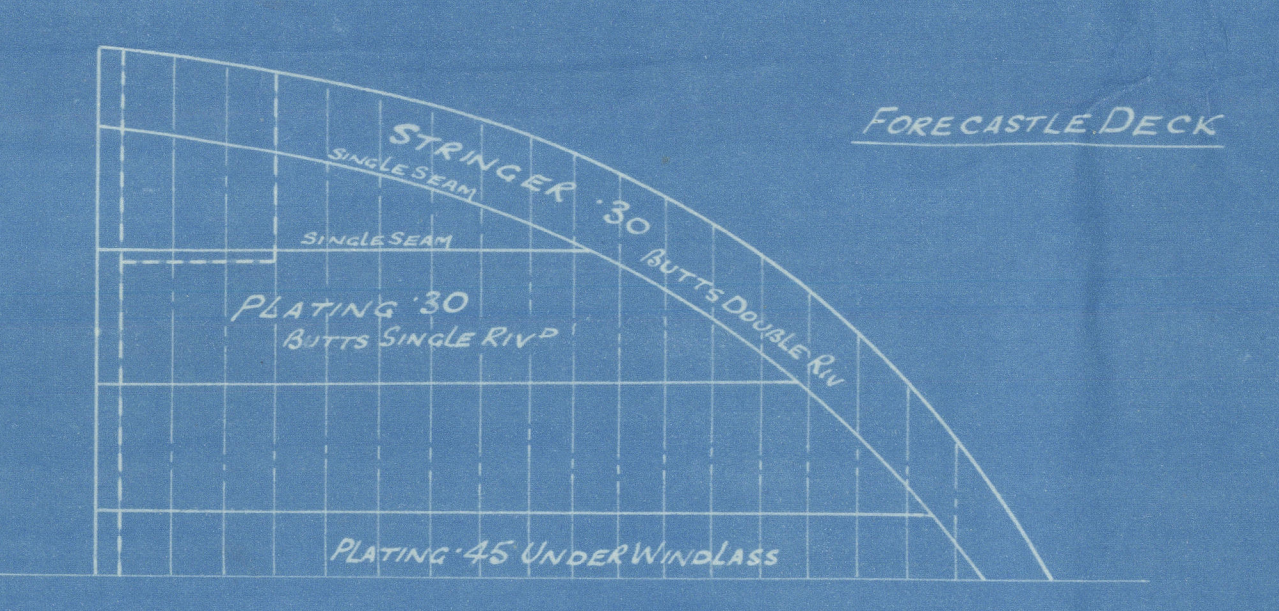
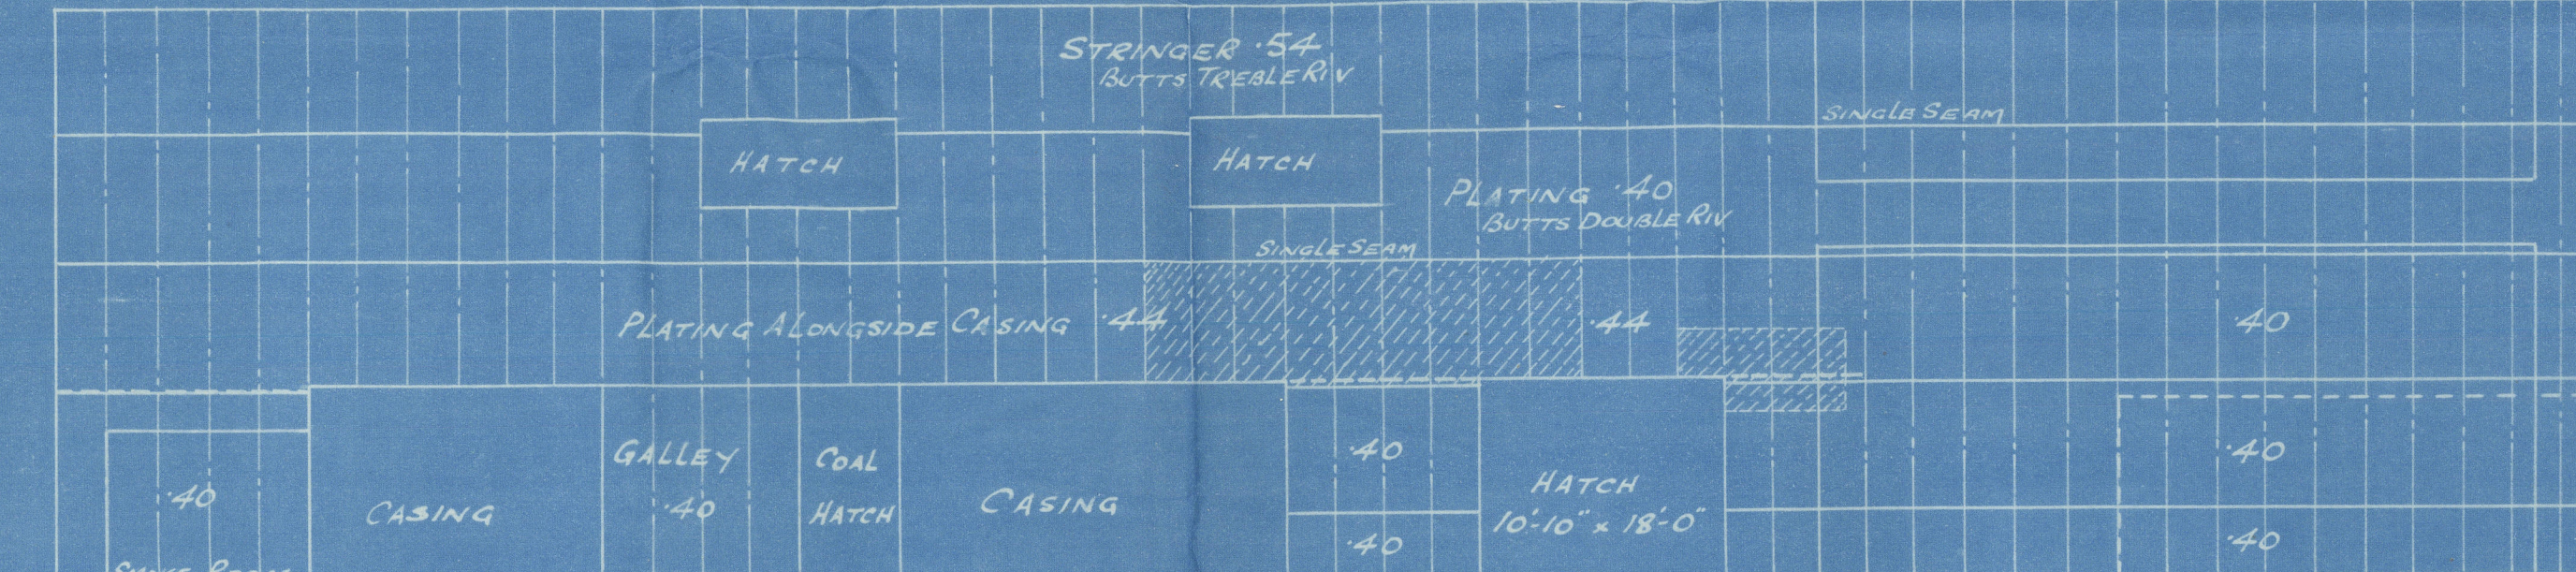
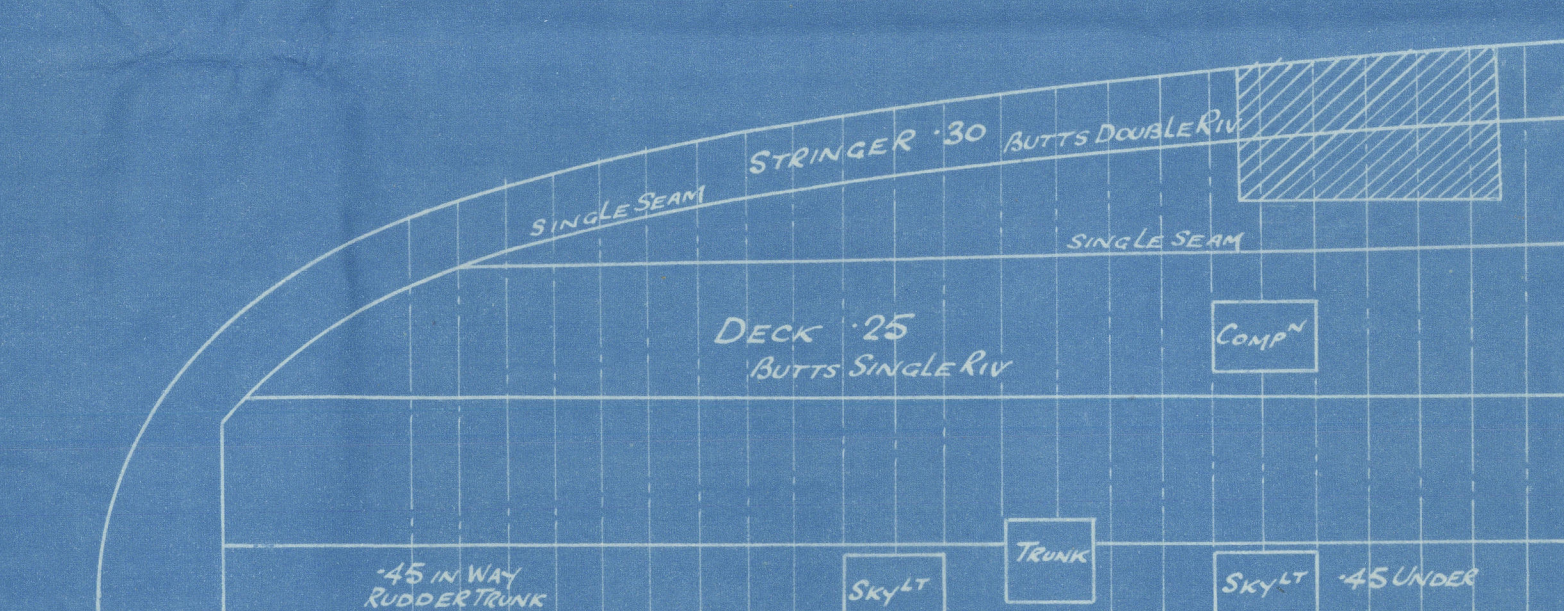


PROFILE & DECK PLANS.

S.S. WAR SPANIEL.

DIM^s 400' BP x 52' ML^o x 31' ML^o

SCALE 1/8" = 1 FOOT.

 

PLAN No

No 399

for SHORT BROTHERS LTD
 SUNDERLAND.
 Edgar Woodward
 1918
 Lloyd's Register
 Foundation

SUNDERLAND

Messrs Short Brothers

Profile & Deck Plans


(as built)

No 399

P.S. "WAR SHANIEL"

SUNDERLAND RPT. No. 27288

"H" HOKKO MARU

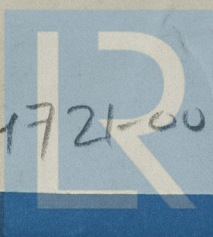

© 2021

004721-00 9724-0041

Lloyd's Register
Foundation