


61608/4
RUDDER FRAME.

SCALE 1 INCH = 1 FOOT.

MAINPIECE TO BE ROLLED MILD STEEL

ARMS TO BE FORGED IRON.

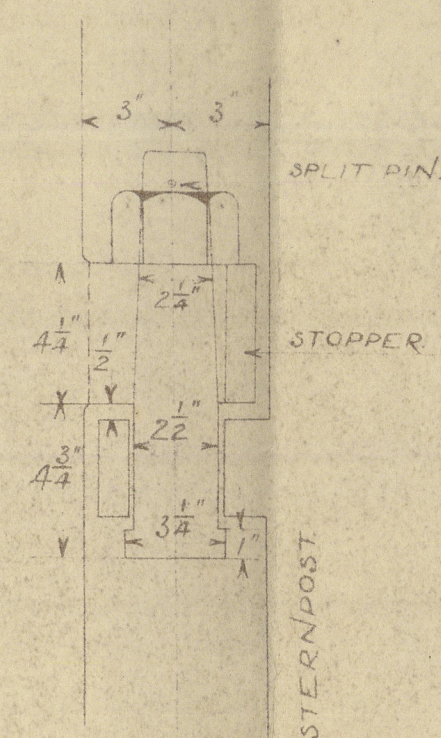

TOP PINTLE (ONE OFF.)

3" x 3"

SPLIT PIN

1 1/4"

2 3/4"

2 1/2"

5 1/2"

1 1/4" metal


(TWO OFF.)

[illegible]

BOTTOM PINTLE (ONE OFF.)



[illegible]

ARMS SHRUNK ON AND KEYED.






13. 11. 16

Hall Russell & Byrd.

Nos. ~~604~~ & 5. 608 & 9.

Rudder frame.

608.
604 / S.S. "William Browning"

Atk I.C. Rep No. 11964.

609.
605 / S.S. "Richard Bennett"

Atk I.C. Rep No. 11965.

009730-009742-0017

Rudder frame.



© 2021

Lloyd's Register
Foundation