

APPROVED

LOYDS REGISTER OF SHIPPING

DEC 18 1919

NEW YORK

PORTARITISSA  
M/M. 9752



MERCHANT SHIPBUILDING CORPORATION  
CHESTER YARD

DEC 13 1919

LIBRARY


ISSUED TO

© 2021  
009743-009756-0262



Lloyd's Register  
Foundation



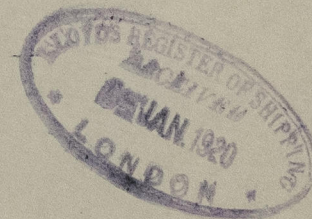

009743-009756-0262

© 2021



Foundation