



N<sup>o</sup> 113

## FRAMING PROFILE

SCALE 1/4 INCH = 1 FOOT.

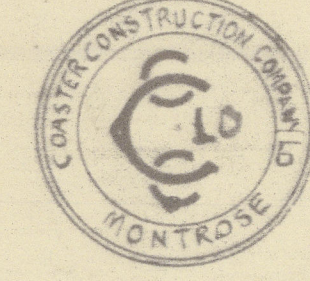

62/23  
Wm

 

NGO - This plan has been endorsed only for arrangement of W.T. Bulkheads

APPROVED

LLOYDS REGISTER OF SHIPPING

© 2021

Lloyd's Register

009757-009770-0011