

For the information of Surveyors and the Committee only. MUN. 8-10-18

Received at

HULL,

Office,

31st. July, 1916

# Lloyd's Register of Shipping.

(Report on Vessel No. 30,452. Port Hull)  
S.S. "Shama".

No.

## SHIP FORGINGS OR CASTINGS.

I have to report that the undermentioned Iron or ~~Steel~~ Forgings or Castings, manufactured by M<sup>rs</sup> J. S. Forster & Sons Ltd of Sunderland for the Vessel No. 183, being built by Goole S.B. & Repairing Co. Ltd Goole have been inspected by me as set forth below and found to be, so far as can be seen, Sound

Work on Forgings or Castings.

Lloyd's


No. 7375

D. D. Williamson

Sunderland 28-7-16

	STERN FRAME.	RUDDER FRAME.	STEM.
Material* ...	Scrap Iron	Scrap Iron	
Dimensions ...	6" x 2 1/2"	4 1/2" dia to 4 1/2" x 4 1/2"	
Progress on Inspection ...	Forged & Finished	Forged & Finished	
Time when Inspected	2-10-15 to 18-11-16	18-11-15 to 28-7-16	
CASTINGS.			
Tests on Standard Test Pieces.			
Tensile Test—			
Tons per square inch			
Extension per cent. ...			
Cold Bending Test—			
Angle before fracture			
Drop Test—			
Height from ground ...			
Hammering Test—			
If made according to Rules and found satisfactory			

SKETCHES OF FRAMES SHOWING POSITION AND DESCRIPTION OF WELDS OF FORGINGS.

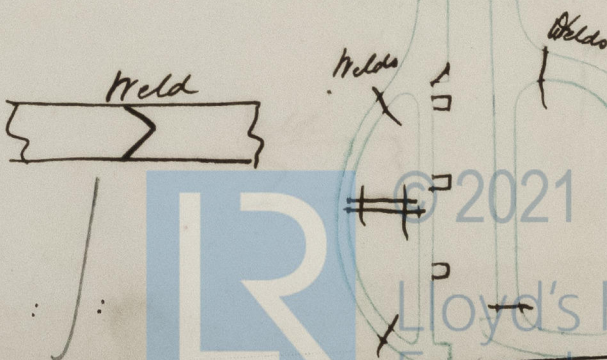

Fee (if any chargeable) £

To be paid at

\* If of Iron, state whether scrap or puddled Iron. If of steel, state whether made on the Open Hearth process.