

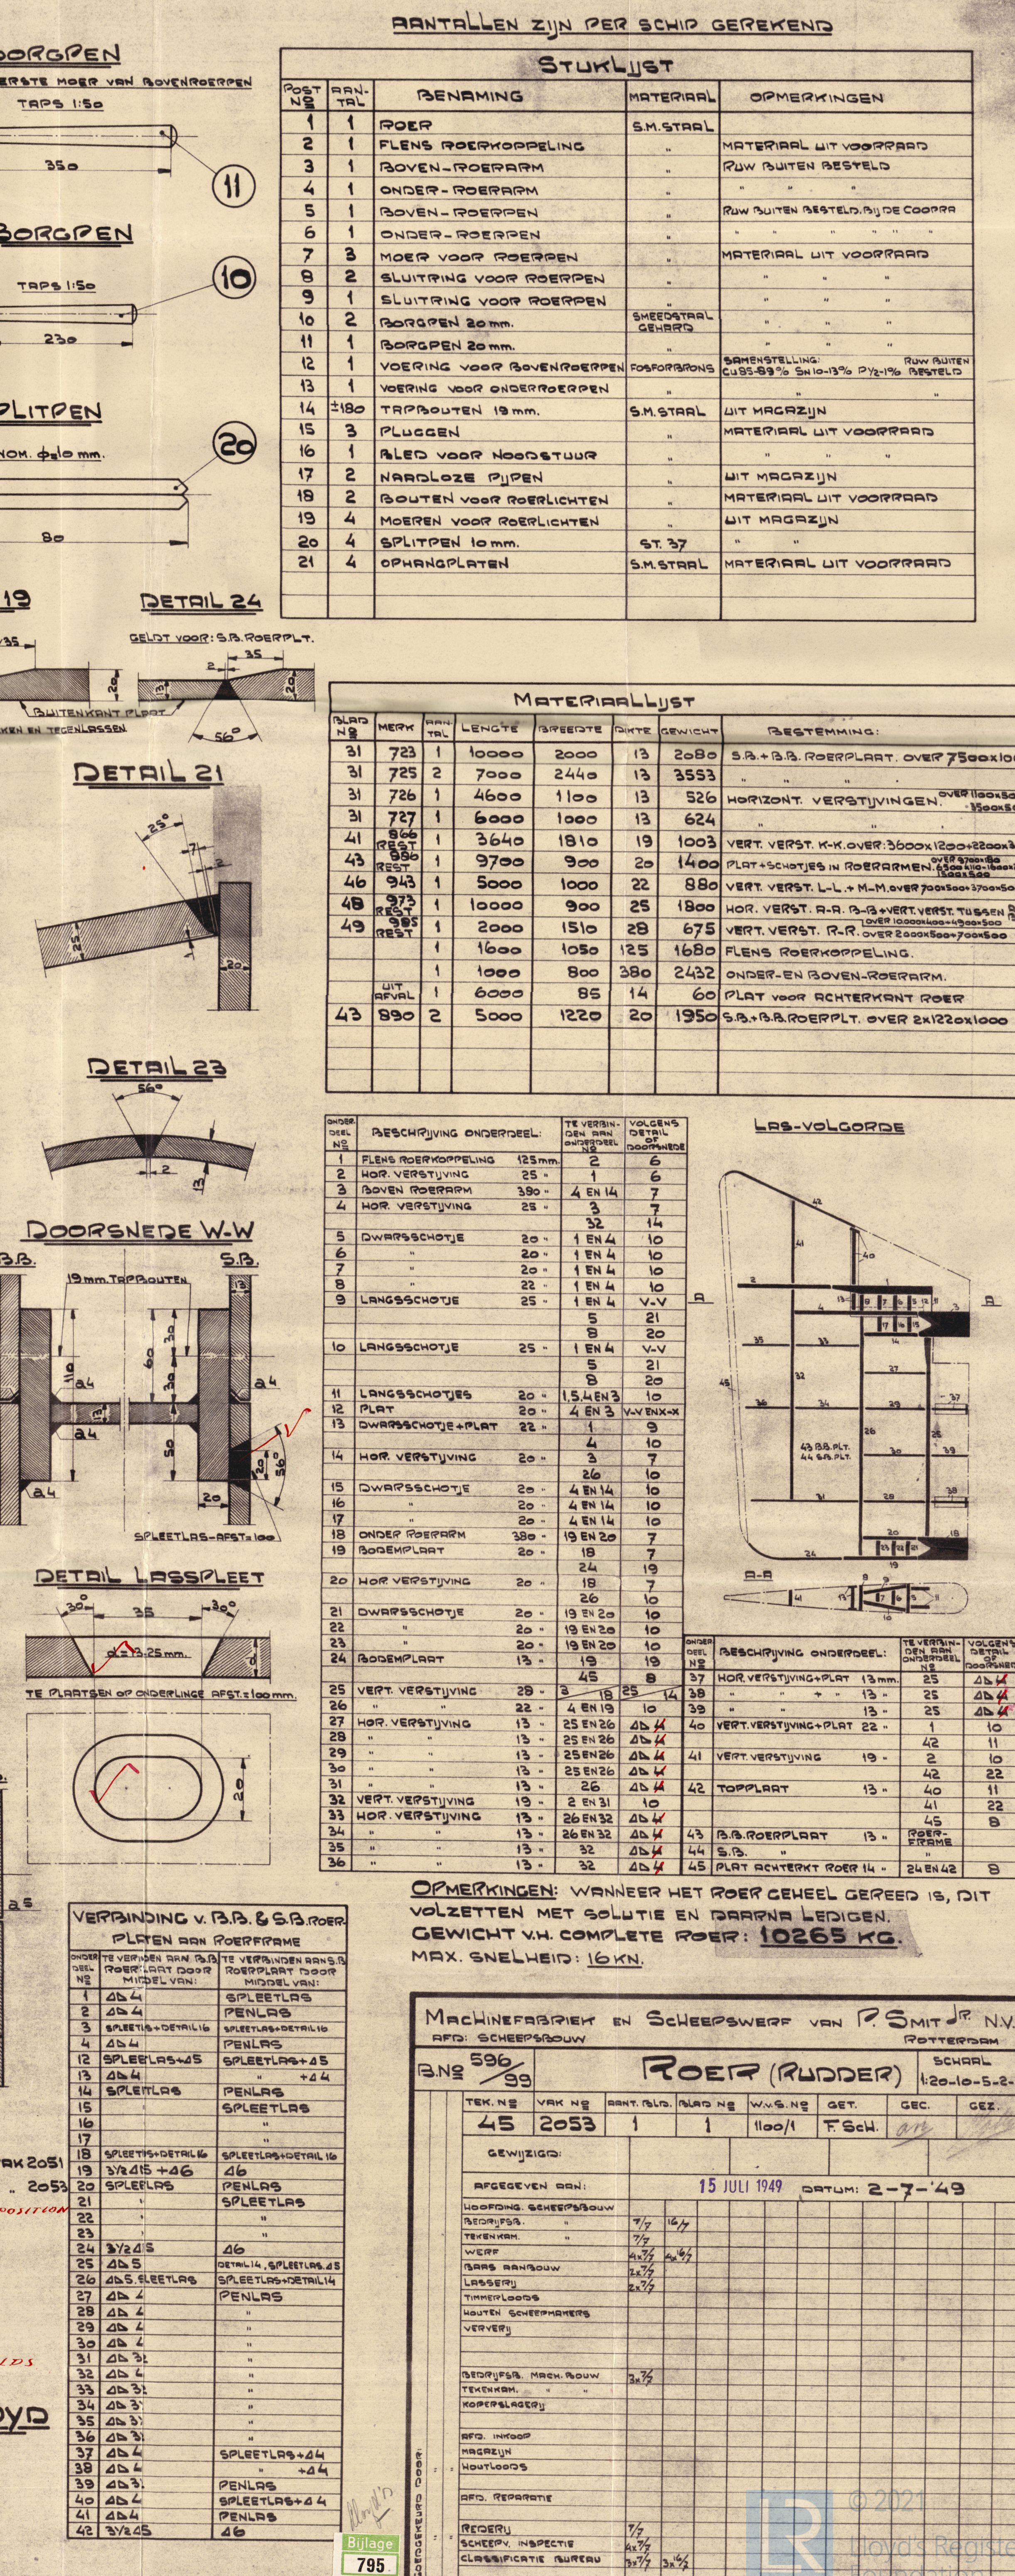
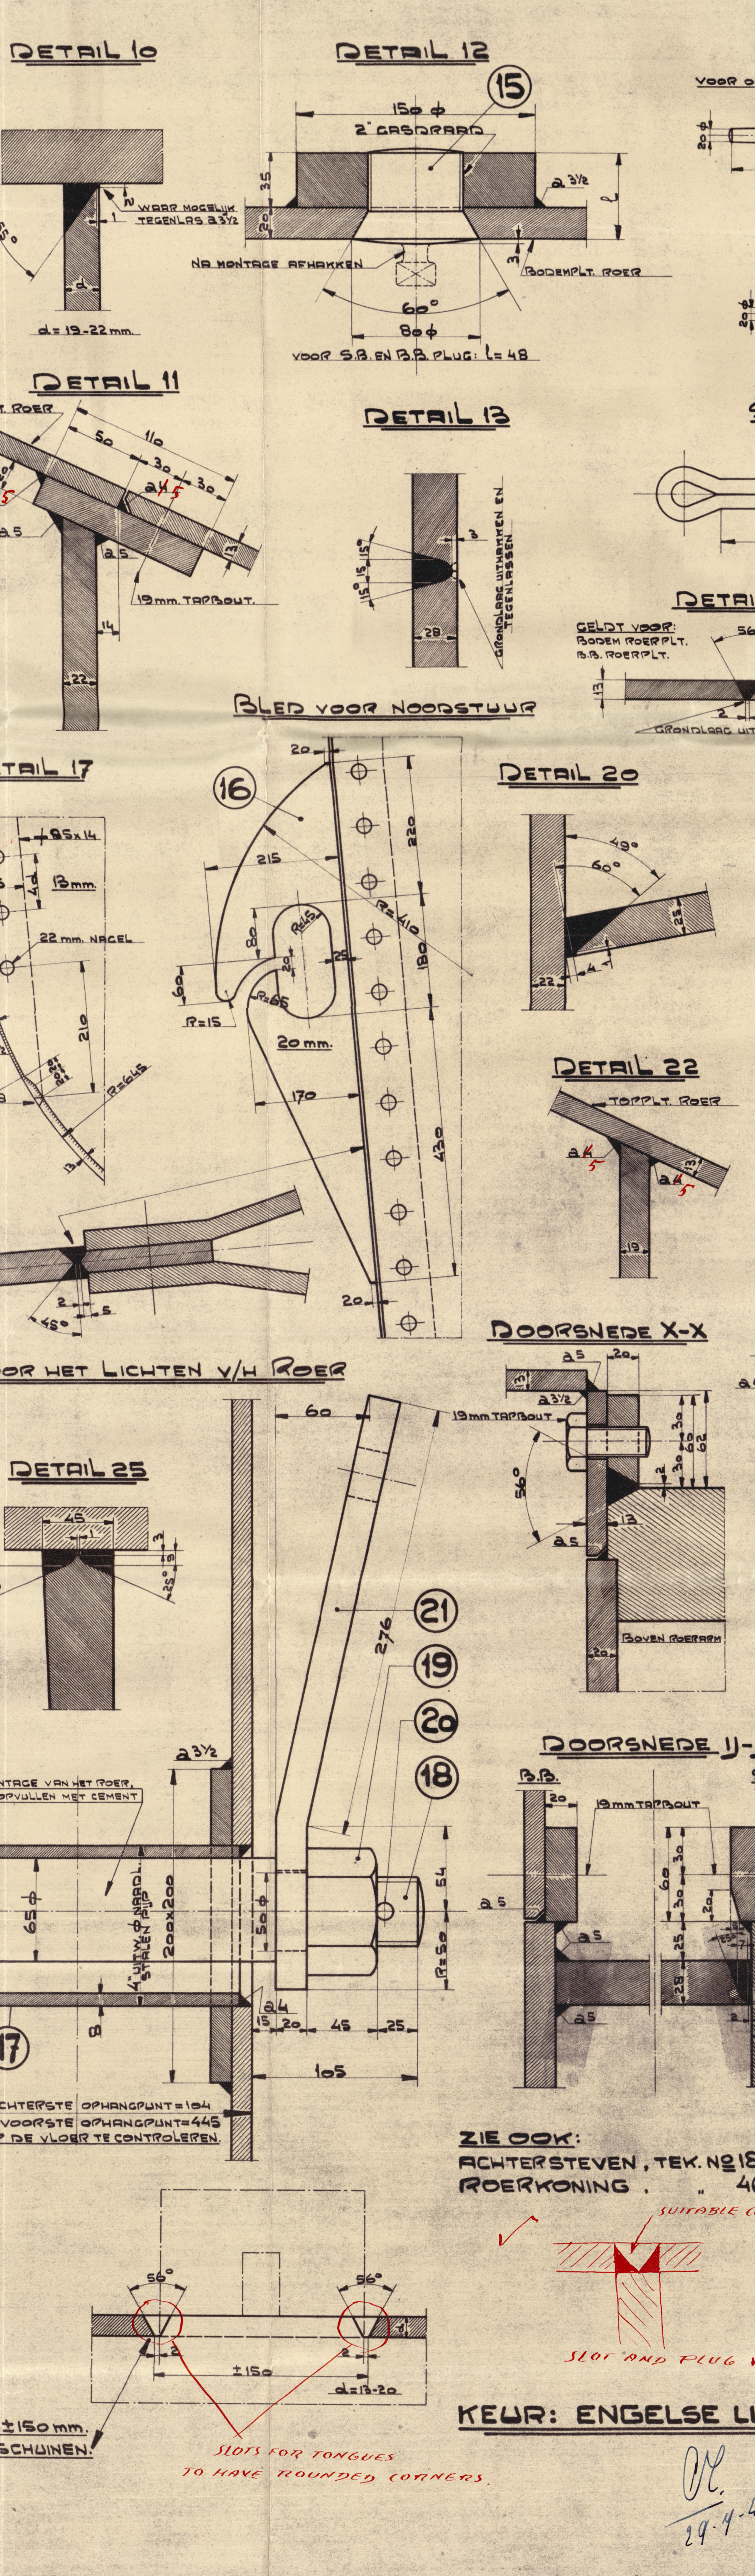
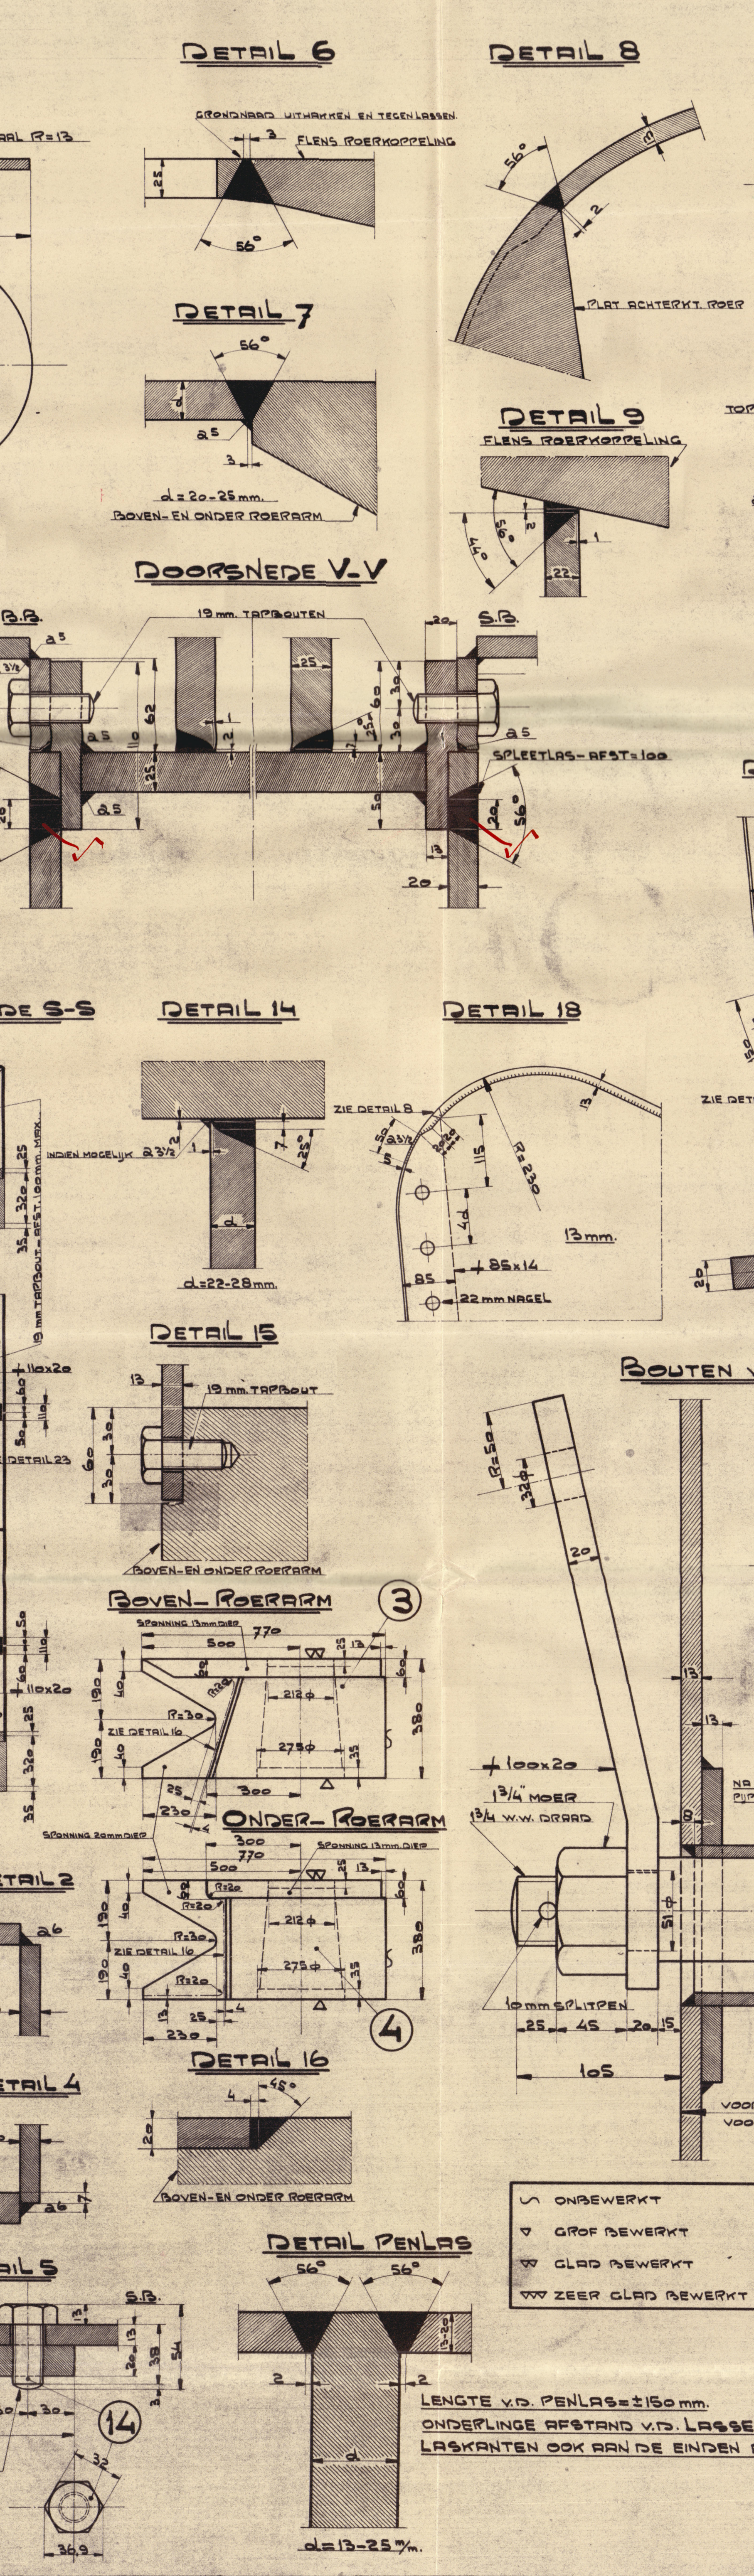
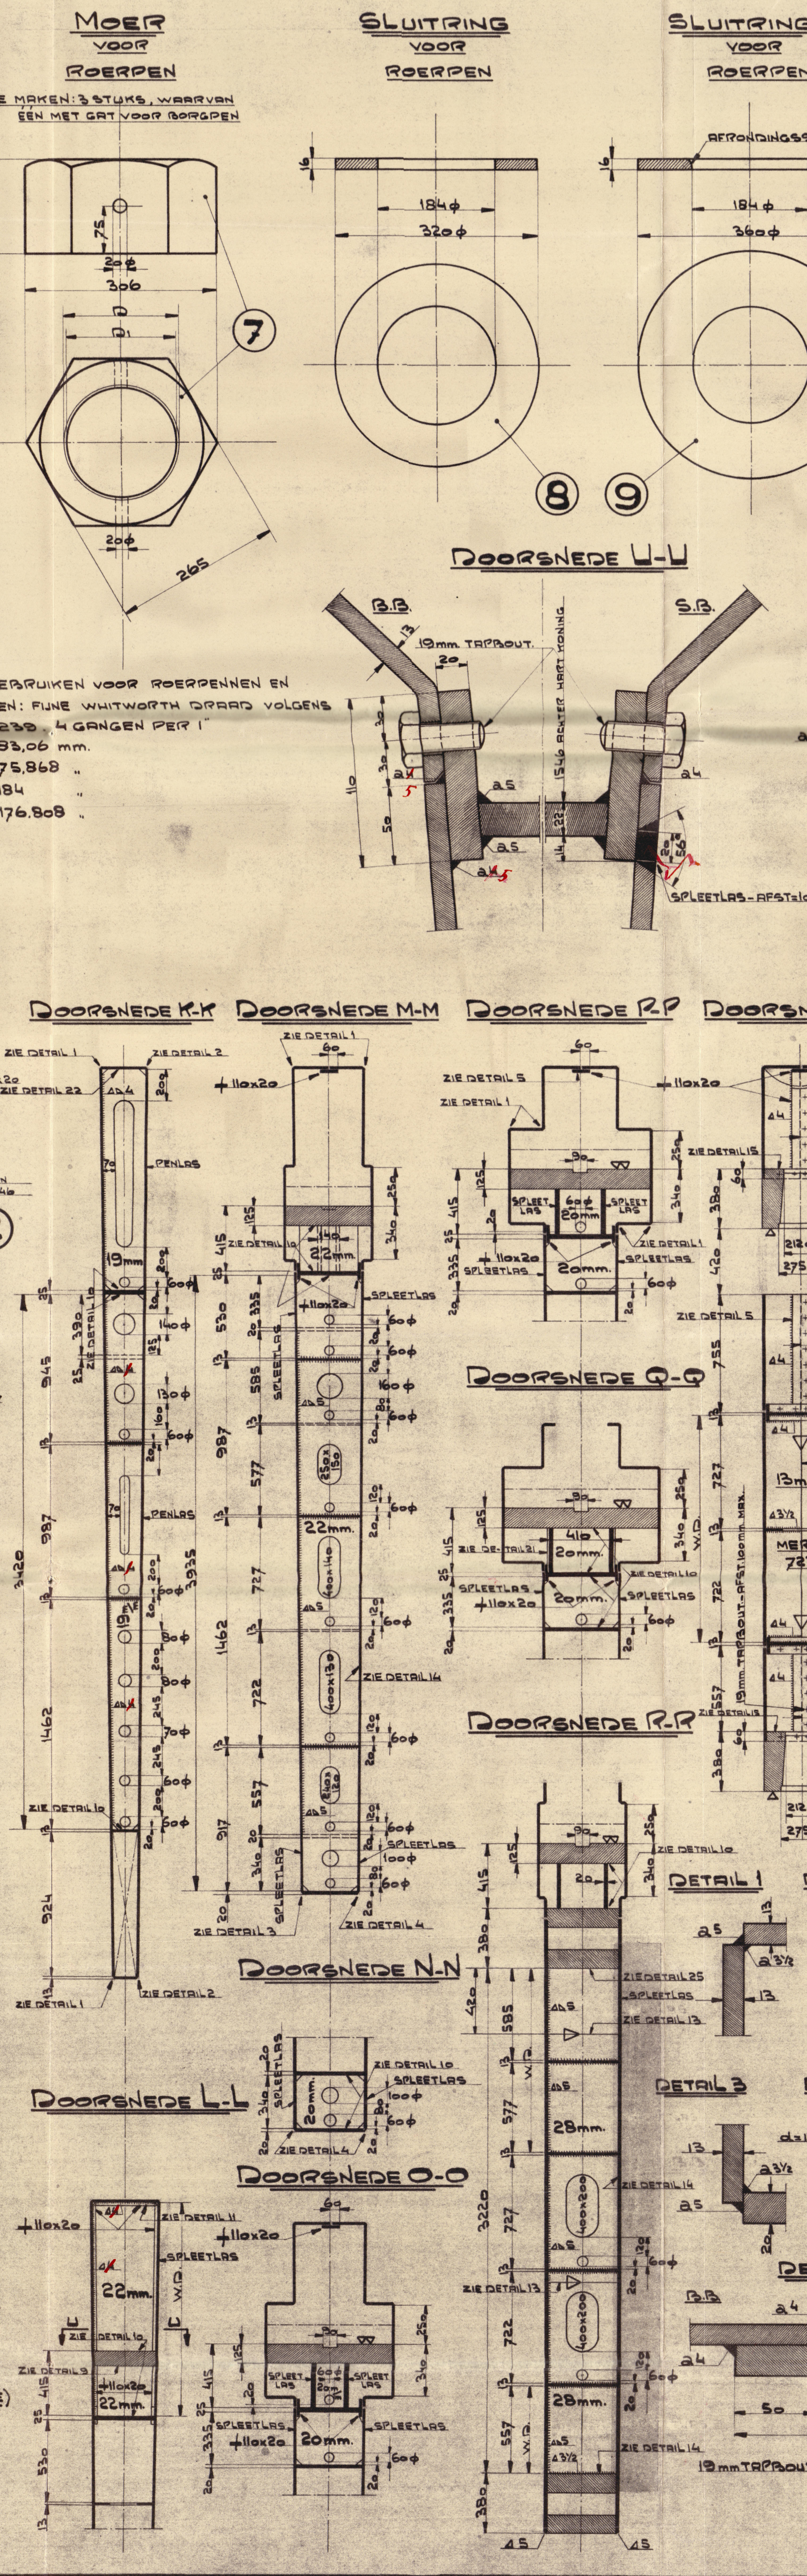


29.4.49

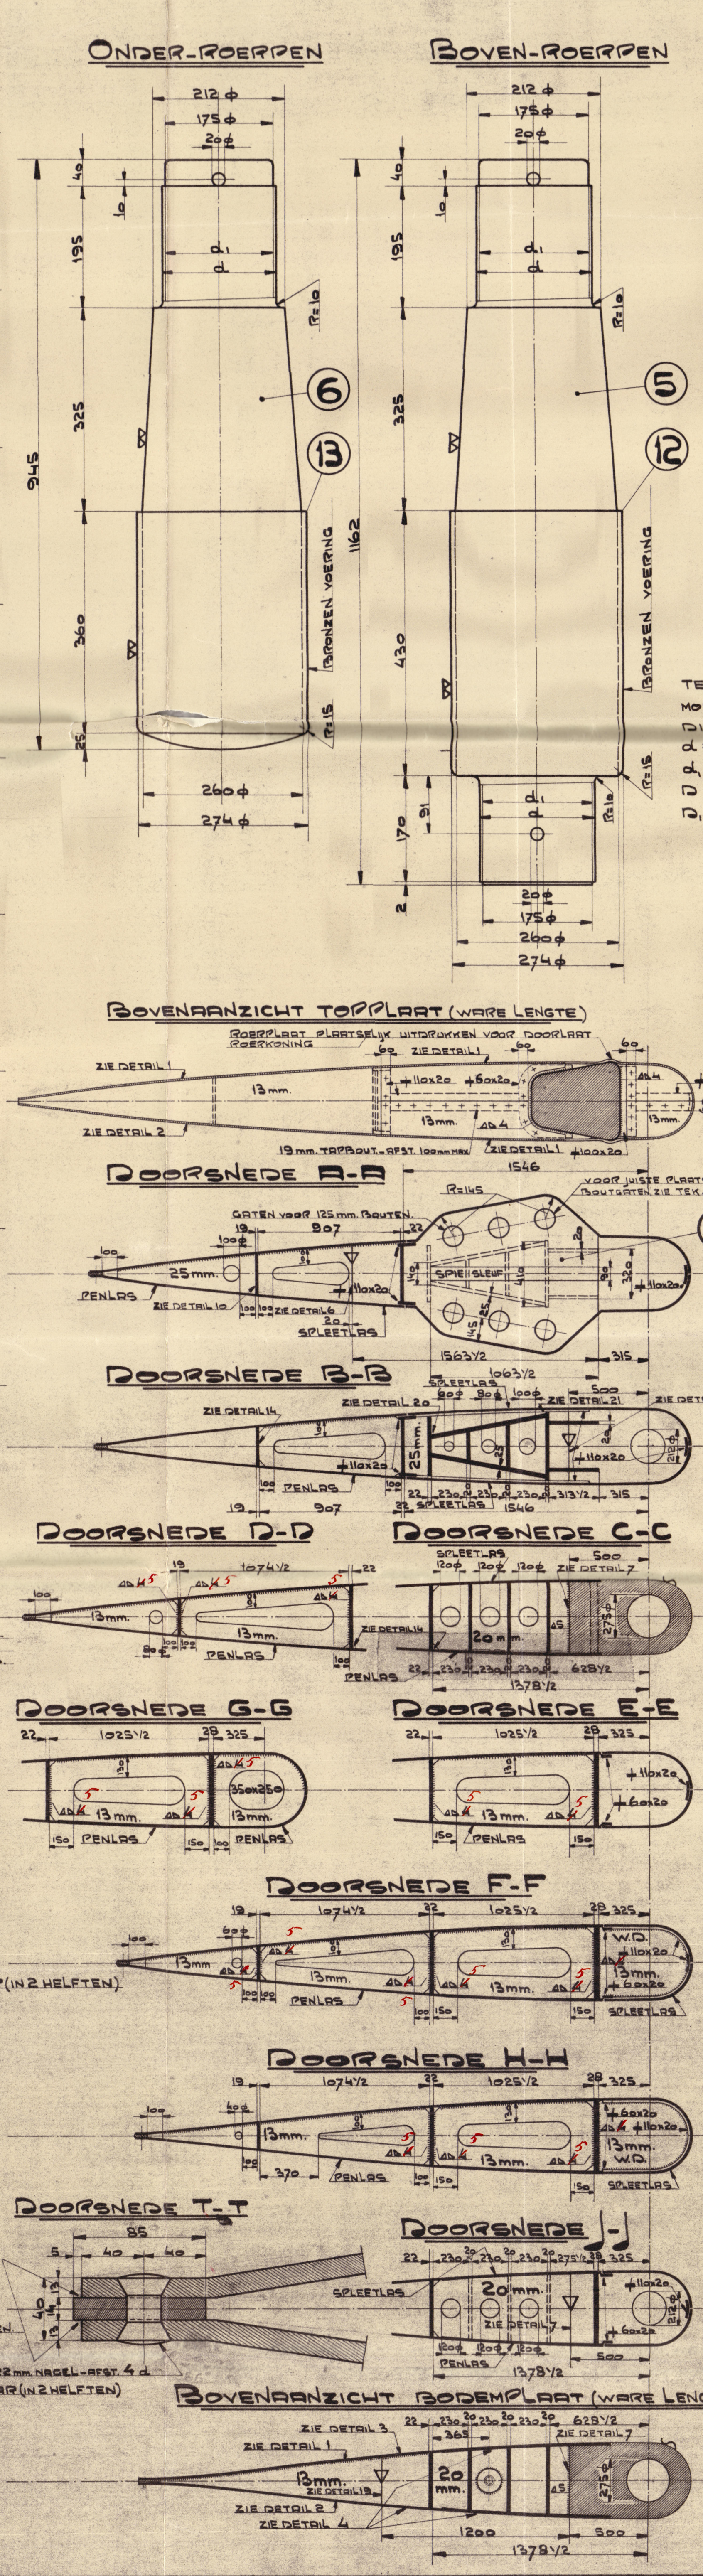

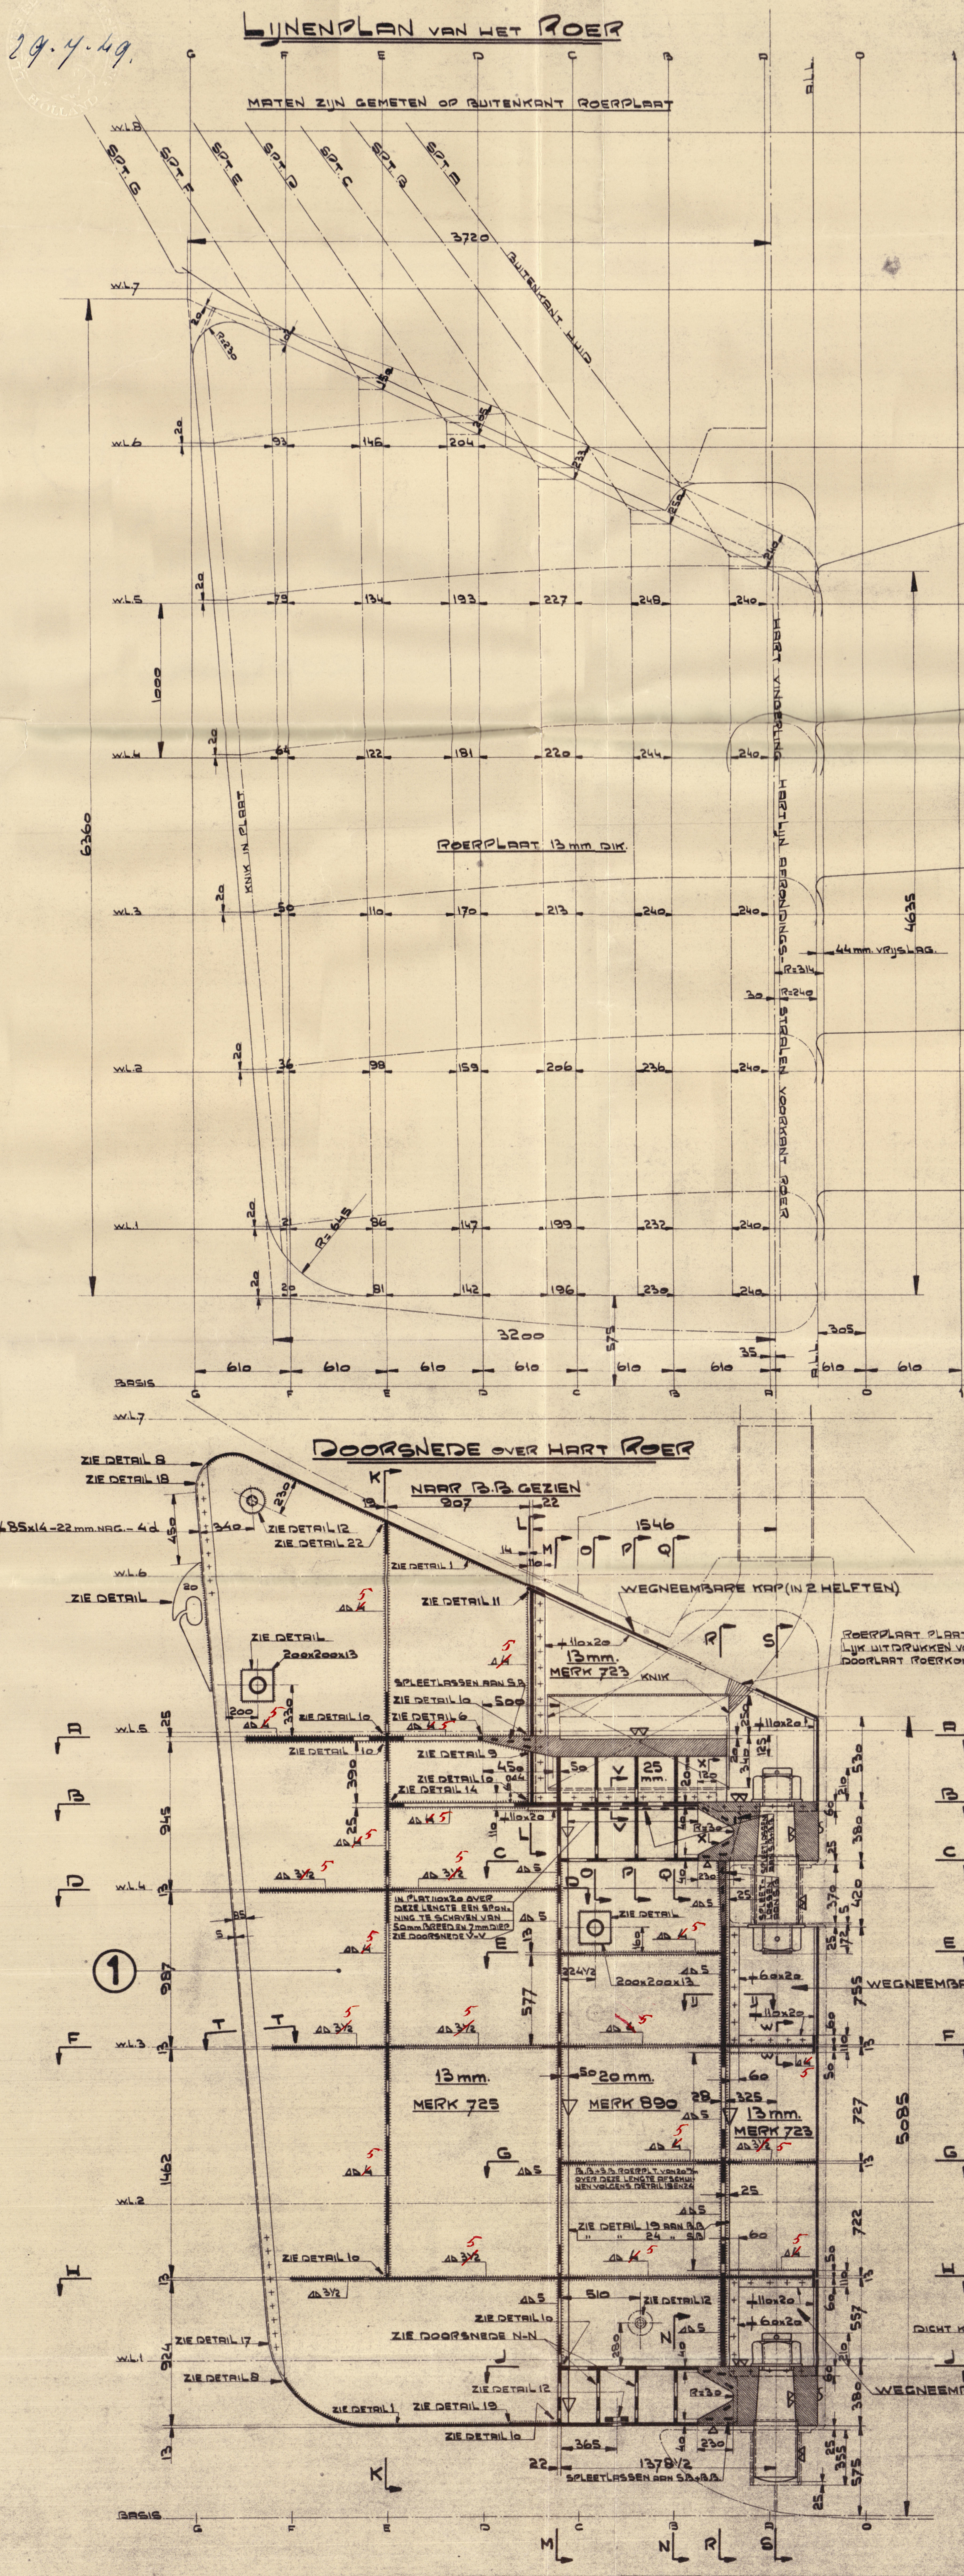

'DIRECTOR MADARIAGA' ★

RECORDS DEPT.,
LONDON

13

P. SMIT JR.
YARD NOS. 596-9

RUDDER



© 2021

Lloyd's Register
Foundation