

S.S. "HOLMSIDE" - OIL FUEL CONVERSION 20705


ARREST of AIR & SOUNDING PIPES TO NEW O.F. BUNKER & SETTLING TANKS

SCALE 1/8" = 1 FOOT

NOTES:-

- BRASS WIRE GAUZE DIAPHRAGMS TO BE FITTED TO OPEN ENDS OF O.F. TANK AIR PIPES. ✓
- MAKE & FIT NAMEPLATES TO UPPER ENDS OF AIR PIPES. ✓
- O.F. TANK AIR & SOUNDING PIPES TO BE OF WROUGHT IRON. ✓
- MINIMUM HEIGHT OF MOUTH OF AIR PIPES TO BE 30" ABOVE RAISED QUARTER DECK. ✓
- SOUNDING PIPES TO BE FITTED WITH DECK PLATES STAMPED WITH NAME OF TANK. ✓
- & BRASS SCREWED COVERS, STRIKING PLATES TO BE WELDED UNDER PIPES. ✓

3/2 7/18

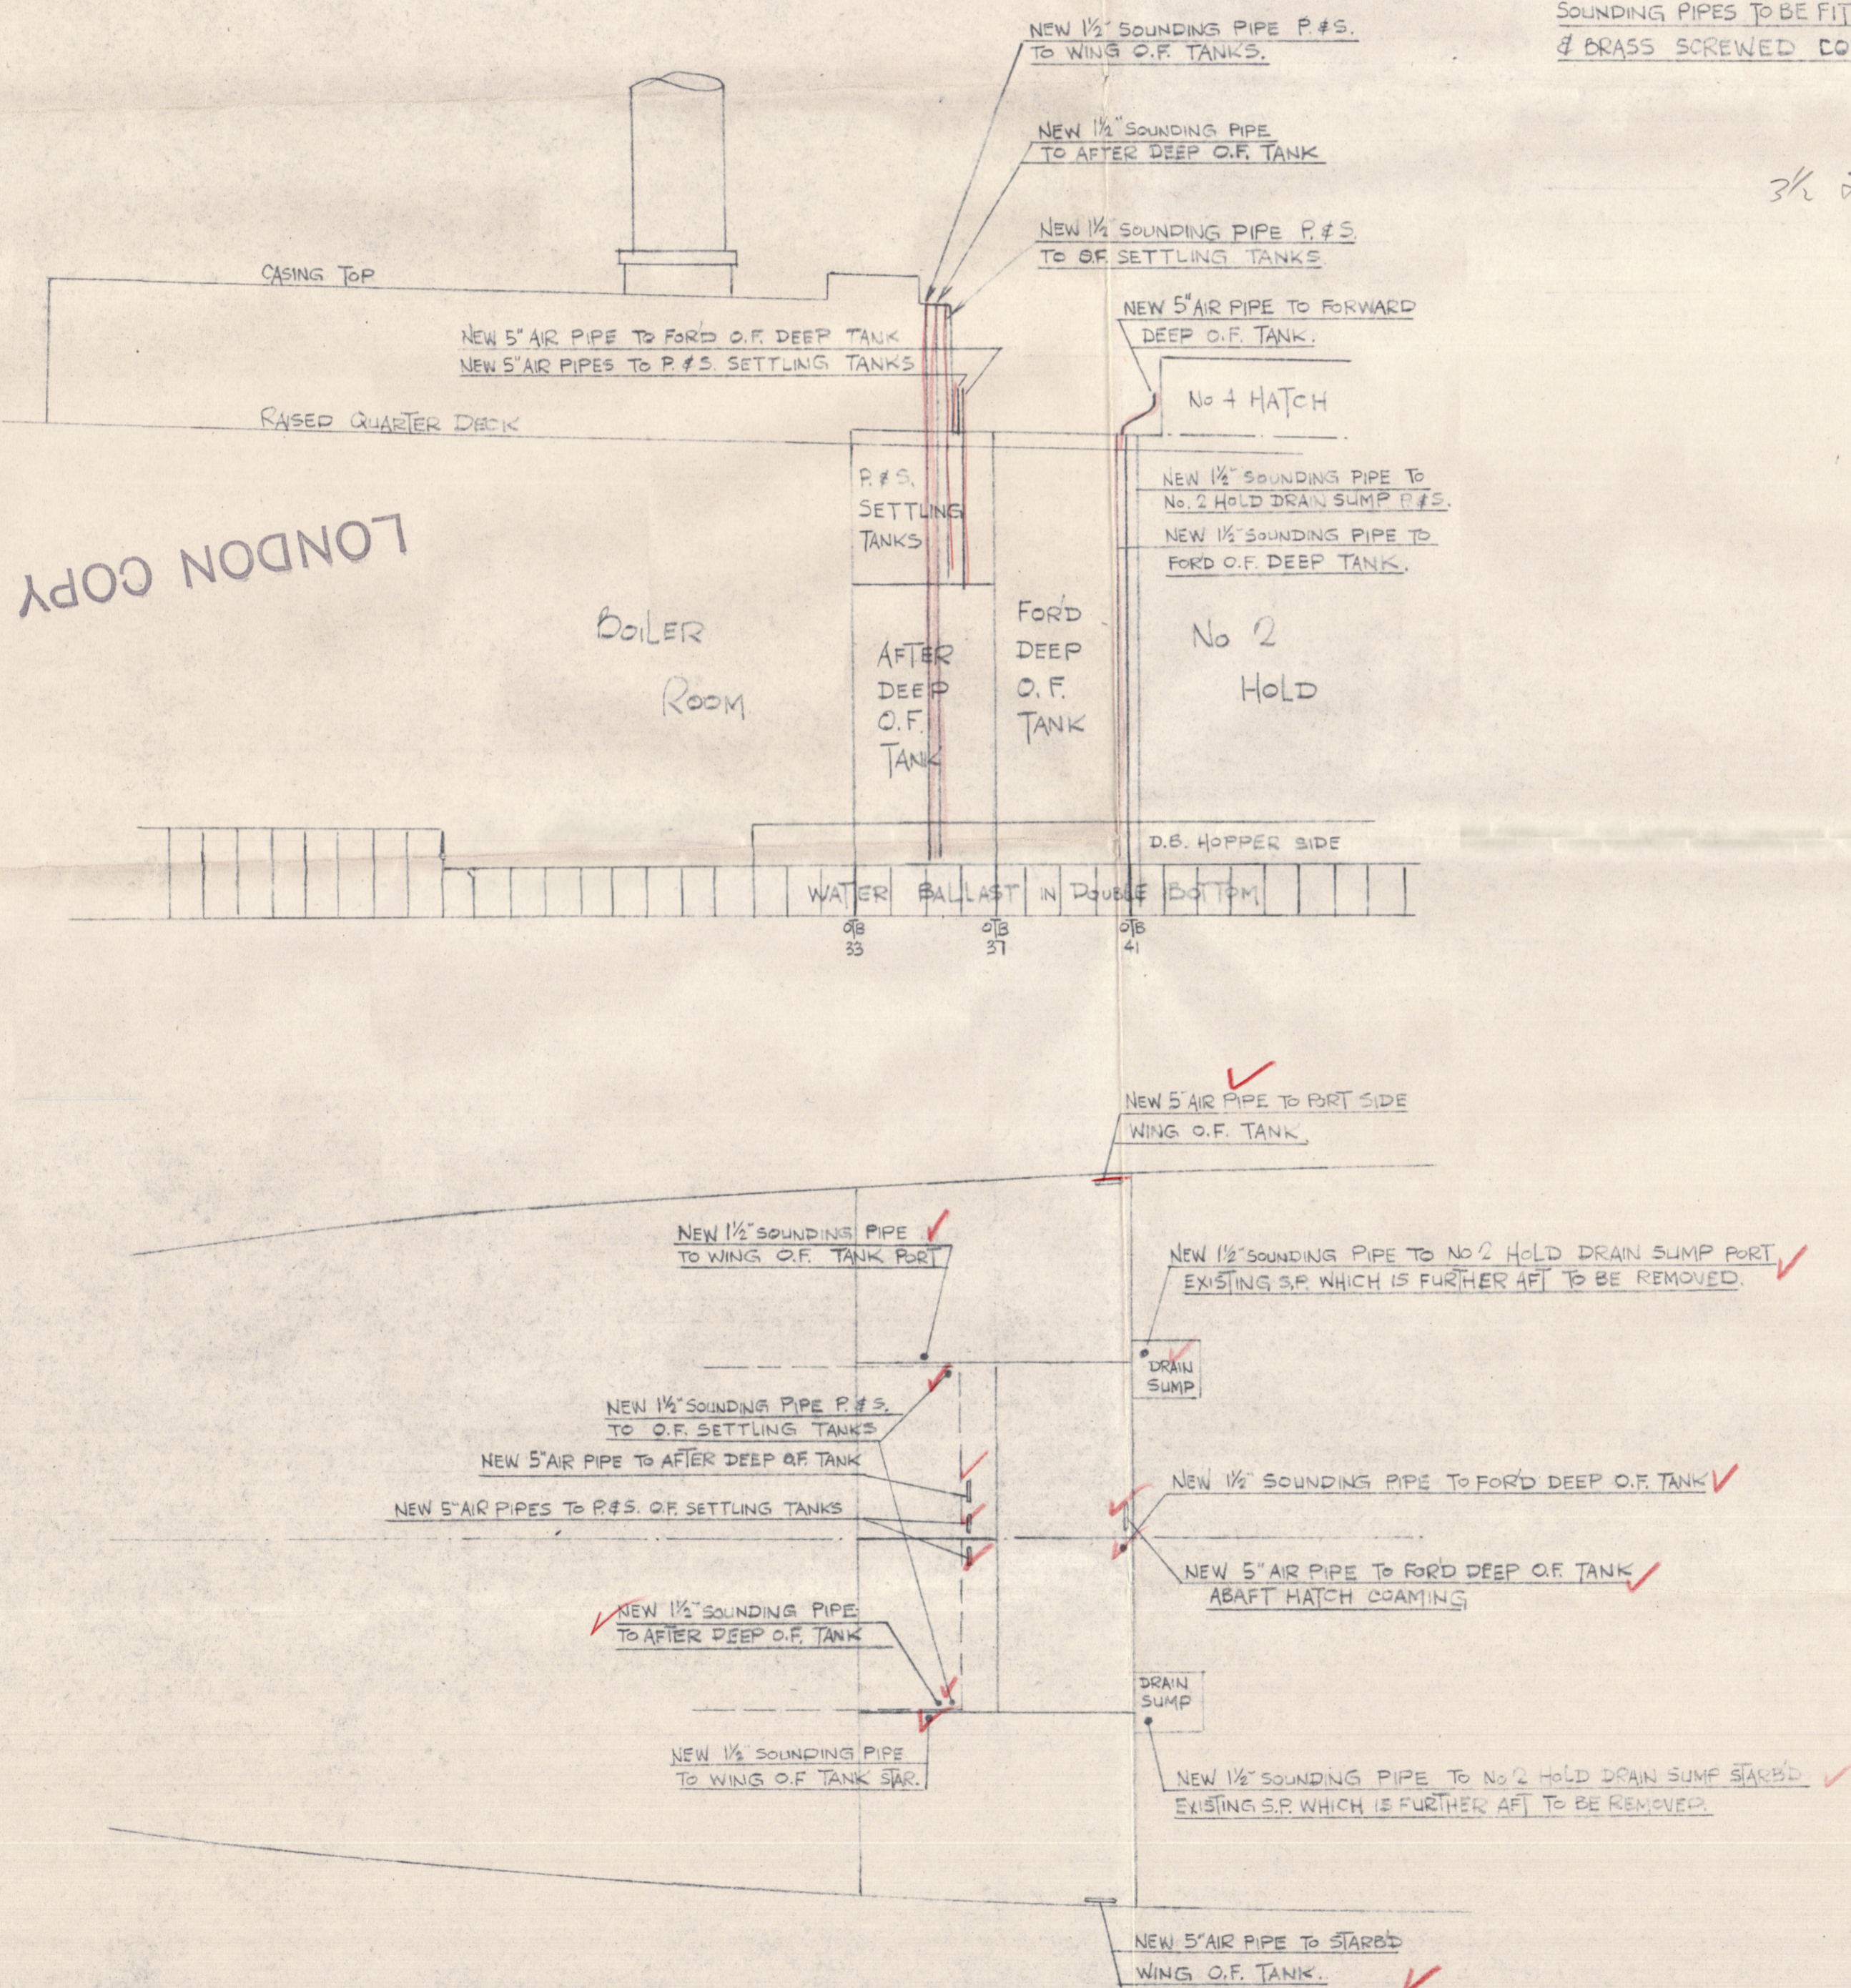

The remaining requirements of the Rules for Pumping and Piping to be complied with so far as they are applicable.

-9 APR 1956

SMITH'S DOCK CO. LTD.
SOUTH BANK-ON-TEES.

26/3/56 RLA.

LONDON COPY

"Holmside"
Air and Sounding Pipes to
New O.F. Barker - Settling
Tanks

009789-009795-0078



© 2021

Lloyd's Register
Foundation