




Snitt i rom, se tegn. nr. T-45-8

The remaining requirements of the Rules for Refrigerating Machinery & Appliances to be complied with so far as they are applicable.

**LONDON COPY.**

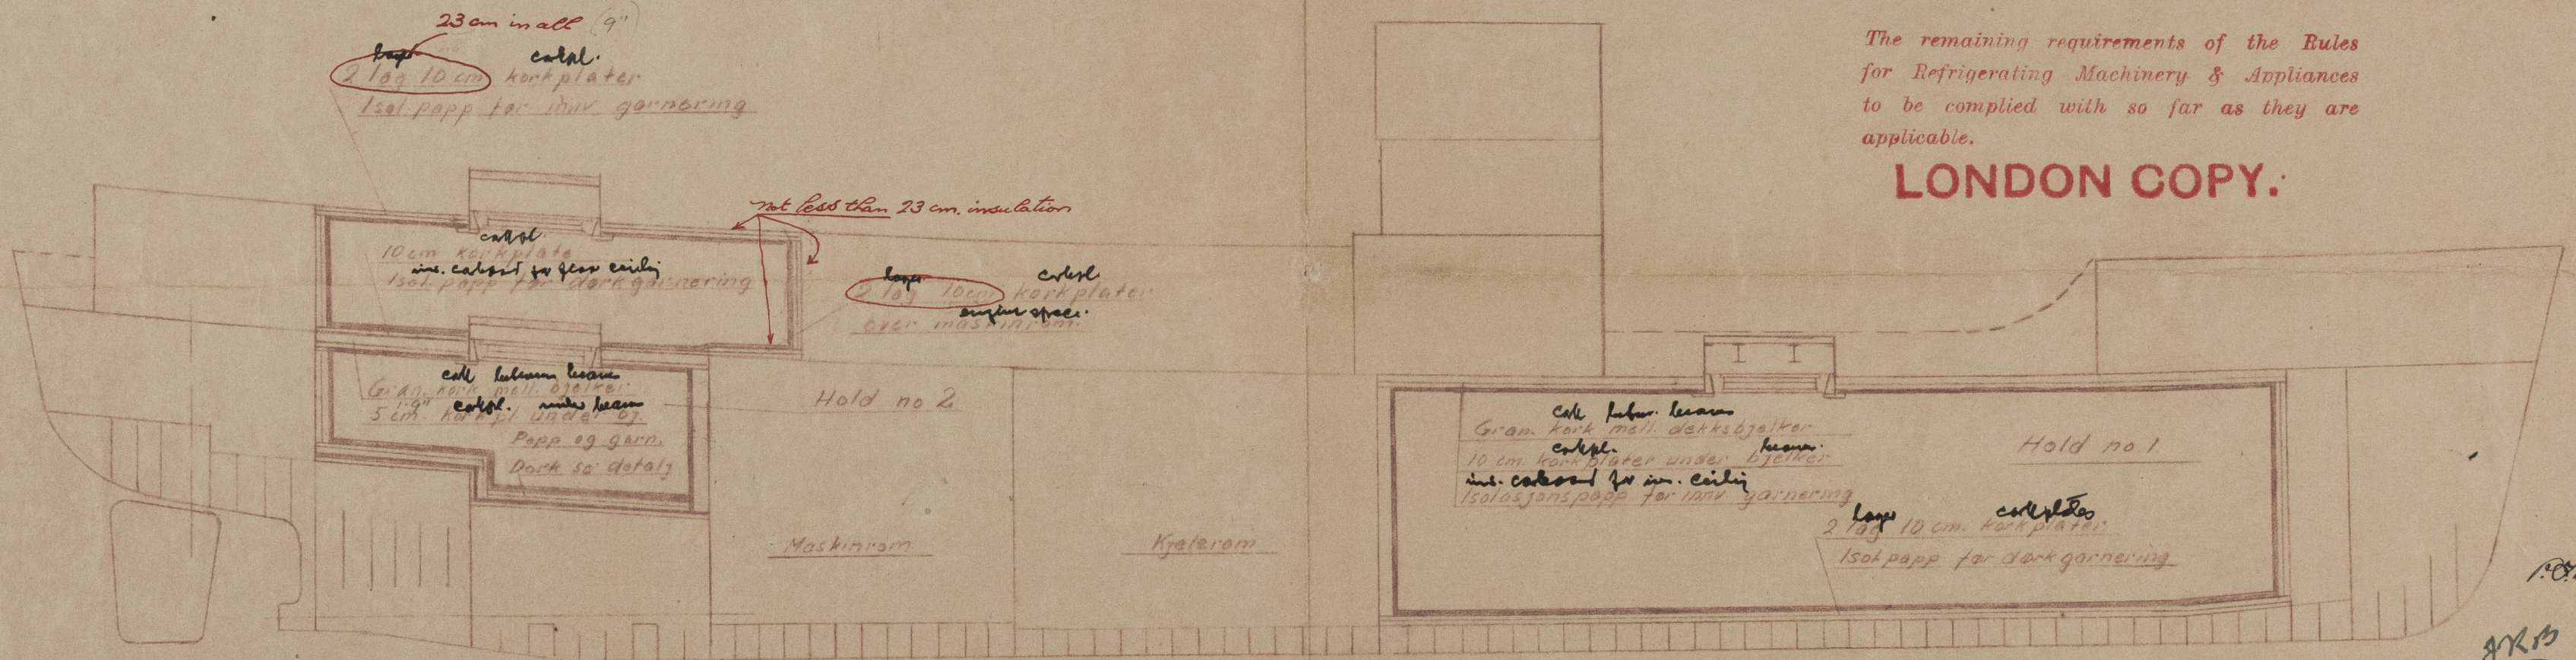

of "Kittern" Stord.  
Insulation of refrigerated hold.  
Isolasjon av fryse lasterom  
1. Lengdesnitt.

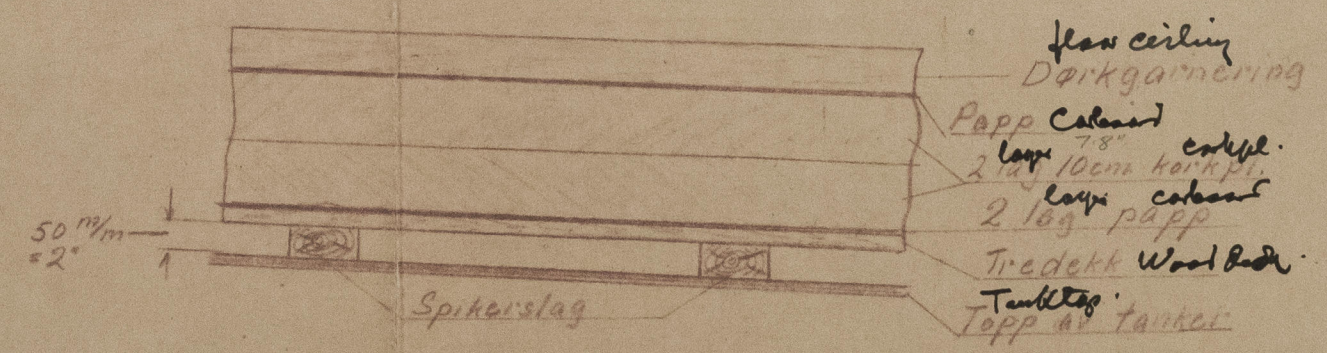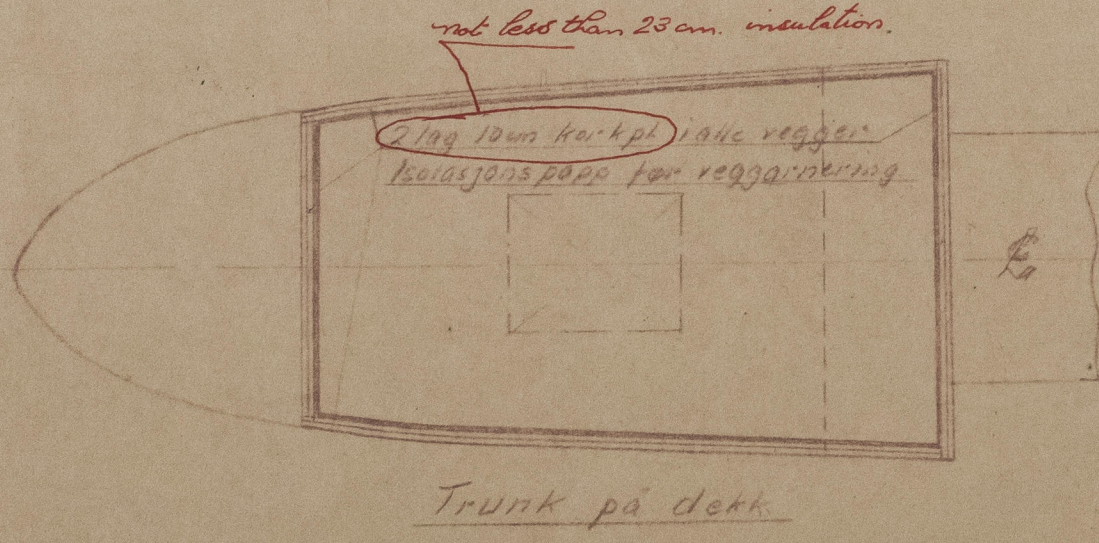

Snitt i dekkisolasjon, hold no. 2

CHRISTIAN BERNER & SÖN		
Målestokk	IKAS	Dato 31/10-46
Vårt arkiv nr. 745-7		



D. Yora

009789-009795-0144



© 2021

Lloyd's Register  
Foundation