
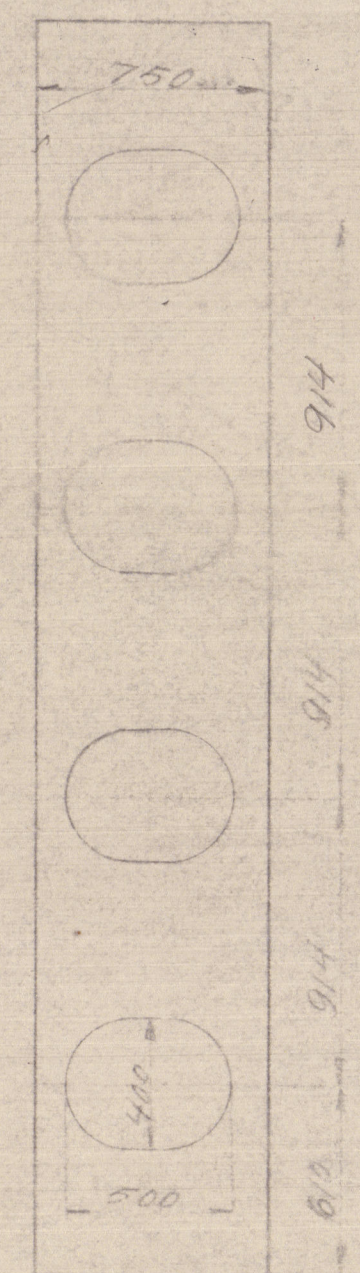



SEEN FROM MIDSHIPS
 SEEN FROM MIDSHIPS
 PORT SERVICE TANK
 B.B. distant 58m.

SEEN FROM AFT
 SEEN FROM AFT

SEEN FROM CENTRELINE
 SEEN FROM CENTRELINE
 STARBOARD SERVICE TANK
 S.P. distant 2.6 ton

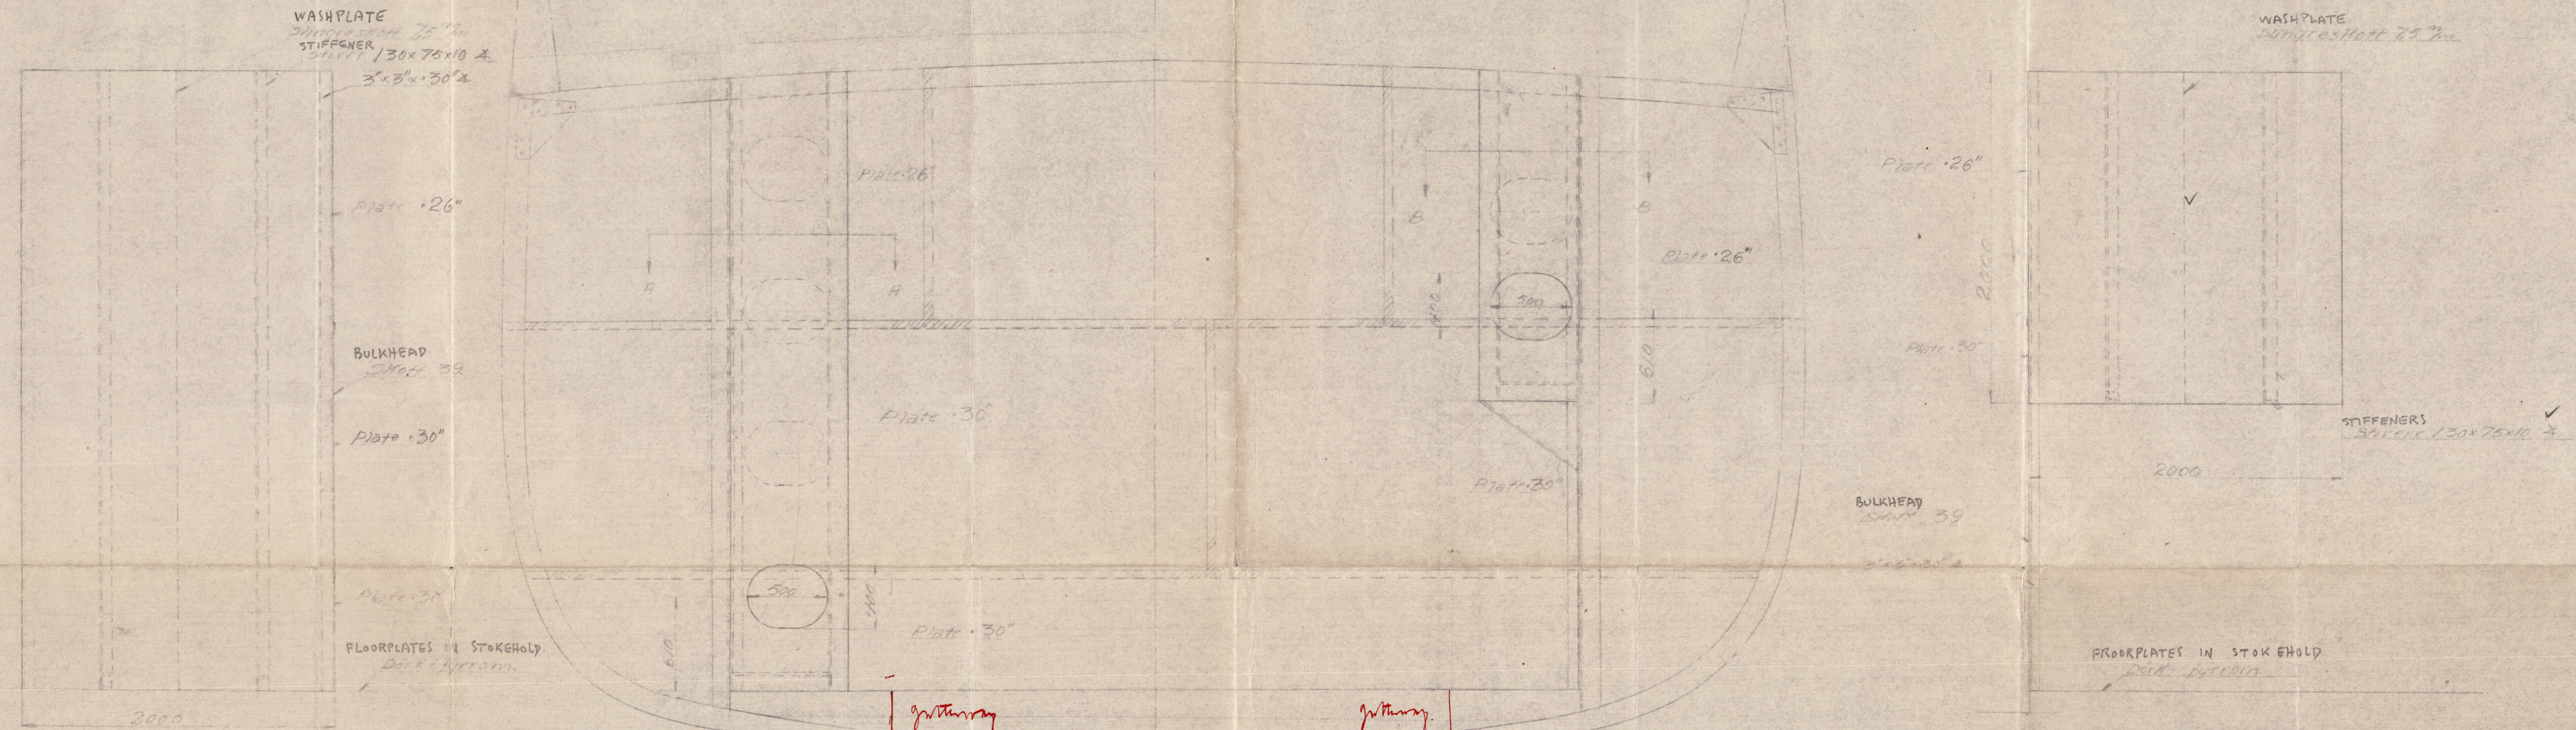


WASHPLATE IN PORT TANK
 Single shot 13.6 ton

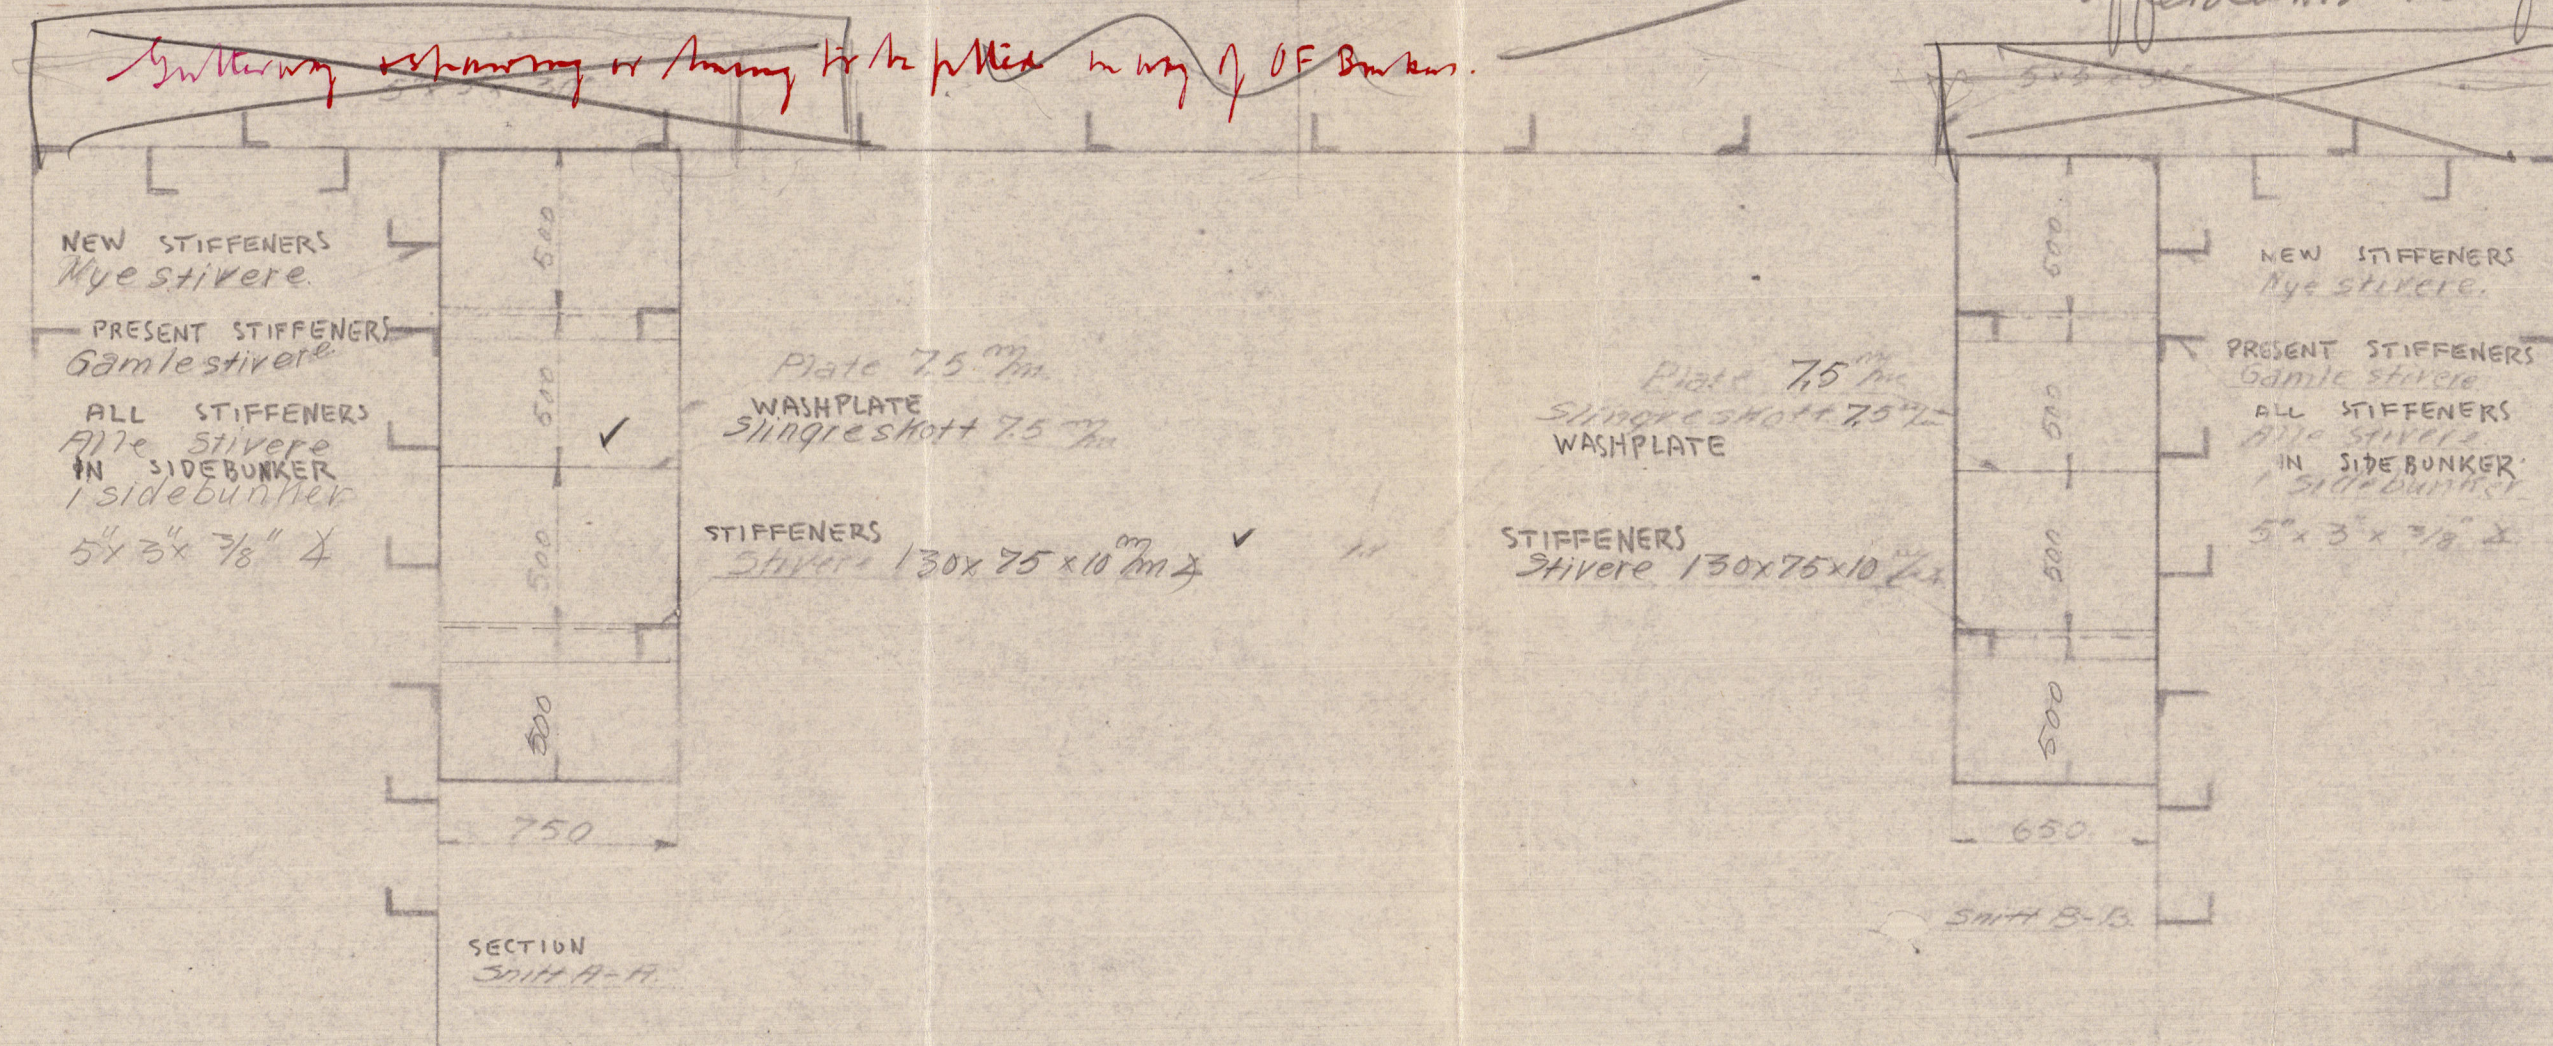

STIFFENERS
 130x75x10m

NEW STIFFENERS
 Present stiffeners
 ALL STIFFENERS
 IN SIDEBUNKER
 5x3x7/8"

Hold Carrying Deck
 Cofferdams to be fitted
 See letter
 9/10/46

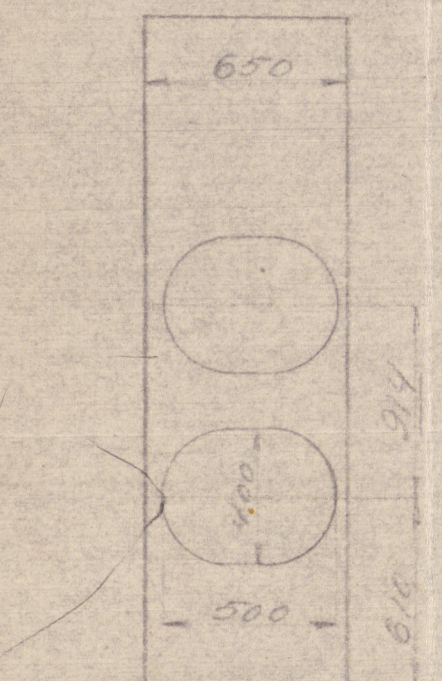

WASHPLATE IN STARBOARD TANK
 Single shot 13.6 ton

ALL CONNECTIONS TO BE WELDED
 Alle forbindelser sveises.
 Alle skjøter og støter i de
 gamle plater foreslås
 sveiset
 IT IS PROPOSED TO WELD ALL
 SEAMS & BUTTS OF PRESENT
 PLATES.

Basiller	ONLY SERVICE TANKS IN STOKHOLD Dagtanke pyram.	Målestokk	Tegn	1/2-1	Trac	1/2-1
Order	ASTORD LERVIK - SPORD	Nr.	1558	Lloyd's Register Foundation		

15-8-46