


AFTER PEAK  
PLAN TO BE  
SUBMITTED

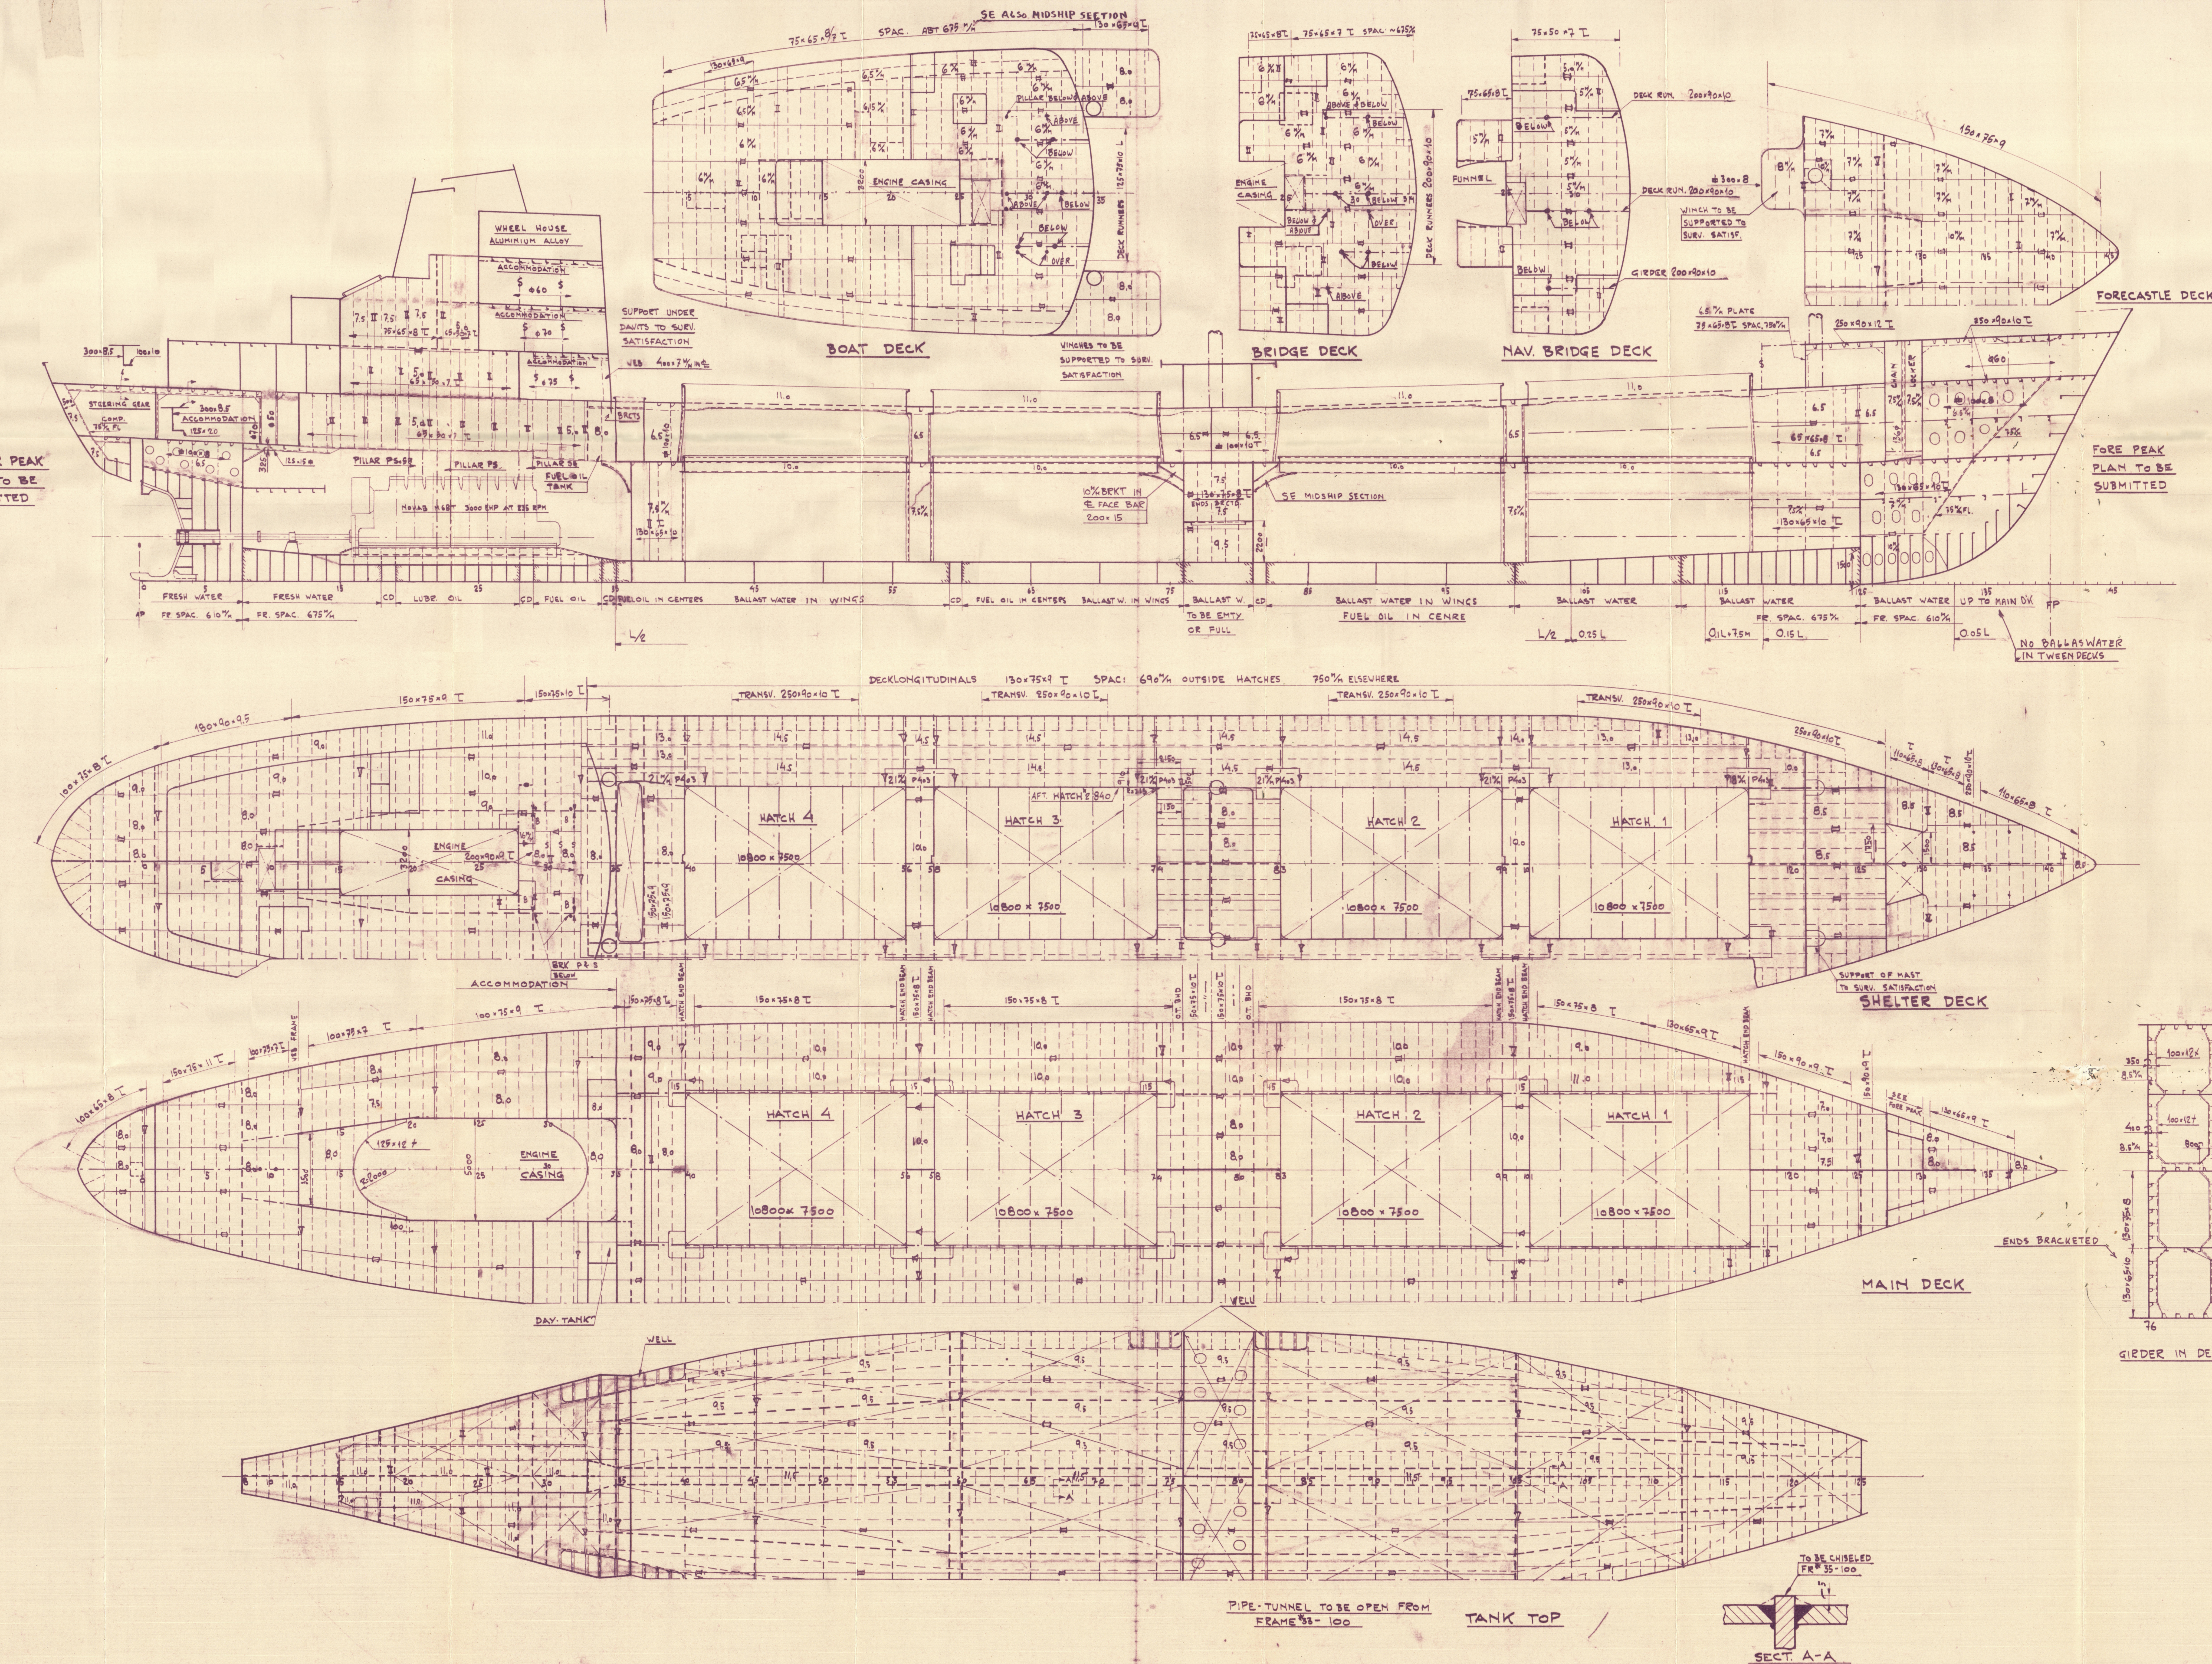

# **DIMENSIONS:**

LENGTH BETWEEN P.P.	93.33M
BREADTH MOULDED	14.4M
DEPTH	5.89M
TO MAIN D.K.	8.34M
TO SHELTER D.K.	2.1M
HEIGHT OF FORECASTLE	2.28M
DECK HOUSES	2.28M
NAV. HOUSE	2.28M
WINCH HOUSE	2.1M
SPEED LOADED AS OPEN SHELTER D.K. WITH	14.0 knots
AS CLOSED DRAUGHT 6.55	13.6

# **CLASS:**

LLOYD'S REGISTER 100 A1  
STRENGTHENED FOR NAVIGATION IN ICE  
LONGITUDINAL FRAMING AT BOTTOM  
AND UPPER D.K.  
ELECTRICALLY WELDED

# **RS BUILT PLAN**

AS NOERKÖPINGS VARV & VERKSTAD  
NORRKÖPING

M/S 158

LONG. SECTION AND PLANS

RTM	GR. AV	SWALA 1:100
KOP. AV	G.D. AV	DATUM: 1953.12.15
LITT.	RTM. N. 158-11	

RÄTTAD ENL LLOYD'S 6/12-56

CONSTR. DOKUMENT-0234



A/B HÖRRIKÖRINGS VARU & VERKSTAD.

YARD NO. 158.


M/S "CECILIA FALKLAND" ★

LONG. SECTION AND PLANS (AS BUILT).

STOCKHOLM REPORT No. 11581

015737

RECORDS DEPT.  
LONDON.

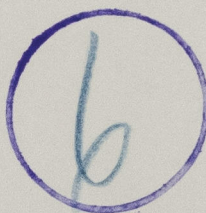

© 2021

Lloyd's Register  
Foundation

009815-009826-0239