

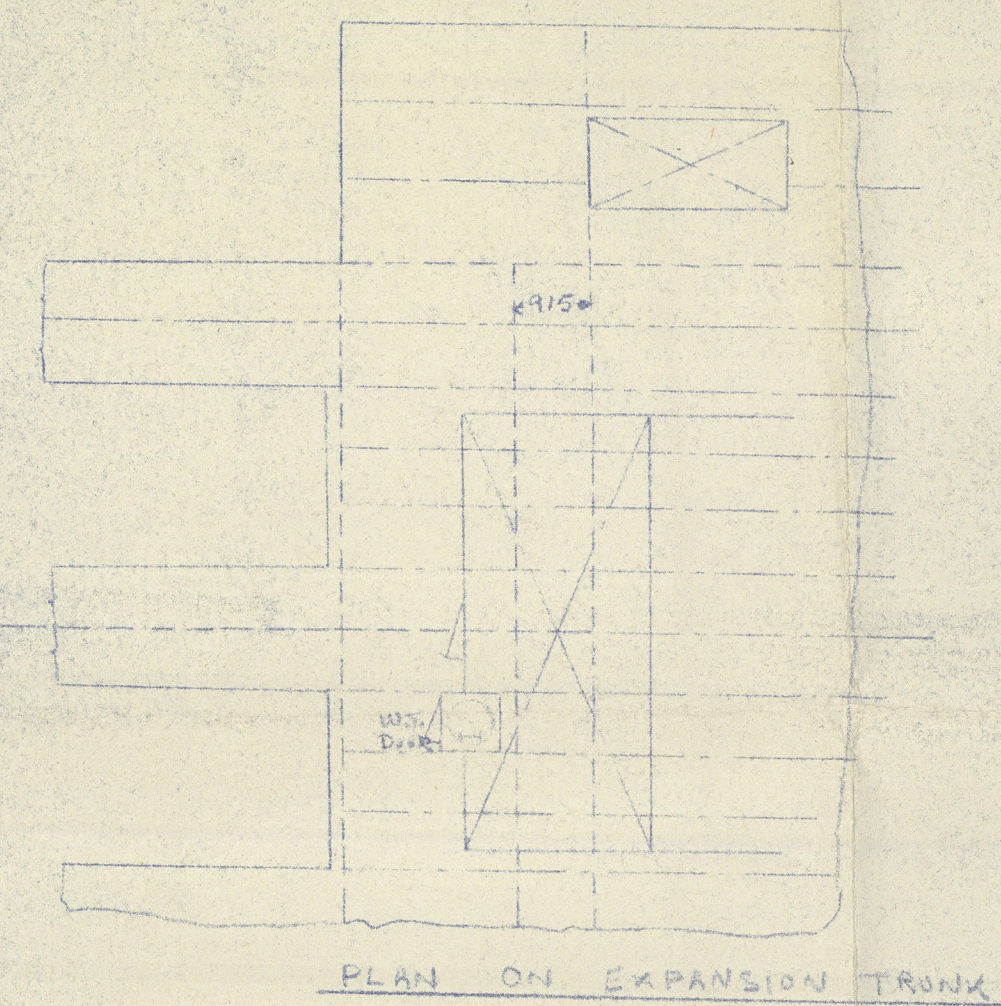
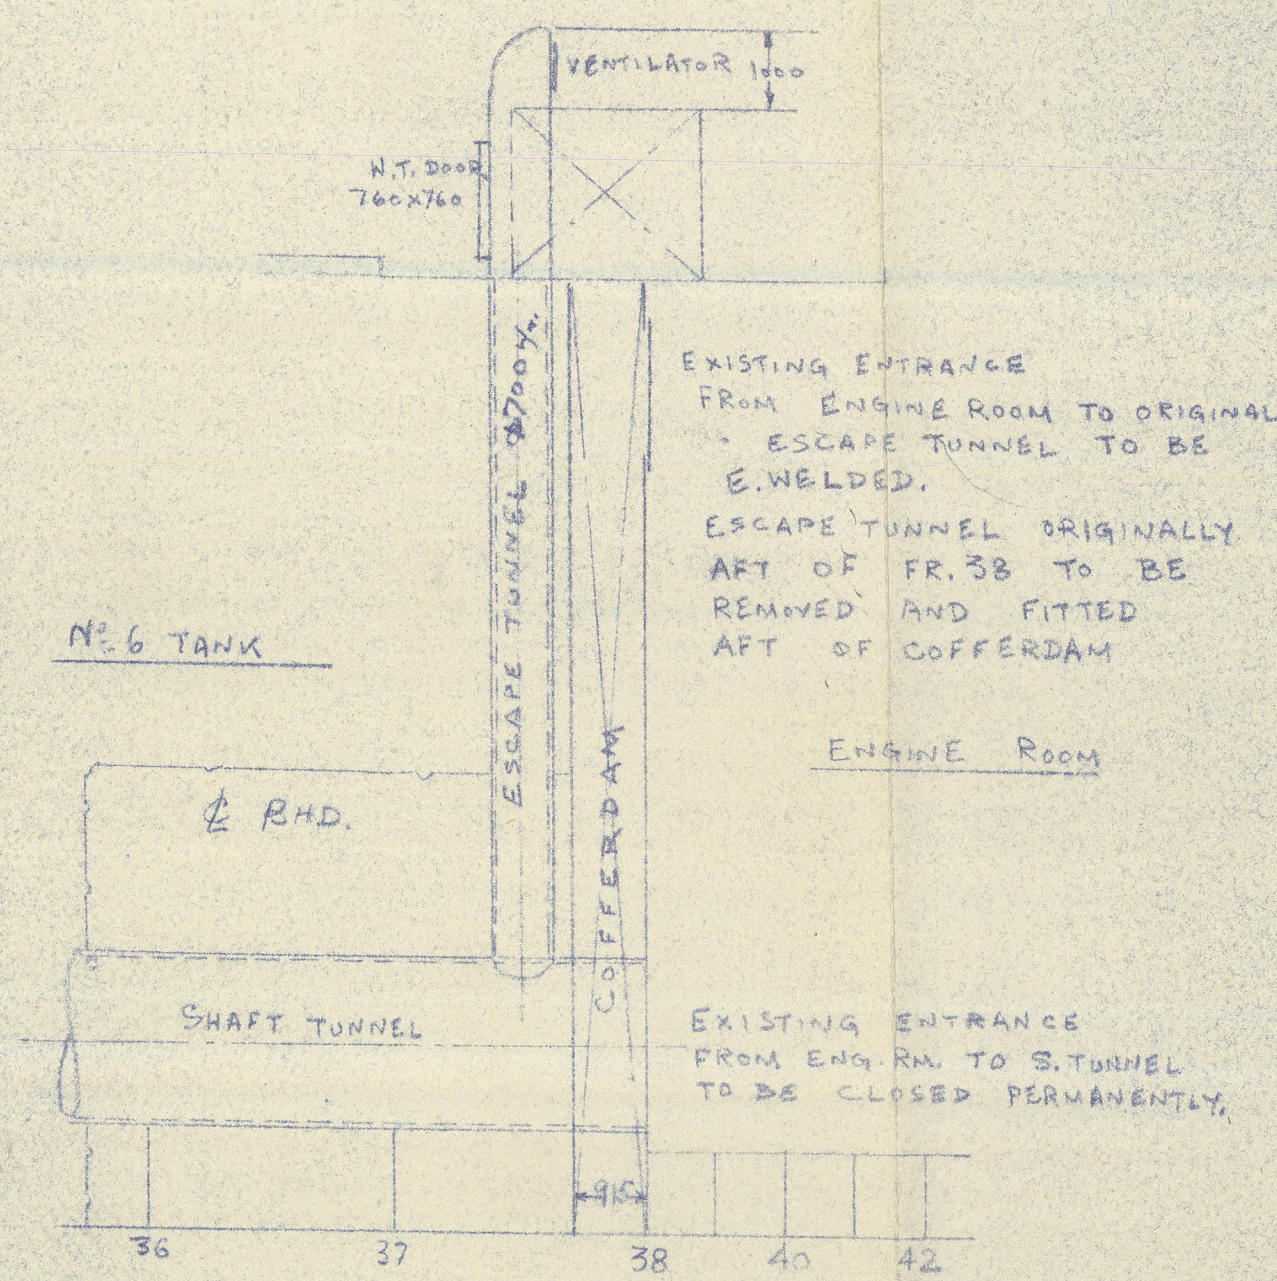
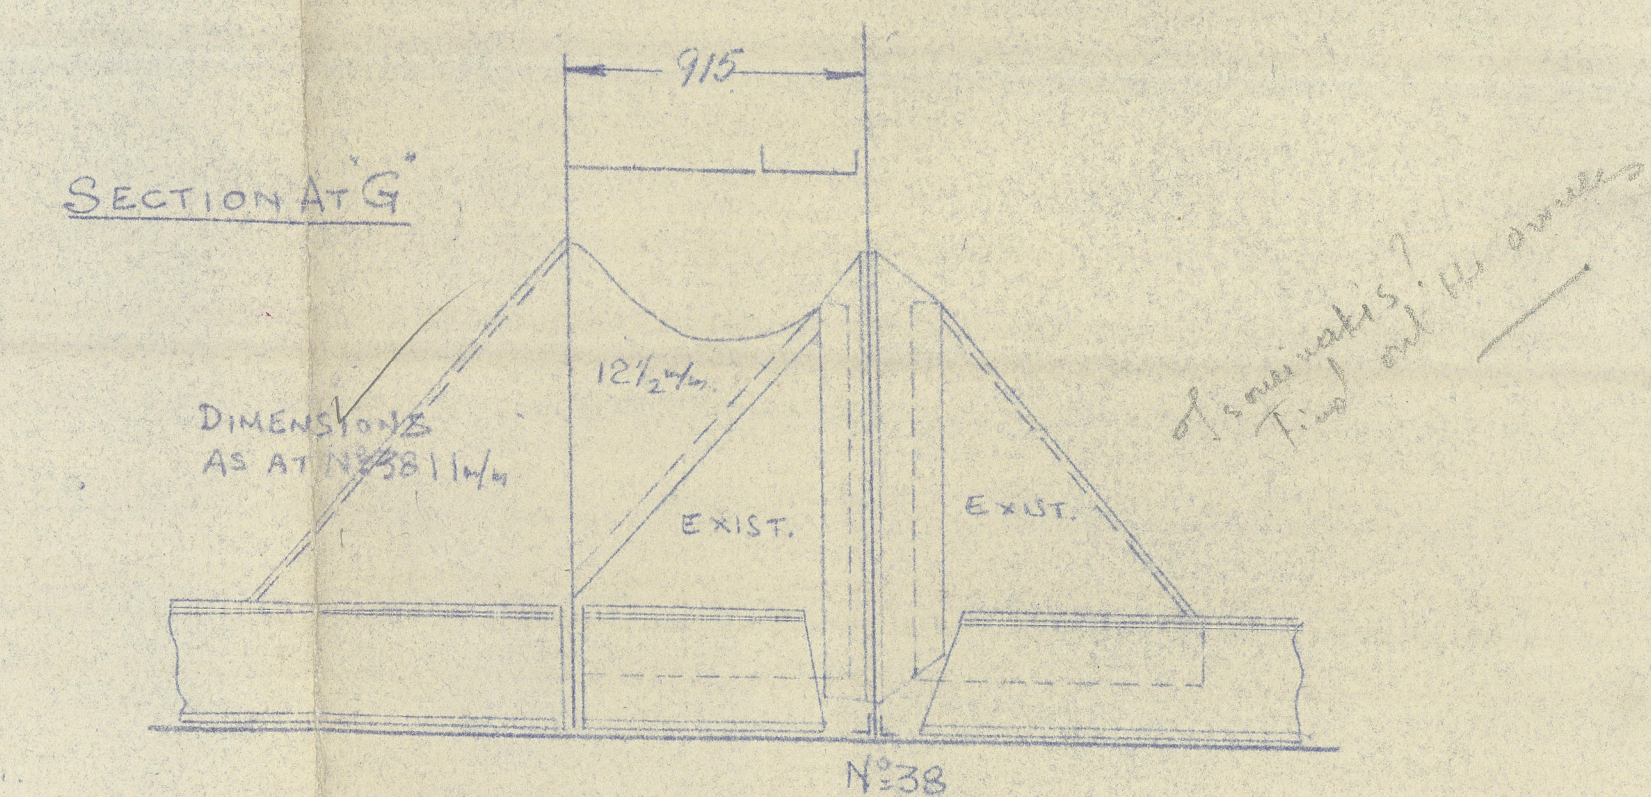
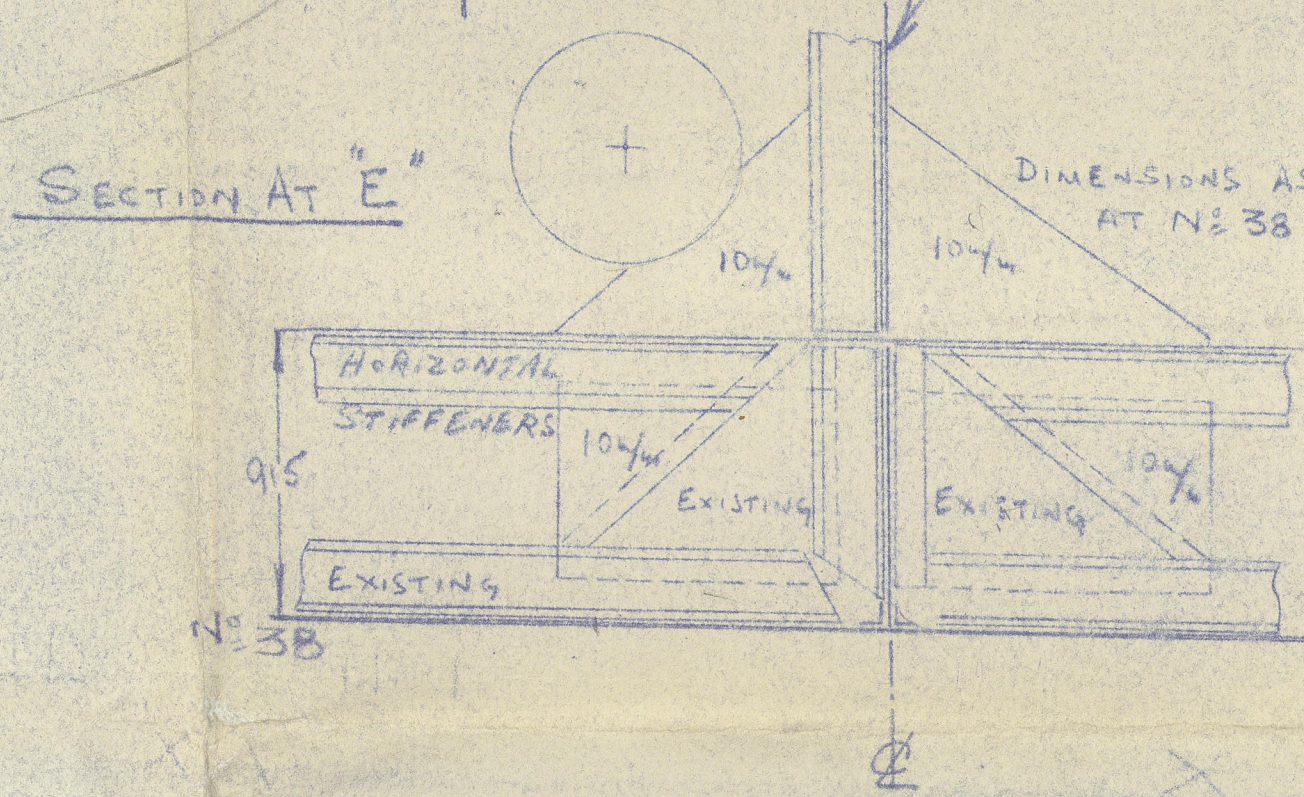
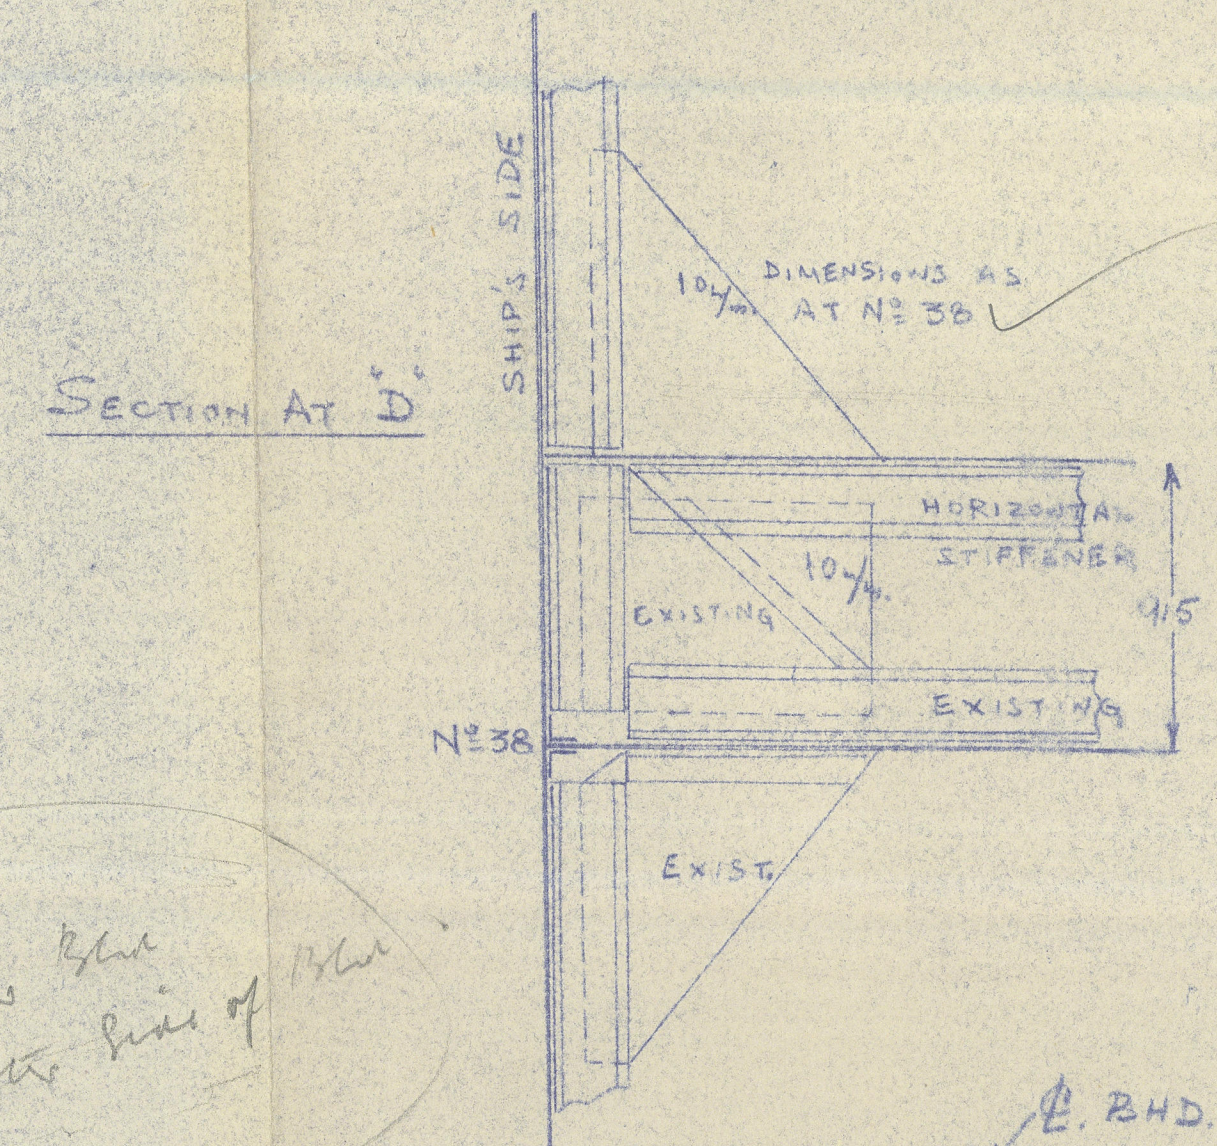
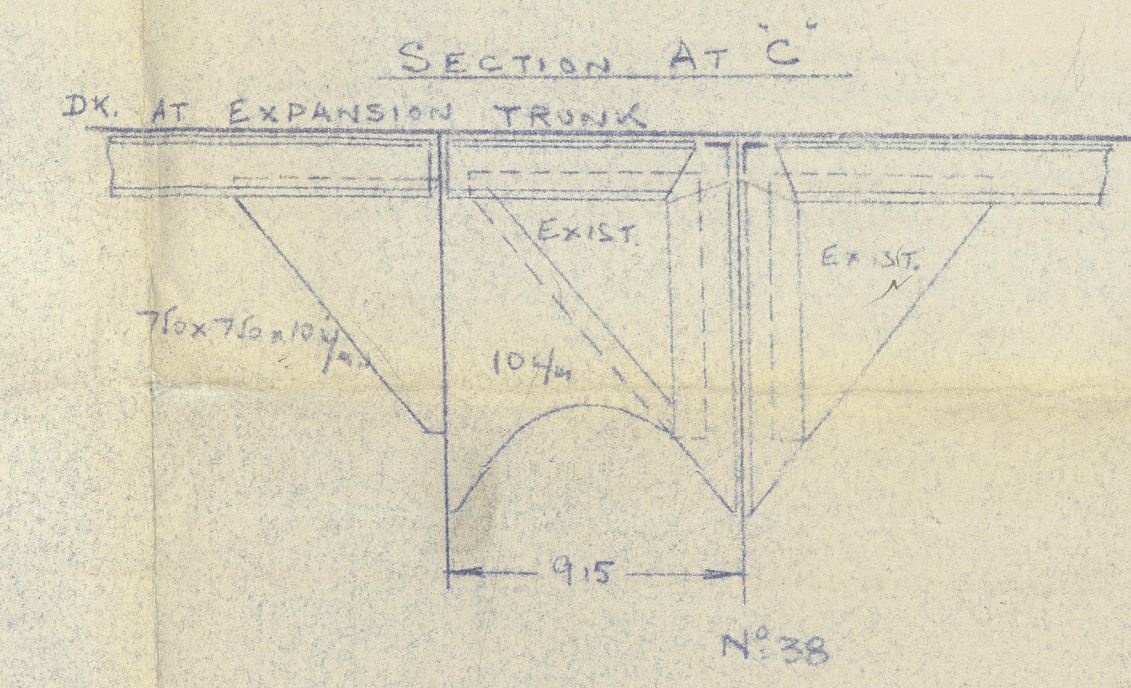
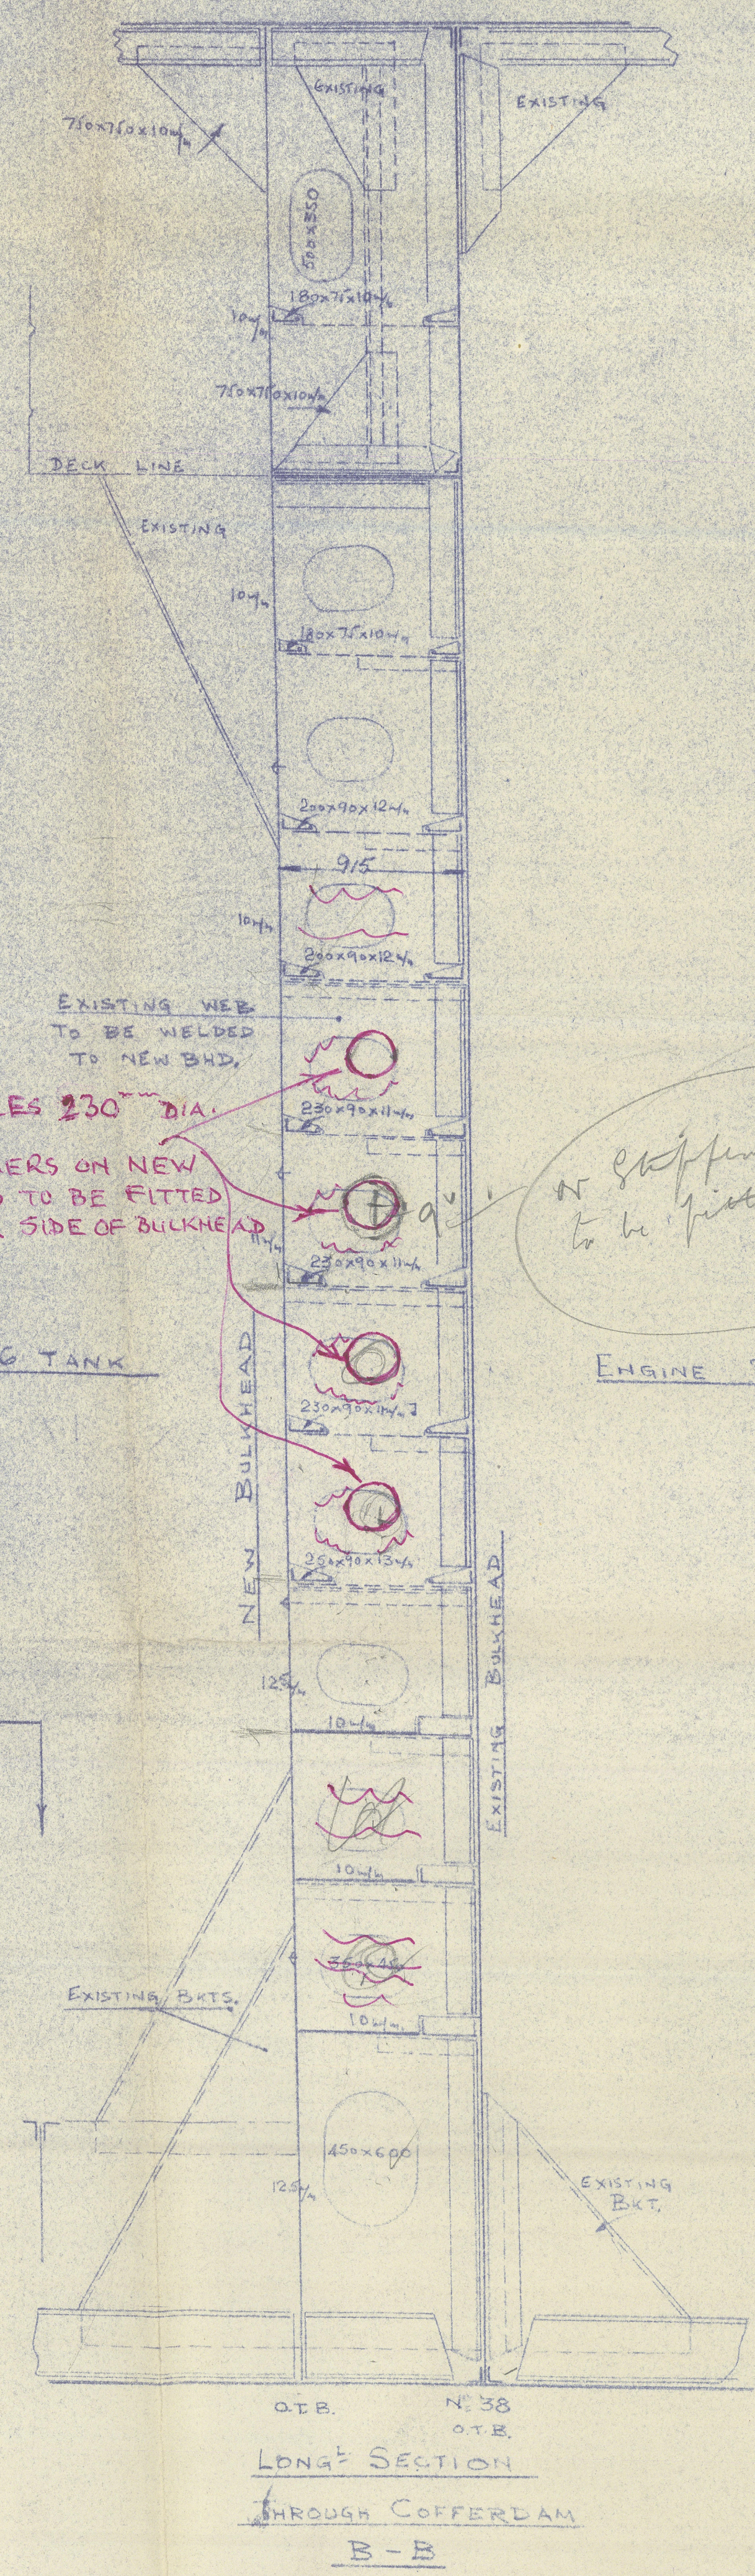
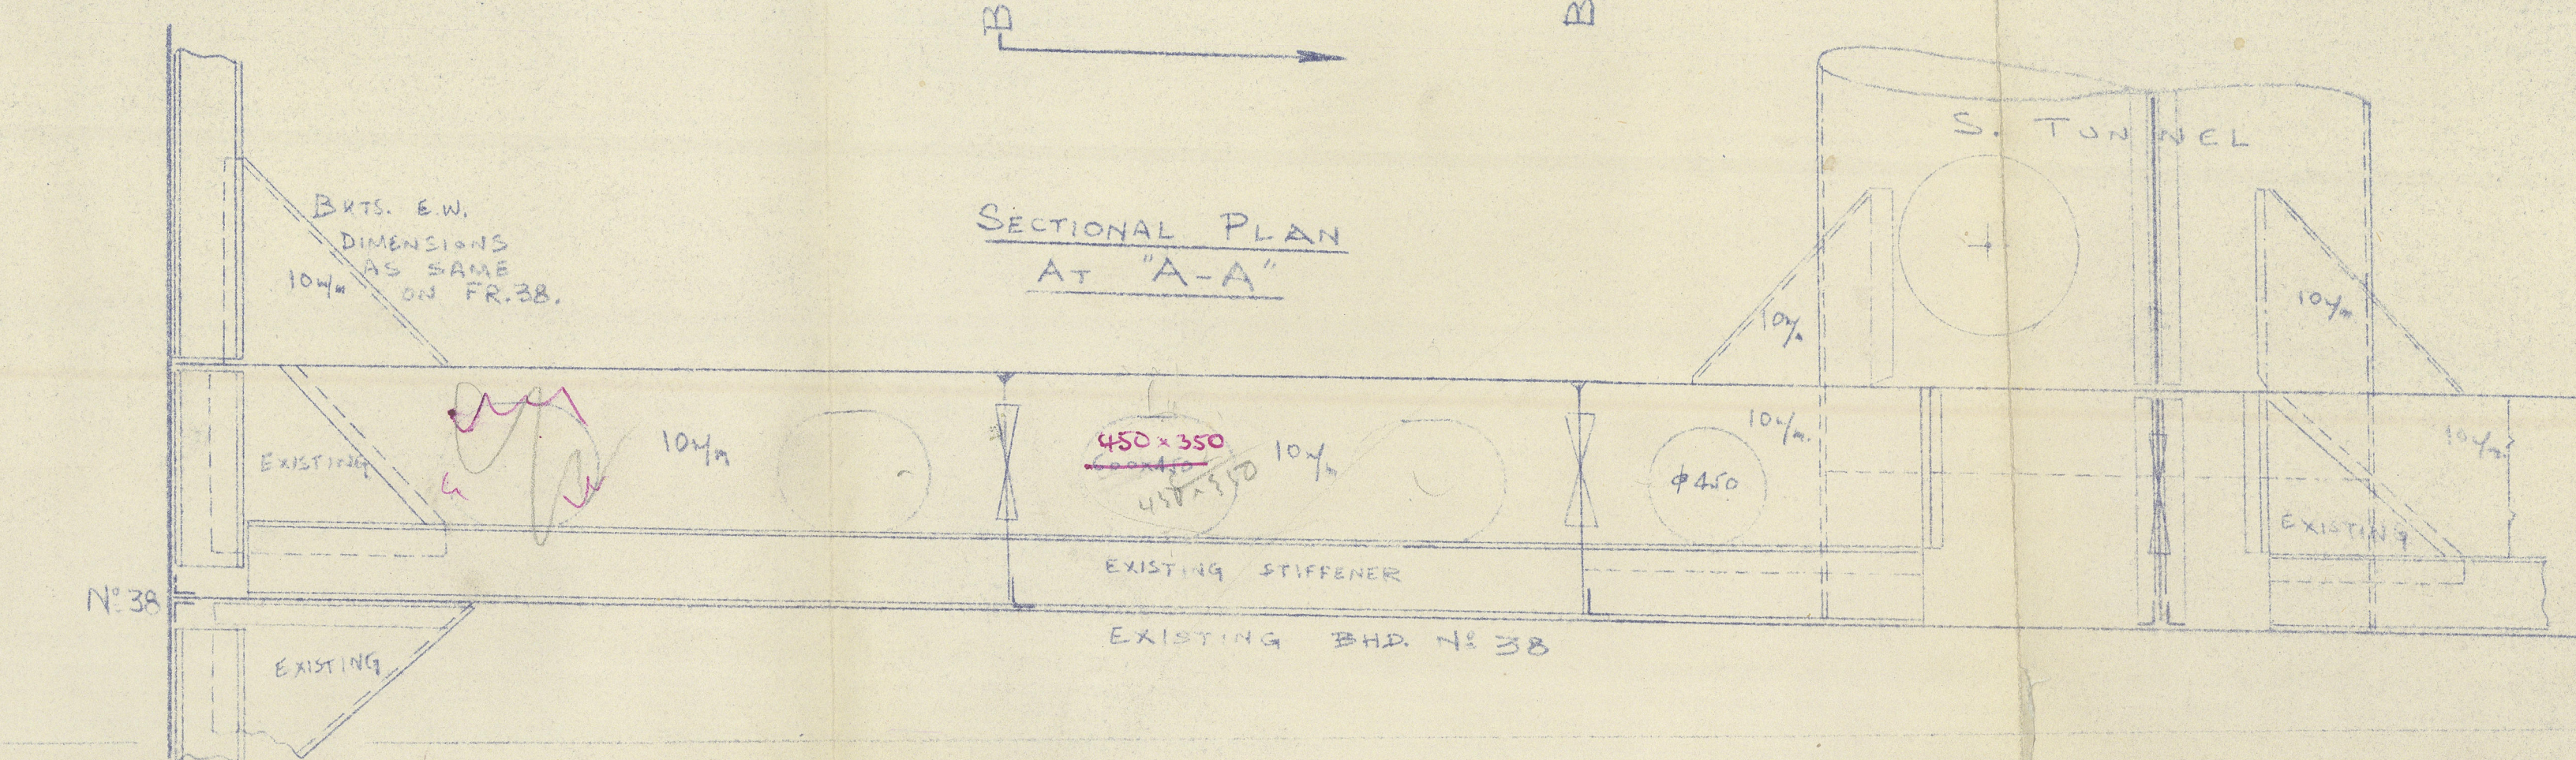


Office

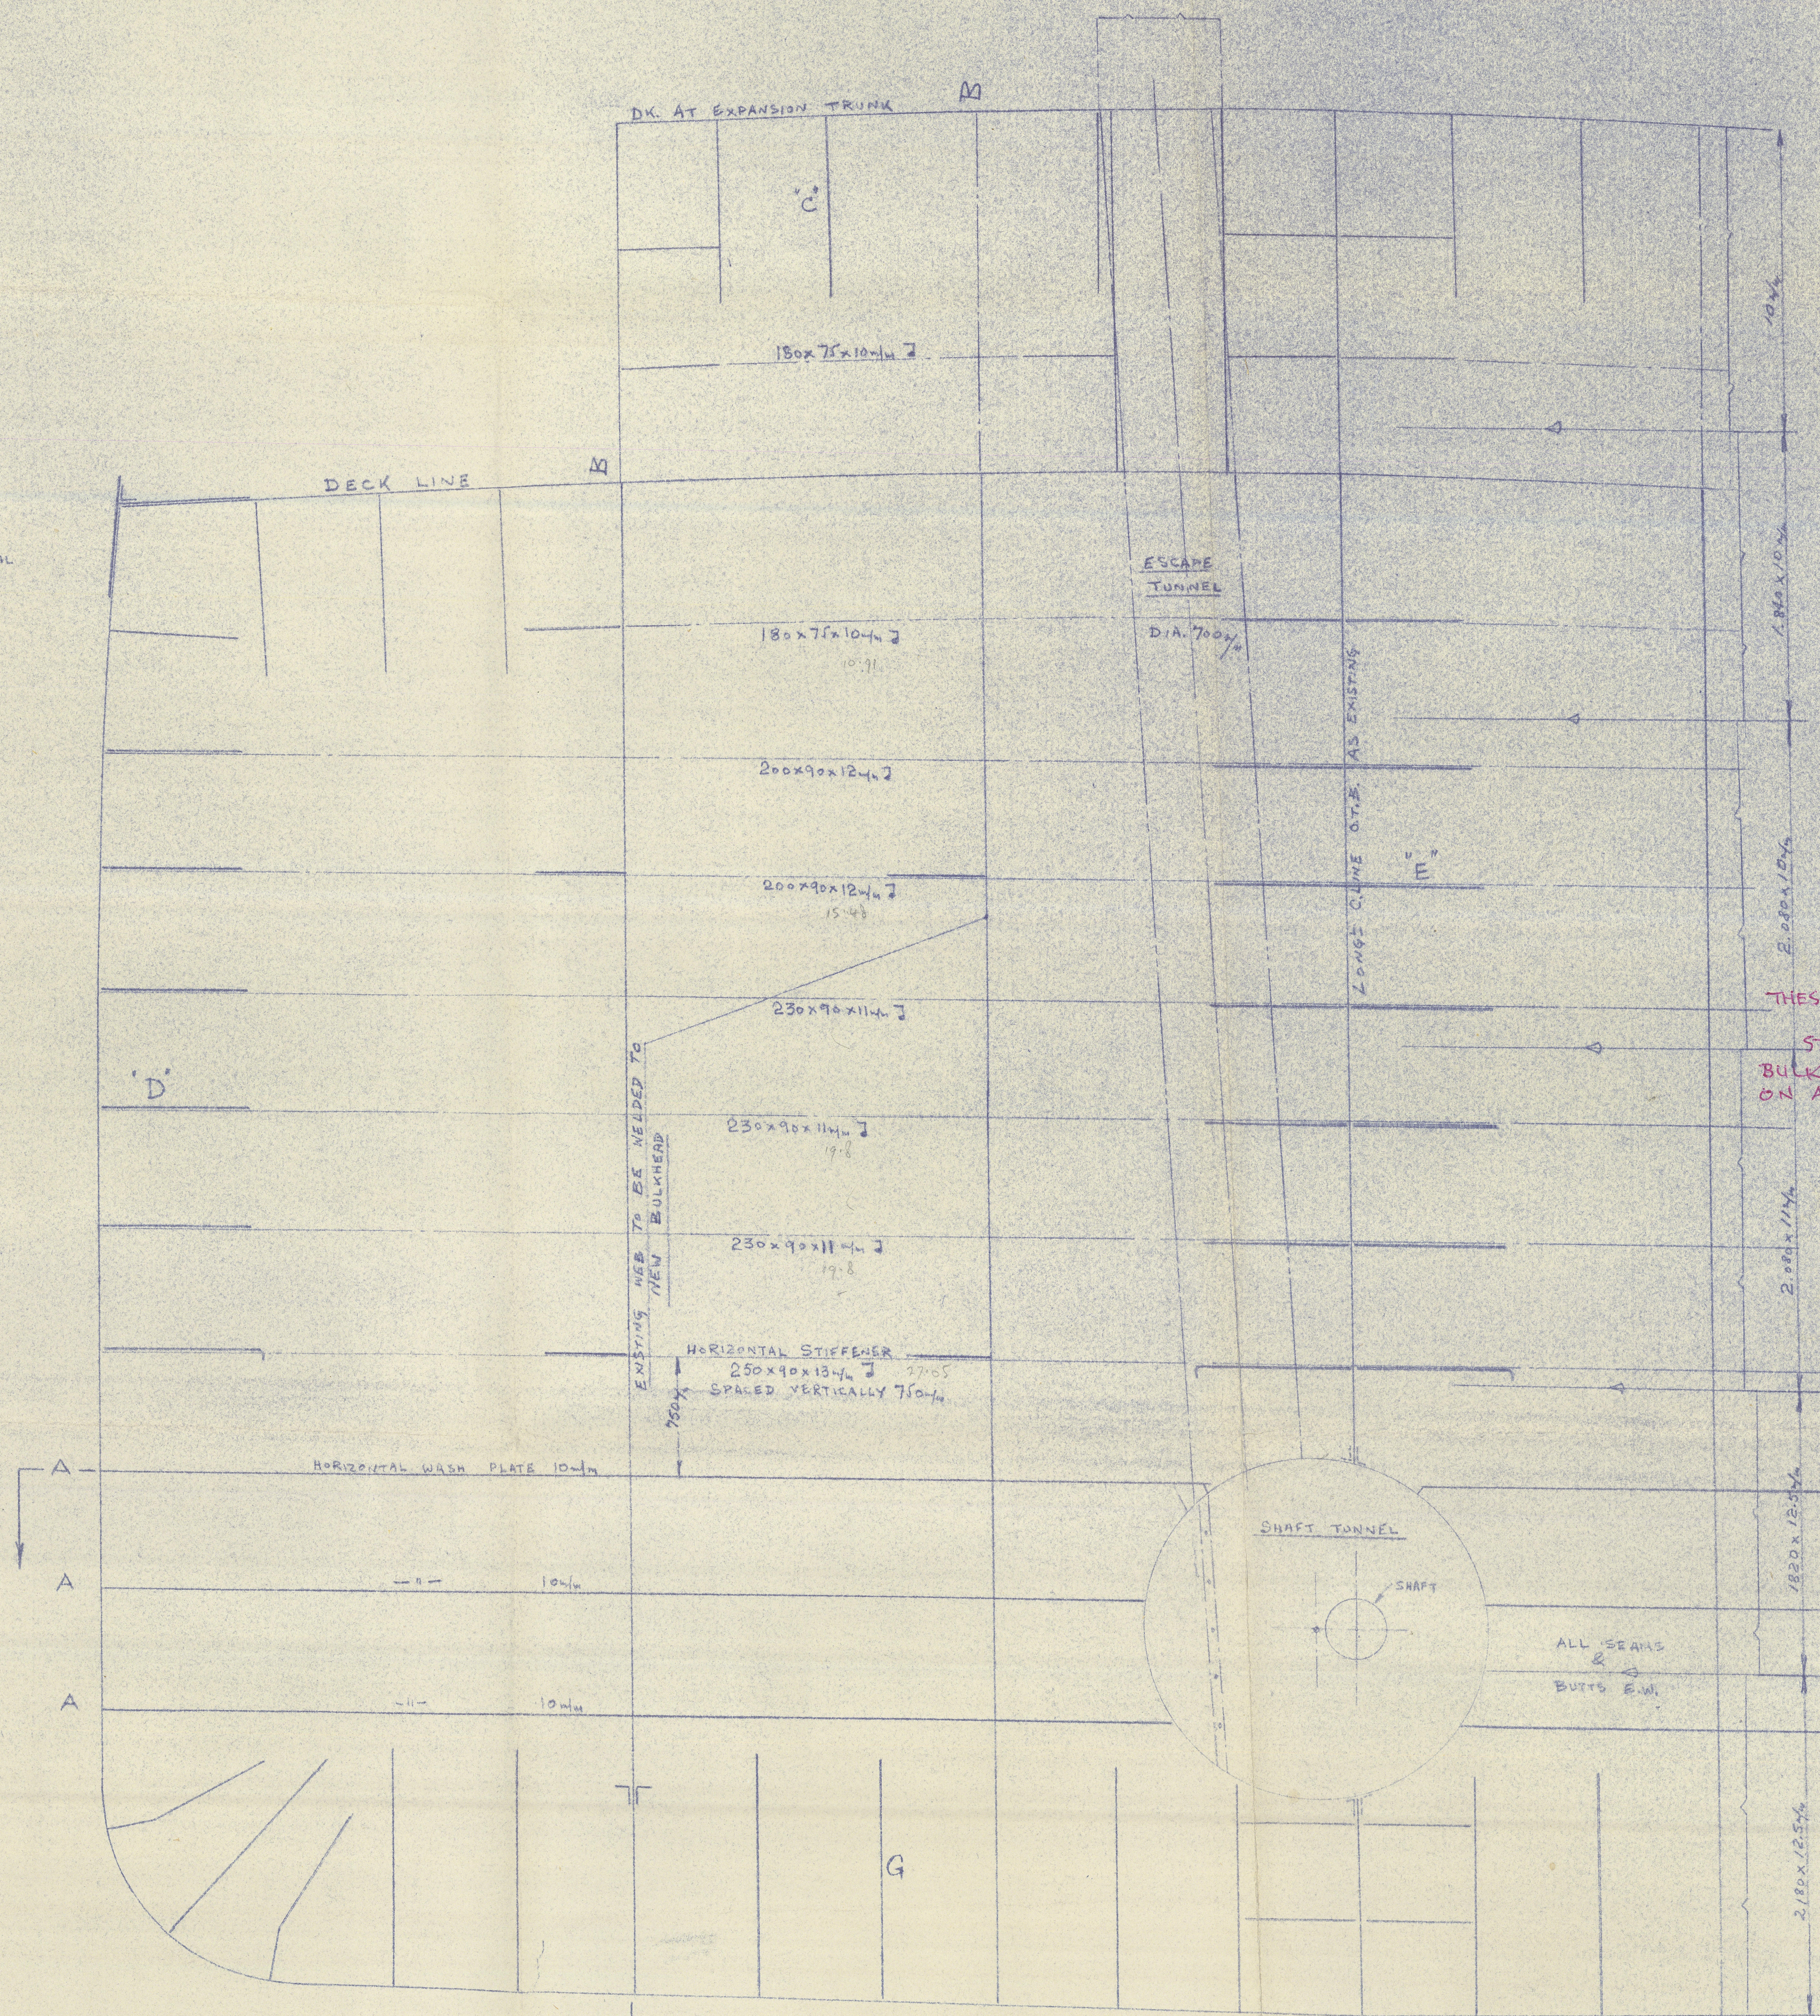

PLAN ON MAIN DECK

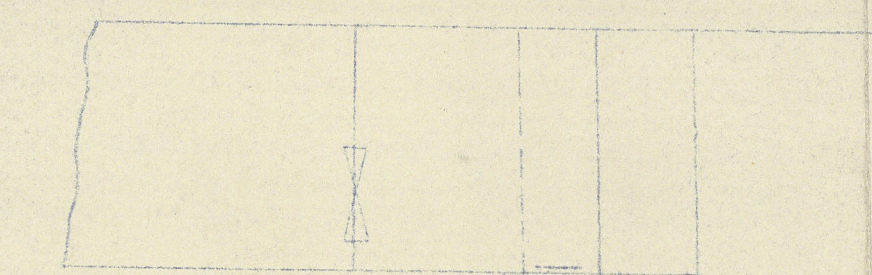

- s/s "ALEXANDROS" -
CONSTRUCTIONAL PLAN
OF COFFERDAM BHD.
SCALES: 1/2" = 1' 1/8" = 1'

PIREAS 6 OCTOBER 1956

CASTELHAIN DES

NAVAL ARCHITECT

© 2021

Lloyd's Register Foundation