
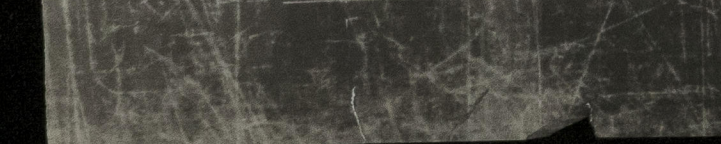



S.S. Nos 669. 70.1

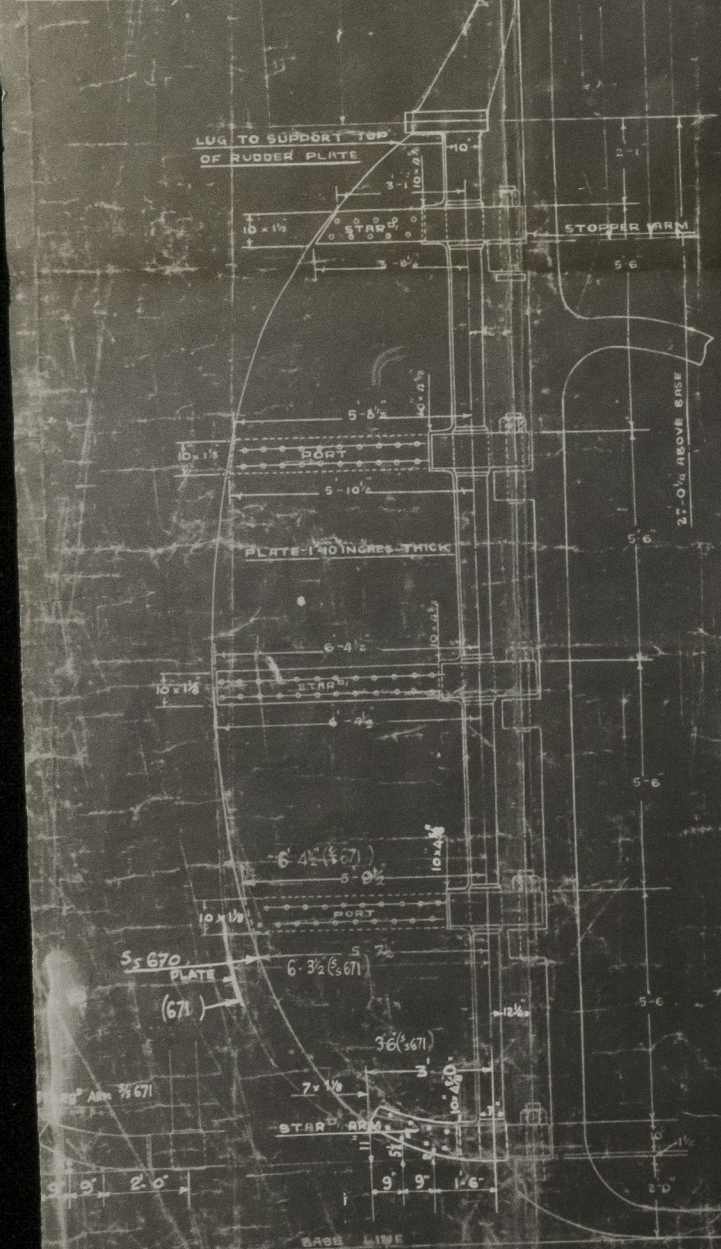

DETAIL OF PINTLES

DETAIL OF ARM

DETAIL OF STOPPER ARM

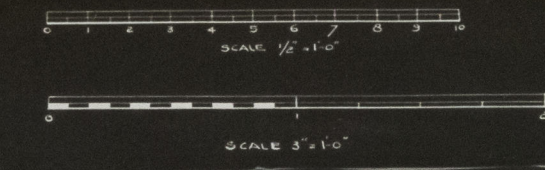

S.S. N° 669.70.1.

RUDDER PLAN

PLAN OF COUPLING

DETAIL OF BOTTOM PINTLE

PLAN OF COUPLING



Lloyd's Register

03860-009869-0209

Alexandros

ex War Rajput

Rudders ~~Longframe~~ Plan

Copy of plan obtained from Builders
by Mr Connack see letter dated 23.3.56
from Rotterdam



© 2021

Lloyd's Register
Foundation

009860-009868-0209