


SS "AARDENBURG"


EX SS "STAHLERCK"

LLL = 73,00m
B = 11,00m
THD = 5,35m
H.L.B.D. = 7,55m
T =


GEBOUWD VOLGENS GERM. LLOYD 1923

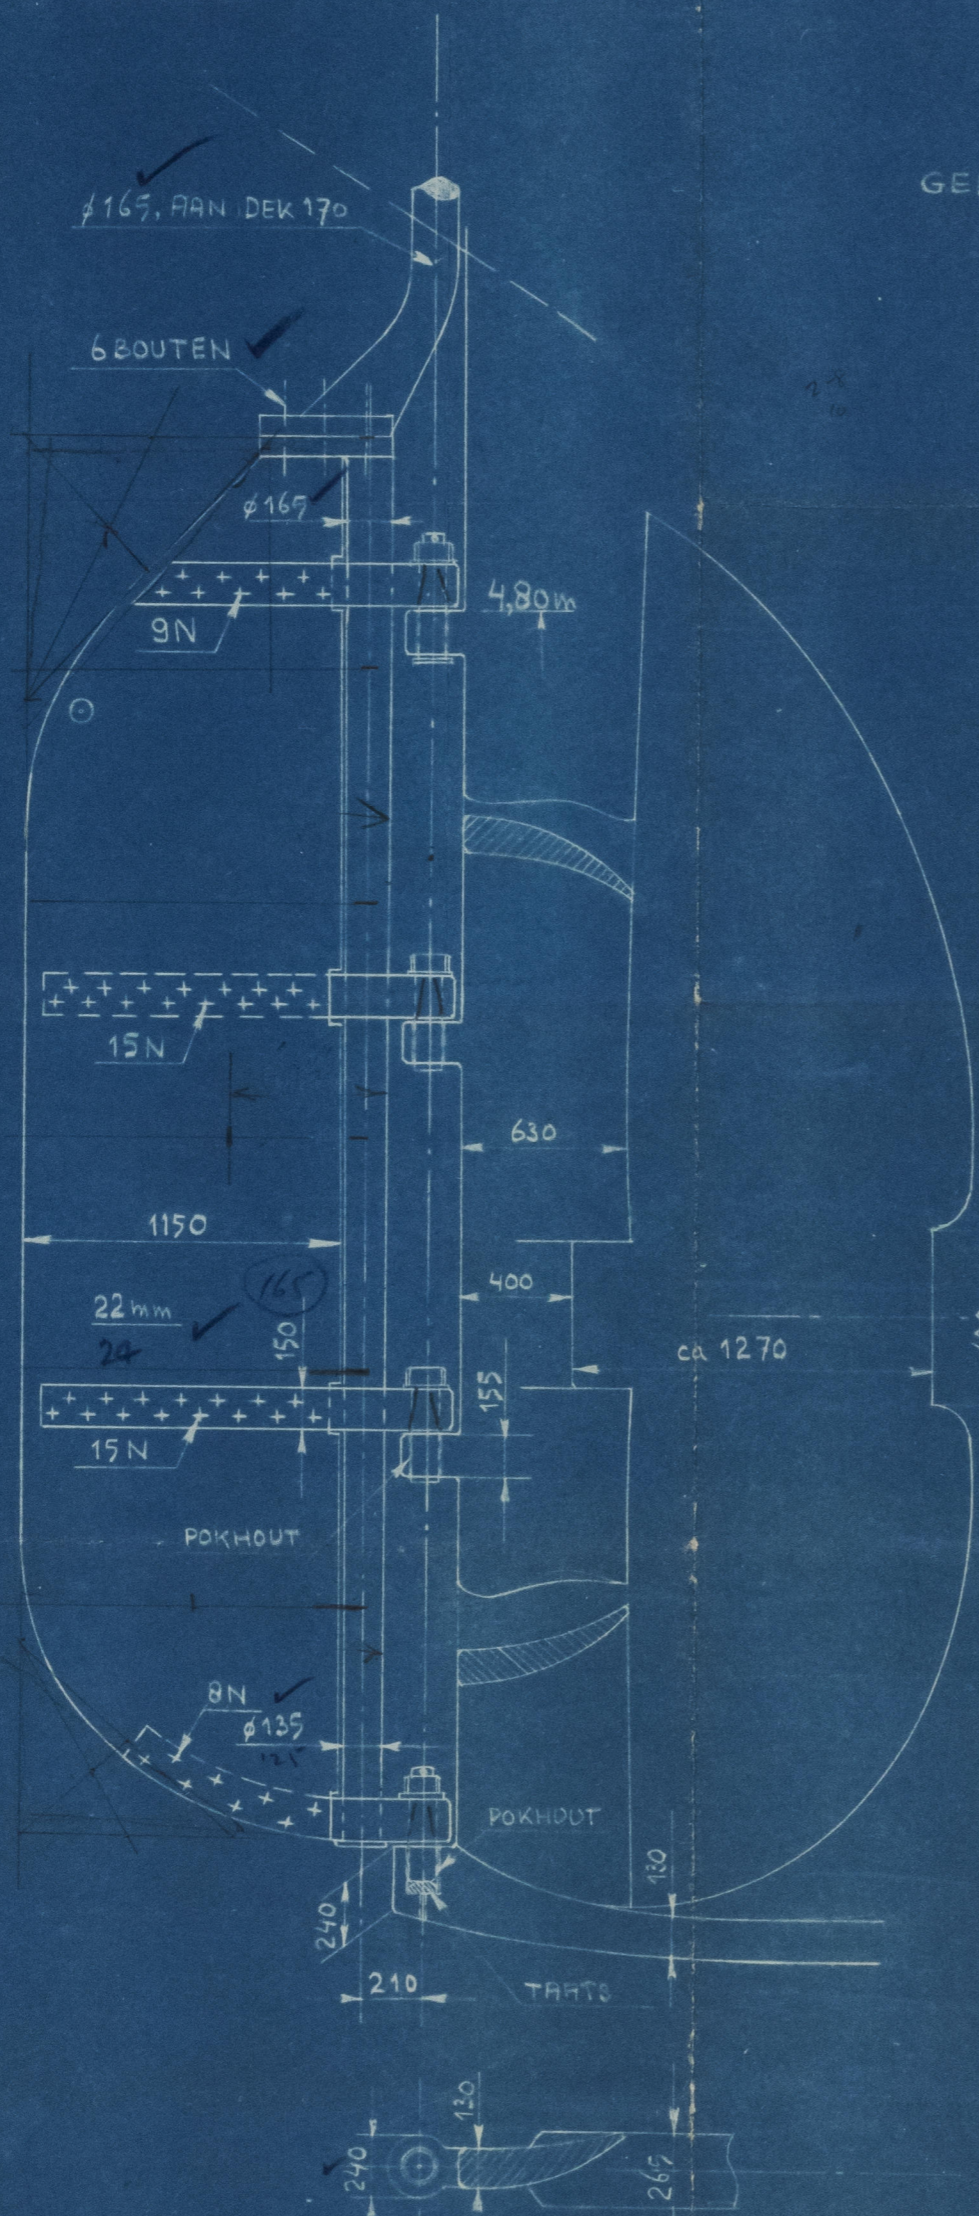

ROER PEN
1:10

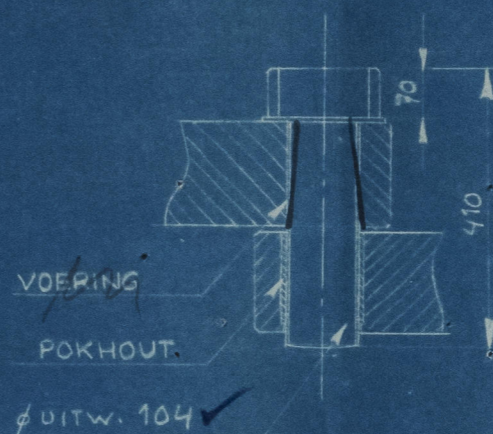

ROER ARM
1:25

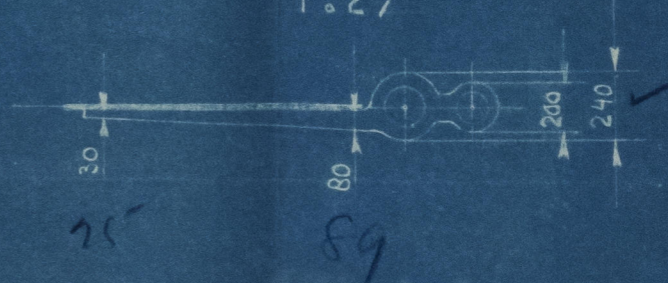

ROER 1:25
TOESTAND 1946

30 OCTOBER 1946



Lloyd's Register
Foundation

009996-009993-0060

N/N ~~DA~~ NAE

S. S. "Aardenburg"

Approved plan of
Rudder.

To accompany Amsterdam

Report No 16196 A

7



© 2021

Lloyd's Register
Foundation

009896-009903-0060



© 2021

Lloyd's Register
Foundation

AARDENBURG



© 2021

Lloyd's Register
Foundation