


DIMENSIONS:- LENGTH B.P.(L.W.L) 42'0" \* BREADTH M-LD 56'8" \* DEPTH M-LD 28'1" TO 2<sup>ND</sup> D<sup>K</sup>  
36'10" TO U<sup>PP</sup> D<sup>K</sup>

SCALE  $\frac{1}{8}'' = 1 \text{ FOOT.}$

✓ PLAN OF PILLARS, GIRDERS, HATCH END BEAMS  
& HATCHES SUBMITTED.



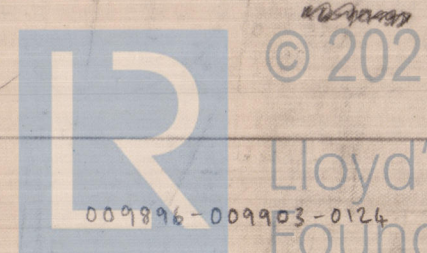


Dorlands

647

Profile + Decks

As built

'ITERSUM' - Sunderland Rpt. no. 32477.

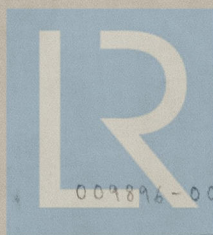

© 2021

Lloyd's Register  
Foundation