


"BENVANNOCH"

NEW RUDDER

FOR

"SAM" TYPE CARGO VESSELS.


SPEED NOT EXCEEDING 12 KNOTS.

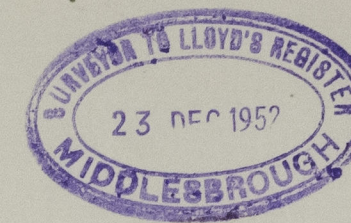


AS FITTED IN RED

PLAN VIEW OF COUPLING

ELEVATION OF COUPLING

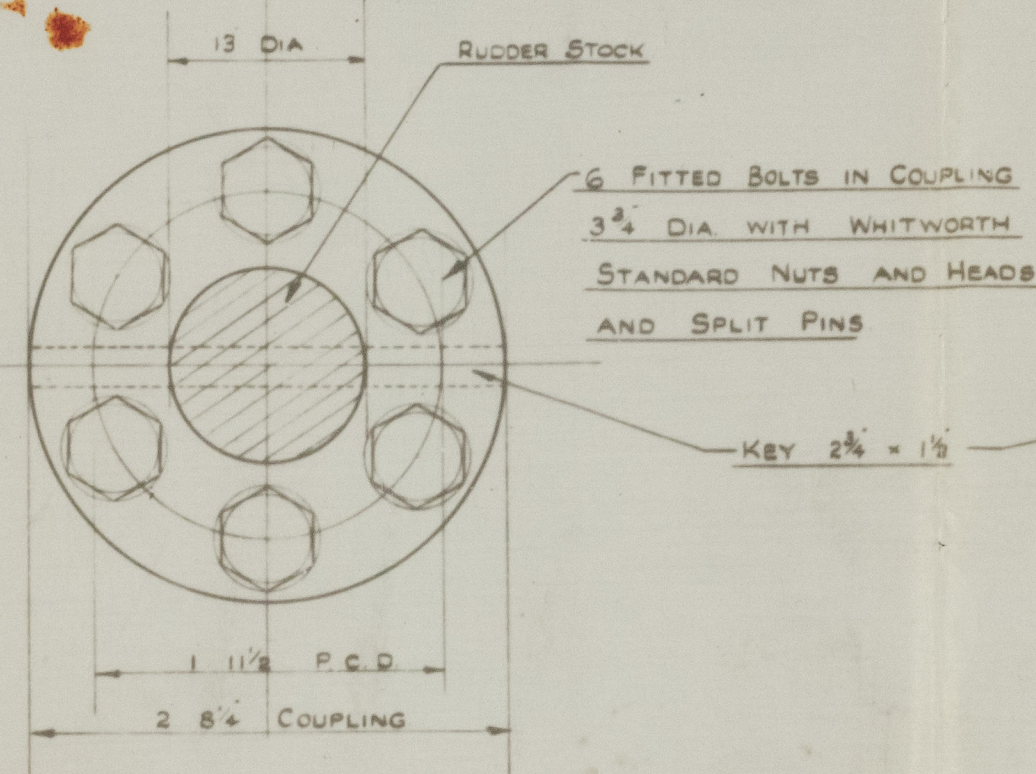

SECTION THROUGH RUDDER

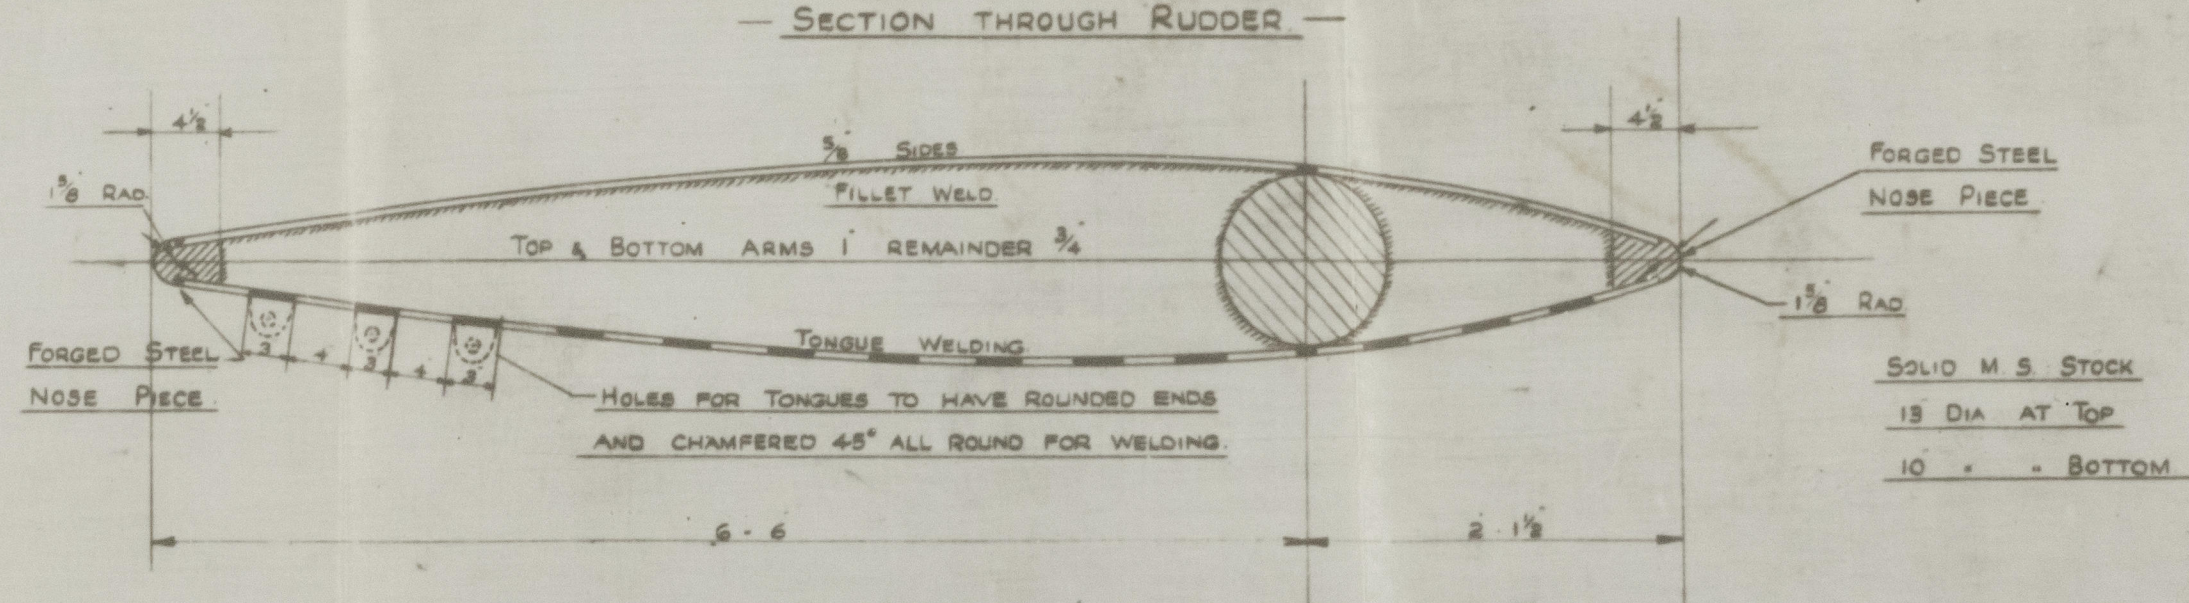

NOTE:- RUDDER TO BE FILLED WITH BITUMINOUS SOLUTION UP TO REQUIRED TEST PRESSURE, AFTER WHICH THE BITUMINOUS SOLUTION IS RUN OFF THROUGH THE DRAIN PLUG LEAVING THE INSIDE OF THE RUDDER HEAVILY COATED WITH SOLUTION.

N.A. 739

13.10.57

Handwritten signature: L. L. L.

Bennanoch
New Rudder

MIDDLESBROUGH
REPORT No. 19796



© 2021

Lloyd's Register
Foundation

009896-009903-0309