


Nº 632.

# TANK TOP, ORLOP & MAIN DECKS.

SCALE  $\frac{1}{8}'' = 1$  FOOT.

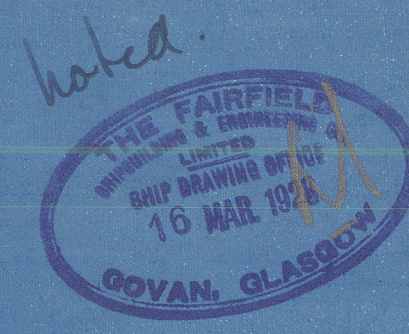

MAIN DECK.

MAIN DECK.

ORLOP DECK.


ORLOP DECK.

TANK TOP

TANK TOP



APPROVED  
LLOYD'S REGISTER OF SHIPPING  
9. 2. 28

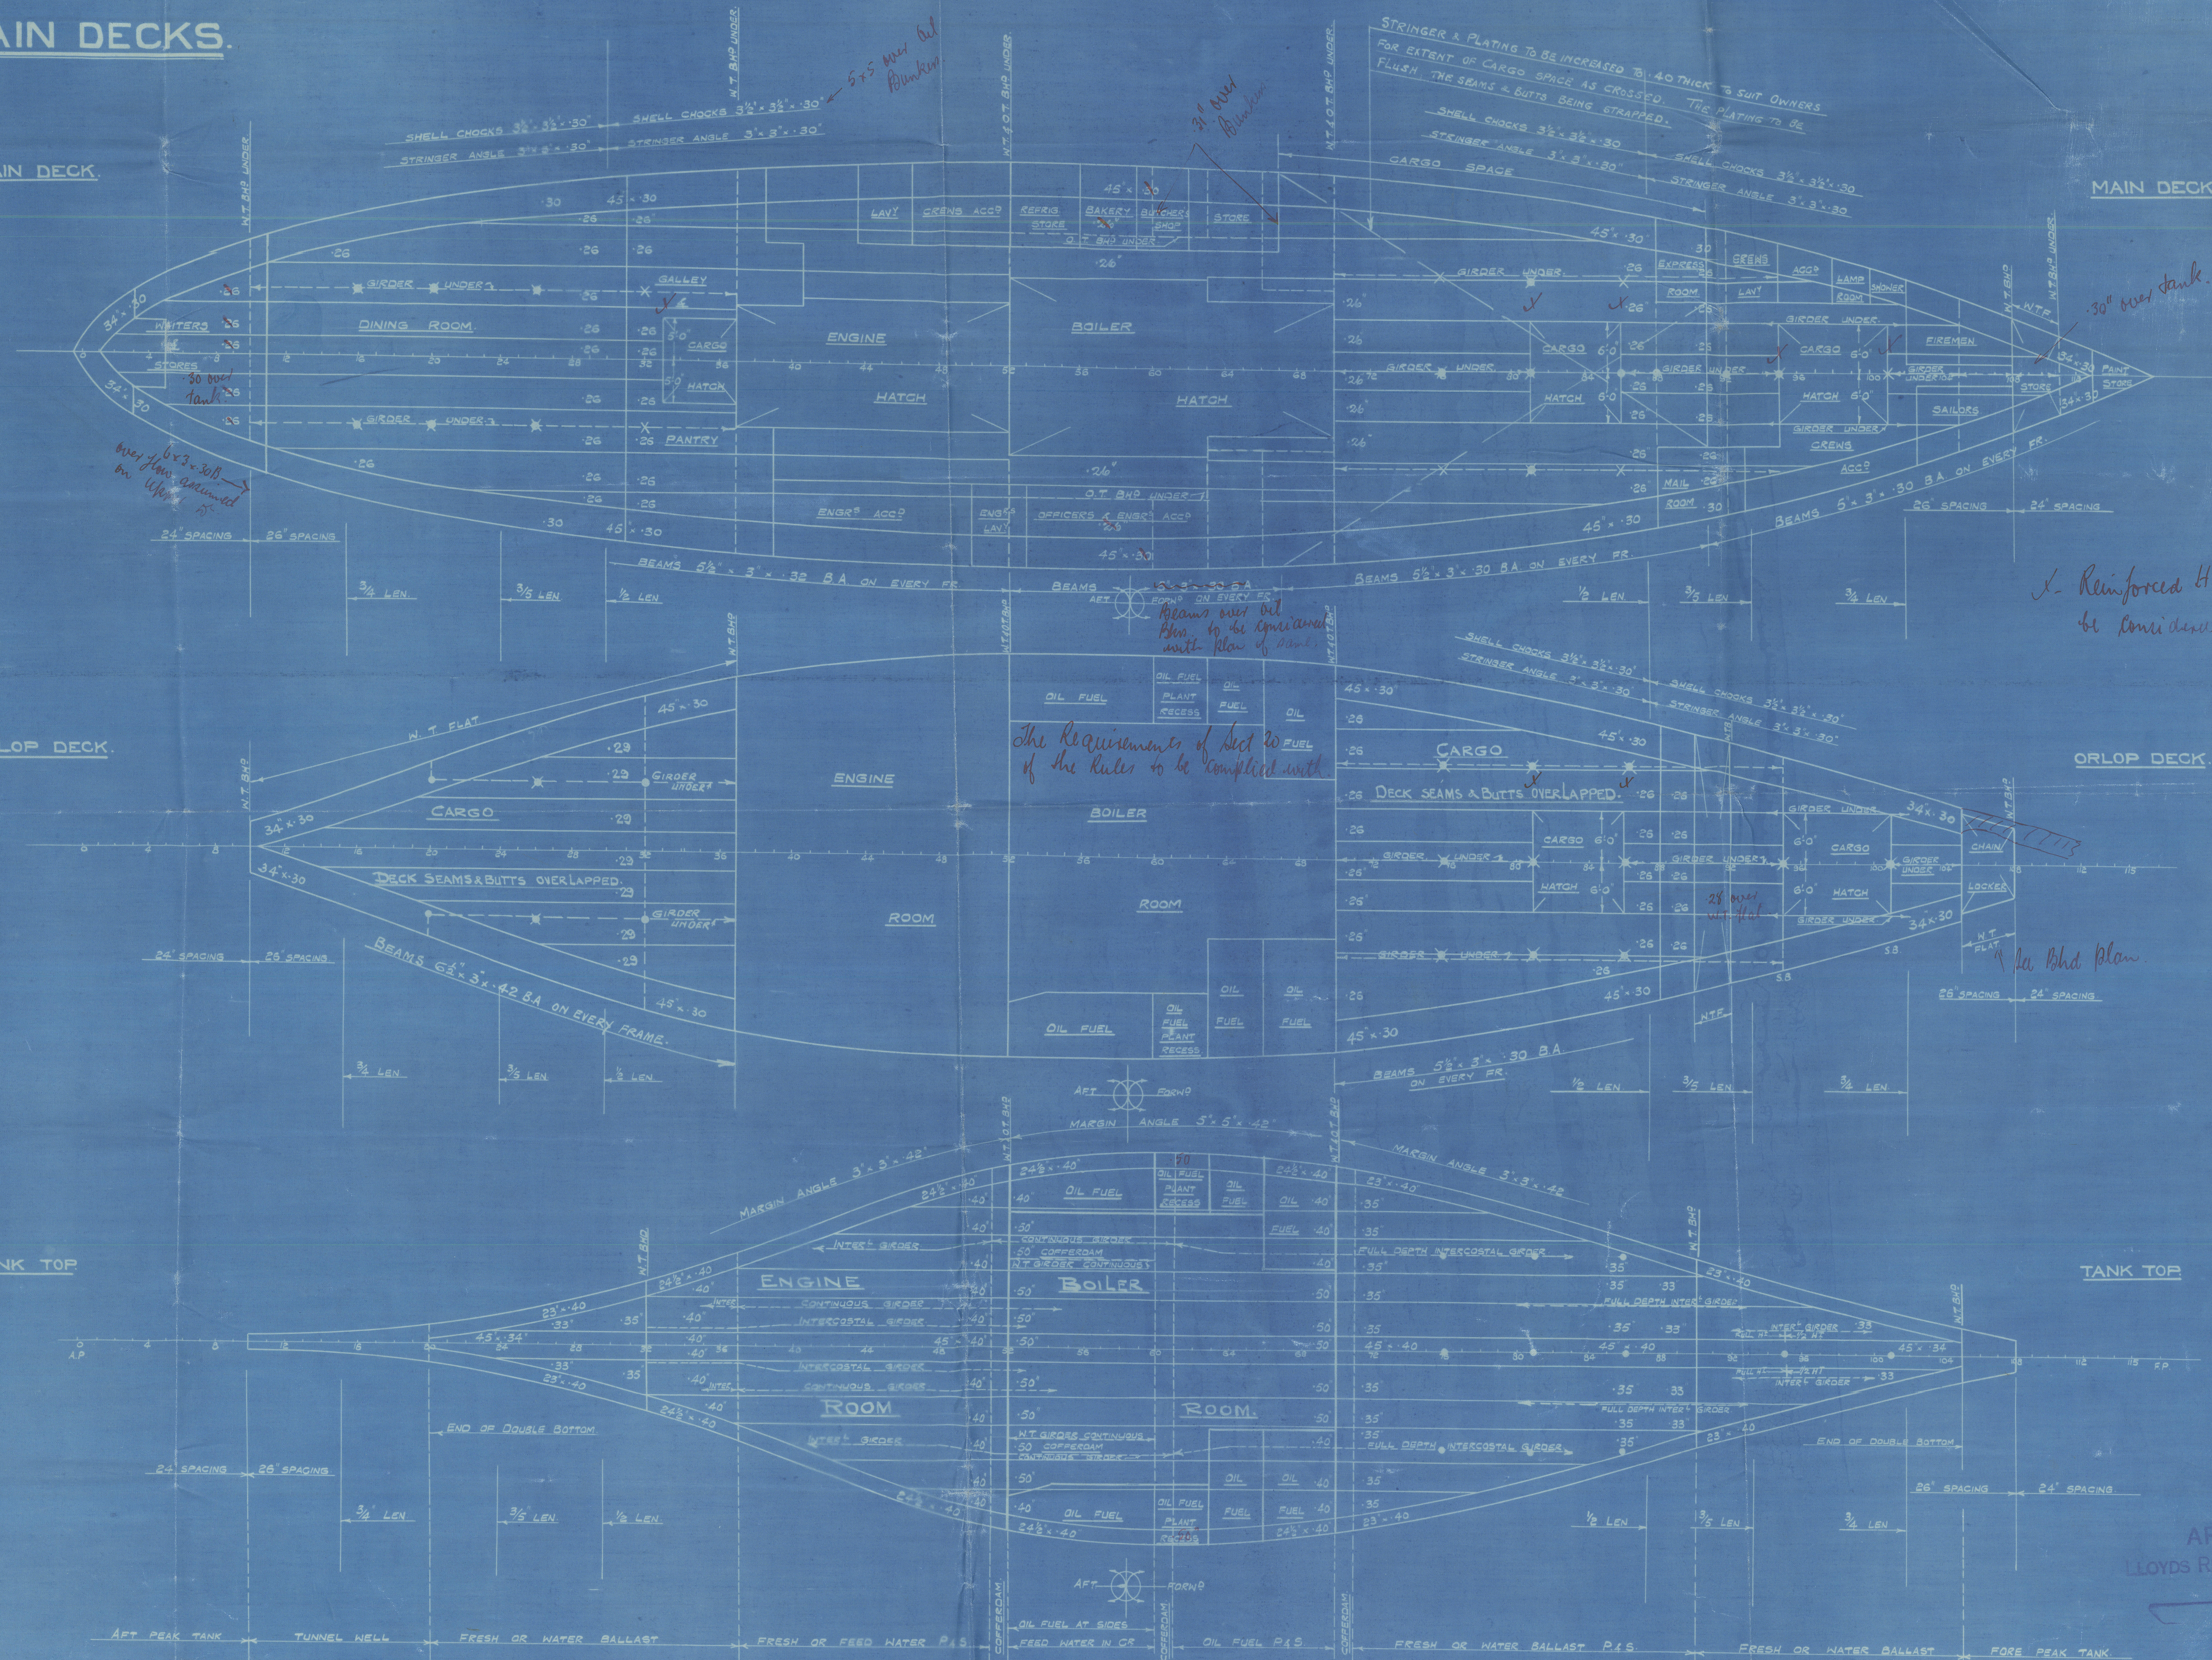



N<sup>o</sup>. 632


Tank top. Orlon.

Wan Ax

Fairfield S.B. & Co

---

Princess Norah  
GLASGOW REPORT No 48624

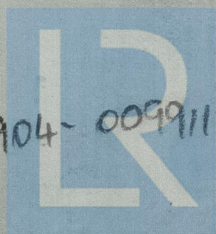

© 2021

009904-009911-0260

Lloyd's Register  
Foundation