
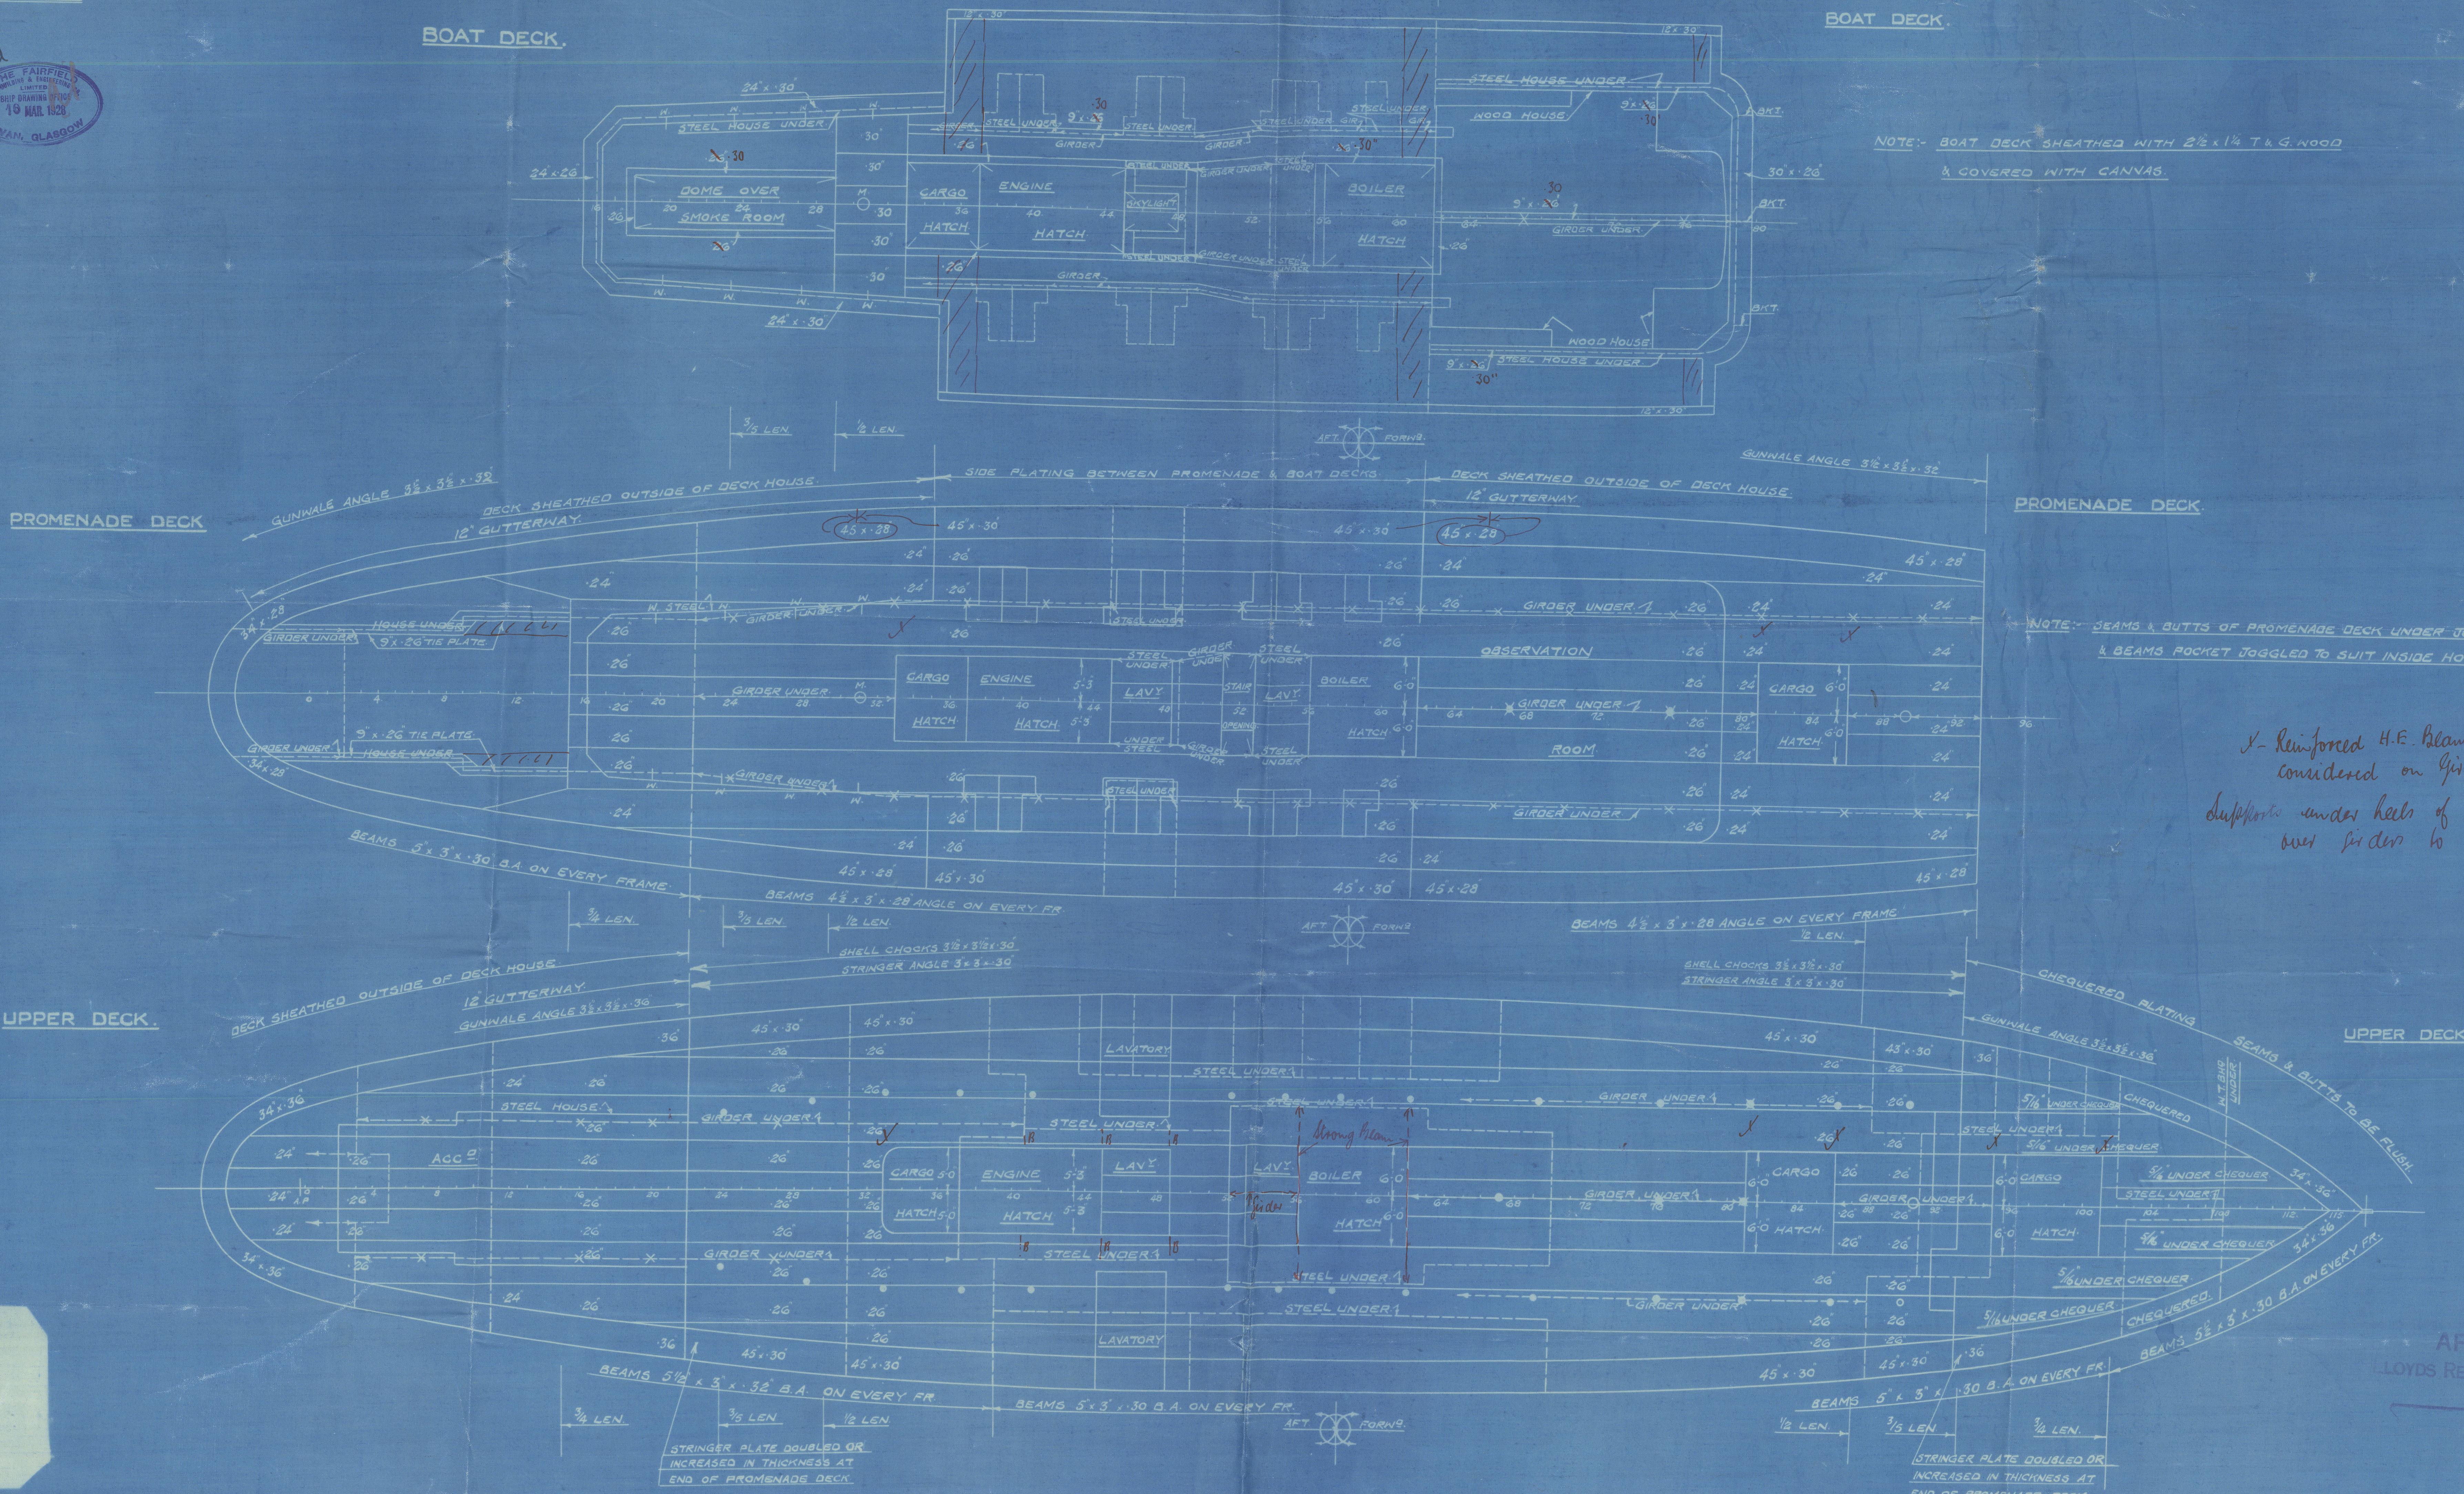


Nº 632.

UPPER, PROMENADE & BOAT DECKS.


SCALE  $\frac{1}{8}" = 1 \text{ FOOT.}$

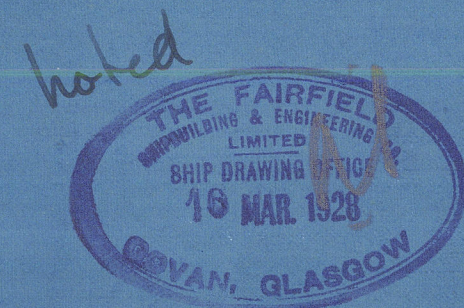

NOTE:- BOAT DECK SHEATHED WITH  $2\frac{1}{2} \times 1\frac{1}{4}$  T. & G. WOOD & COVERED WITH CANVAS.

NOTE:- BEAMS & BUTTS OF PROMENADE DECK UNDER JOGGLED & BEAMS POCKET JOGGLED TO SUIT INSIDE HOUSE FRG 16-79

X- Reinforced H.F. Beams to be considered on Girders plan.  
Supports under heels of pillars not directly over girders to be considered on Girders plan.

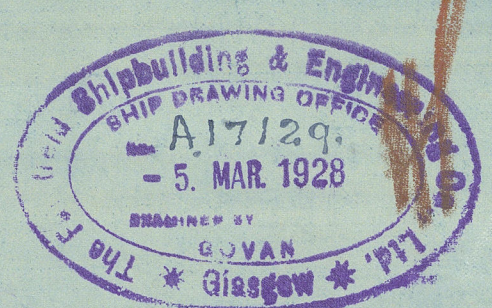

APPROVED  
LLOYD'S REGISTER OF SHIPPING  
9. 3. 28



N<sup>o</sup>. 632.

Upper Room Room Dk


Fanfield S B & Co

---

Princess Norah

GLASGOW REPORT No 48624

009904-009911-0261

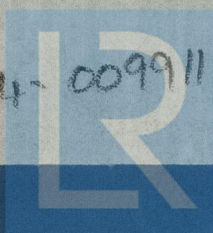

© 2021

Lloyd's Register  
Foundation