

MIDSHIP SECTION

DIMENSIONS.

LENGTH B.P. 225'0" BREADTH EX. 35'0" DEPTH MID. 16'6"

TO CLASS 100-A1 AT LLOYD'S. "RAISED QUARTER DECK"

1/2 SCALE.

19.10.00
15.12.00
9.8.01

LENGTH 140' AFTER SIDE OF STEER TO FORE SIDE OF STERN POST.
BREADTH MOULDED.
DEPTH TO SKIN ASSUMING 3/4" ROUND UP OF BEAM.

225'8 1/2"
34'9"
17'3 3/4"

NUMERALS.

1/2 BREADTH 17'37"
1/2 GIRTH 31'79"
DEPTH 17'27"

66'43" 1/2 N° GRADES 65 68, +3'5" 69'93" N° FOR Q.R. DK. FRAMES 4°

225'71" LLOYD'S LENGTH

14861' 2° N° GRADES 14700-15600.


DEPTH TO LENGTH 12'95"

BREADTH TO LENGTH 6'44"

EQUIPMENT

ERECTORIALS: - RAISED Q.R. DK. 82'5" BRIDGE 55' T. RAISED Q.R. DK. FOR 85' 2 1/2"

EQUIPMENT N° 16718 GRADES 15120-16720.

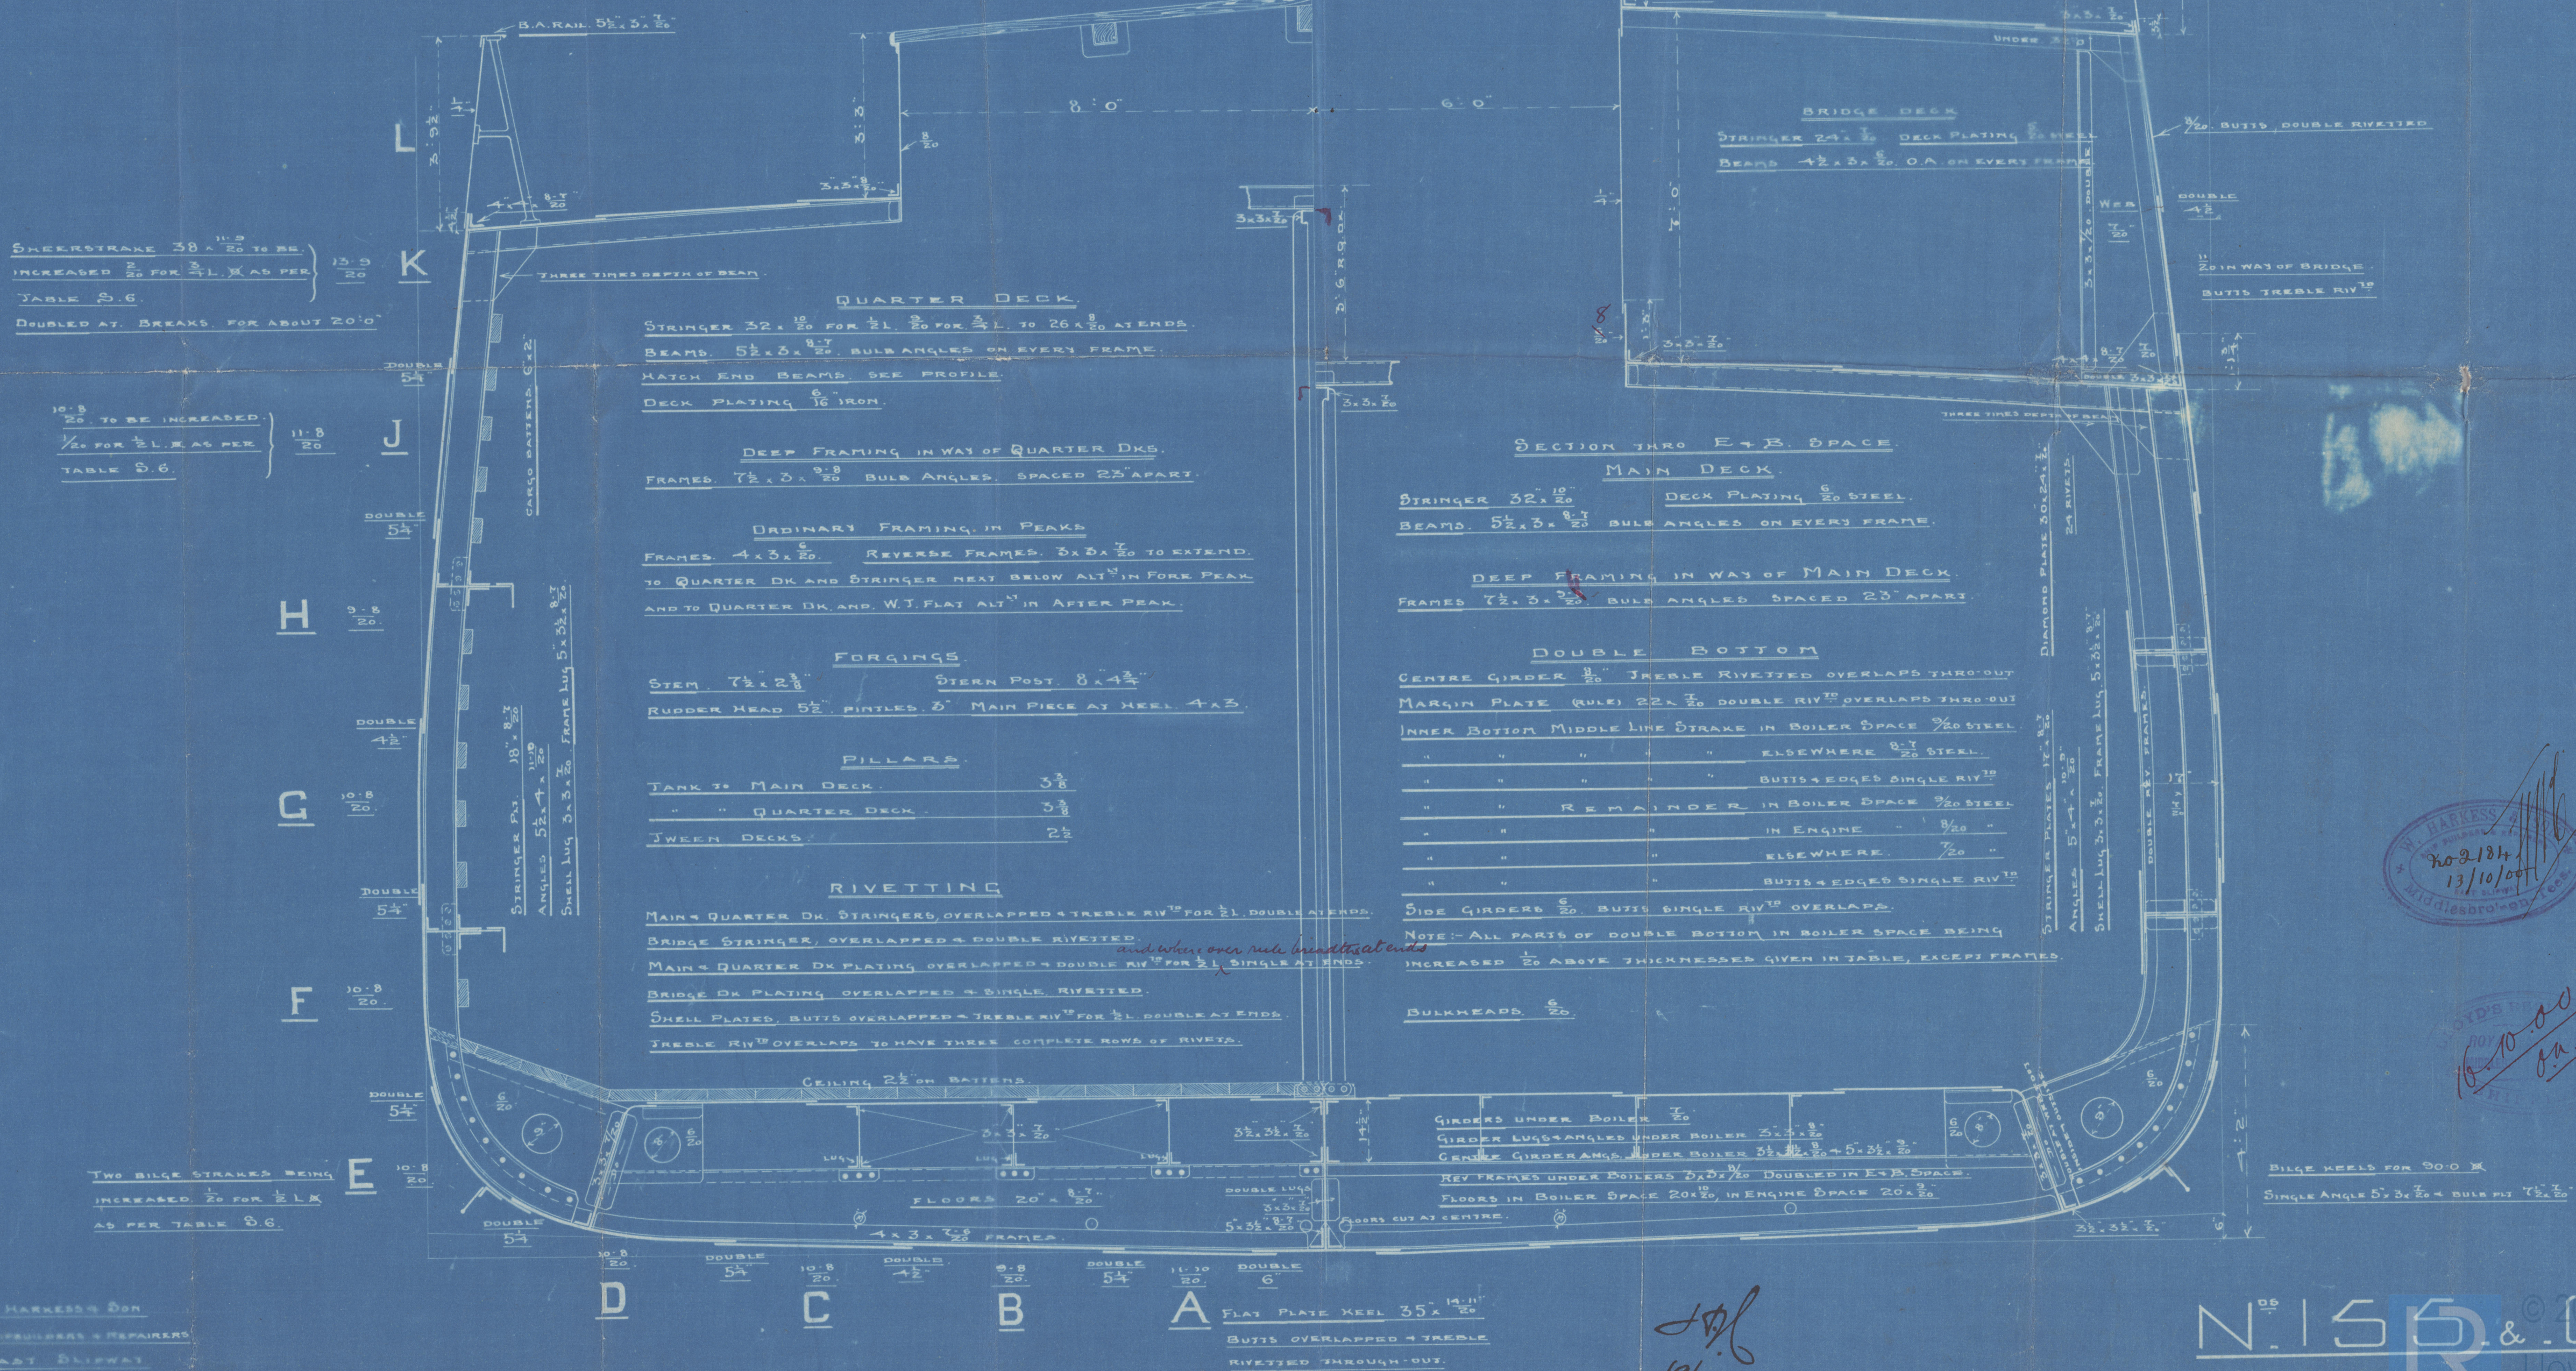

no 2184
13/10/00
HARVEY
MIDDLESBROUGH

19.10.00
O.A.

HARVEY'S DON
SHEDDERS & REPAIRERS
EAST BLIWAY
MIDDLESBROUGH-ON-TEES

FLAT PLATE KEEL 35' 14 1/2"
BUTTS OVERLAPPED & TREBLE
RIVETTED THROUGH-OUT.


N.156 & G.

609912-009914-009916


Misship Section

W. H. Kess & Son

no 155 & 156

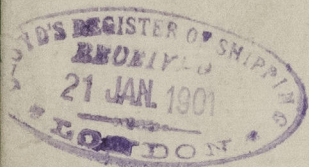

S. Gidalian (155)
Mab Report. no 3178.

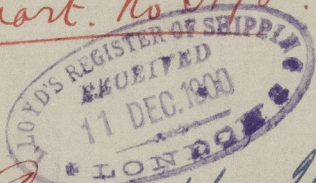

of a Coraman ^{W. H. Kess} (156)
Rob. Y. C. Apt N° 3524



PLANS TRANSFERRED
TO SISTER VESSEL

Elham



Dis/
Bon

100 Top

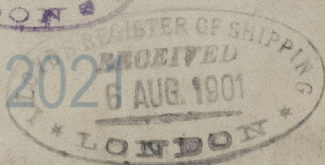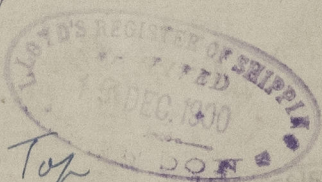

© 2021

Lloyd's Register
Foundation

2700-166-26600
009912-009919-0046