


P L A N

STRINGER ARRANGEMENT

1/4" SCALE

(Fitted with a view to reduction of snubboard)

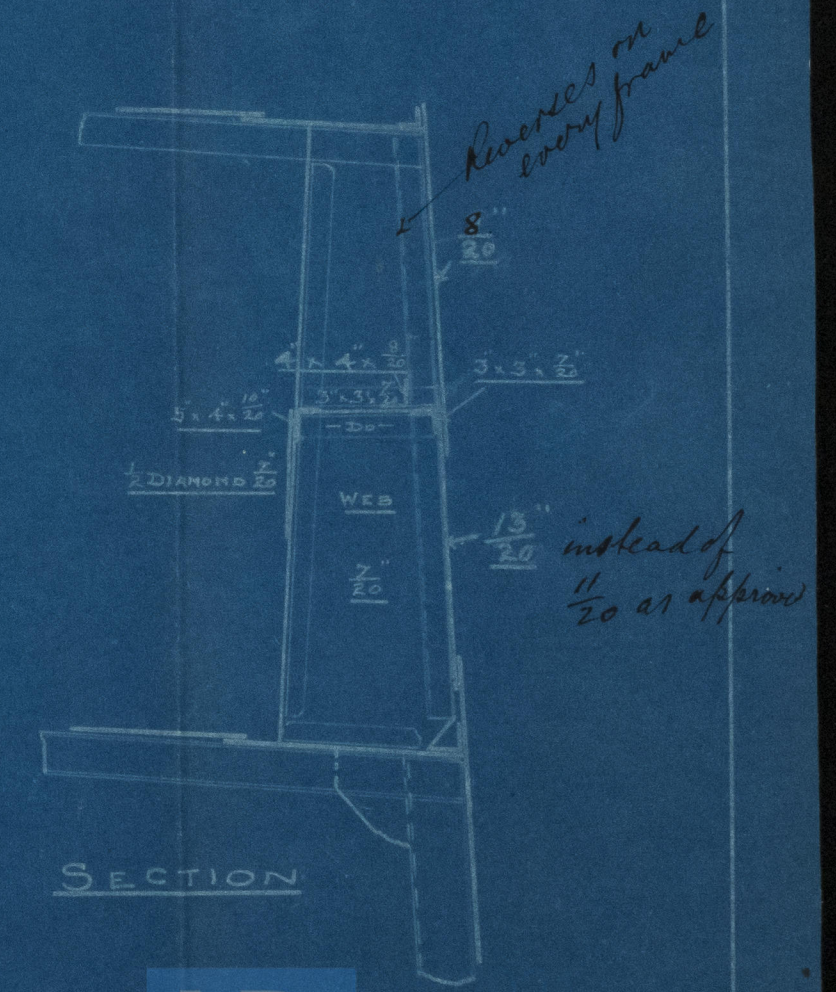

SECTION

3-8-01  
W. J. [Signature]

N<sup>o</sup> 155 5/8" "Goidelian"

No 2332  
3/8/01

LR

Lloyd's Register


509912-009419-0047



A. Harkess & Son

No 155

Boat strengthening  
in way of Bridge

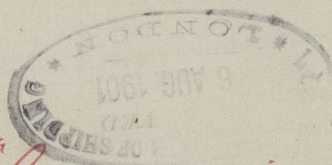

S.S. Goldelian  
Mab Report to 3178.

PLANS TRANSFERRED  
TO SISTER VESSEL

Ilham  
Dip 100  
Bm Top



© 2021

Lloyd's Register  
Foundation

004912-09919-047