

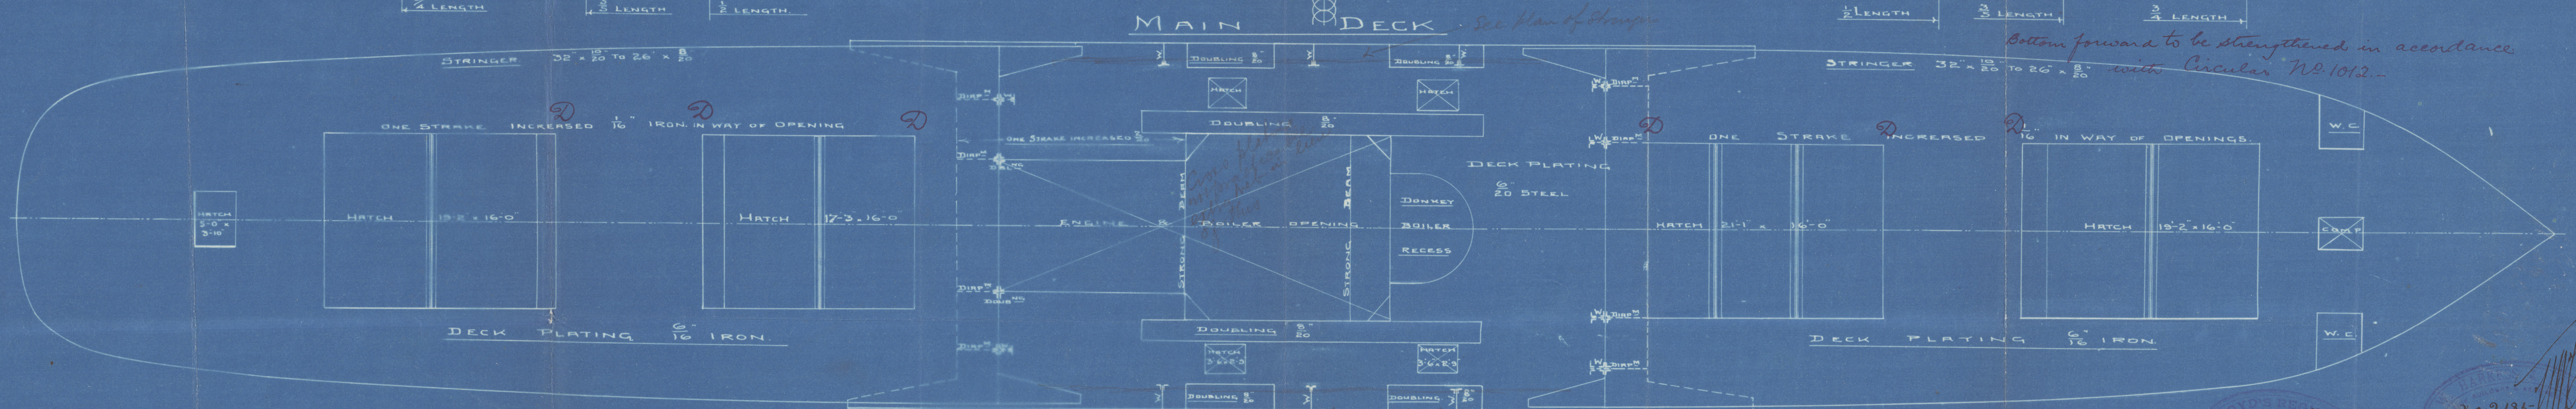


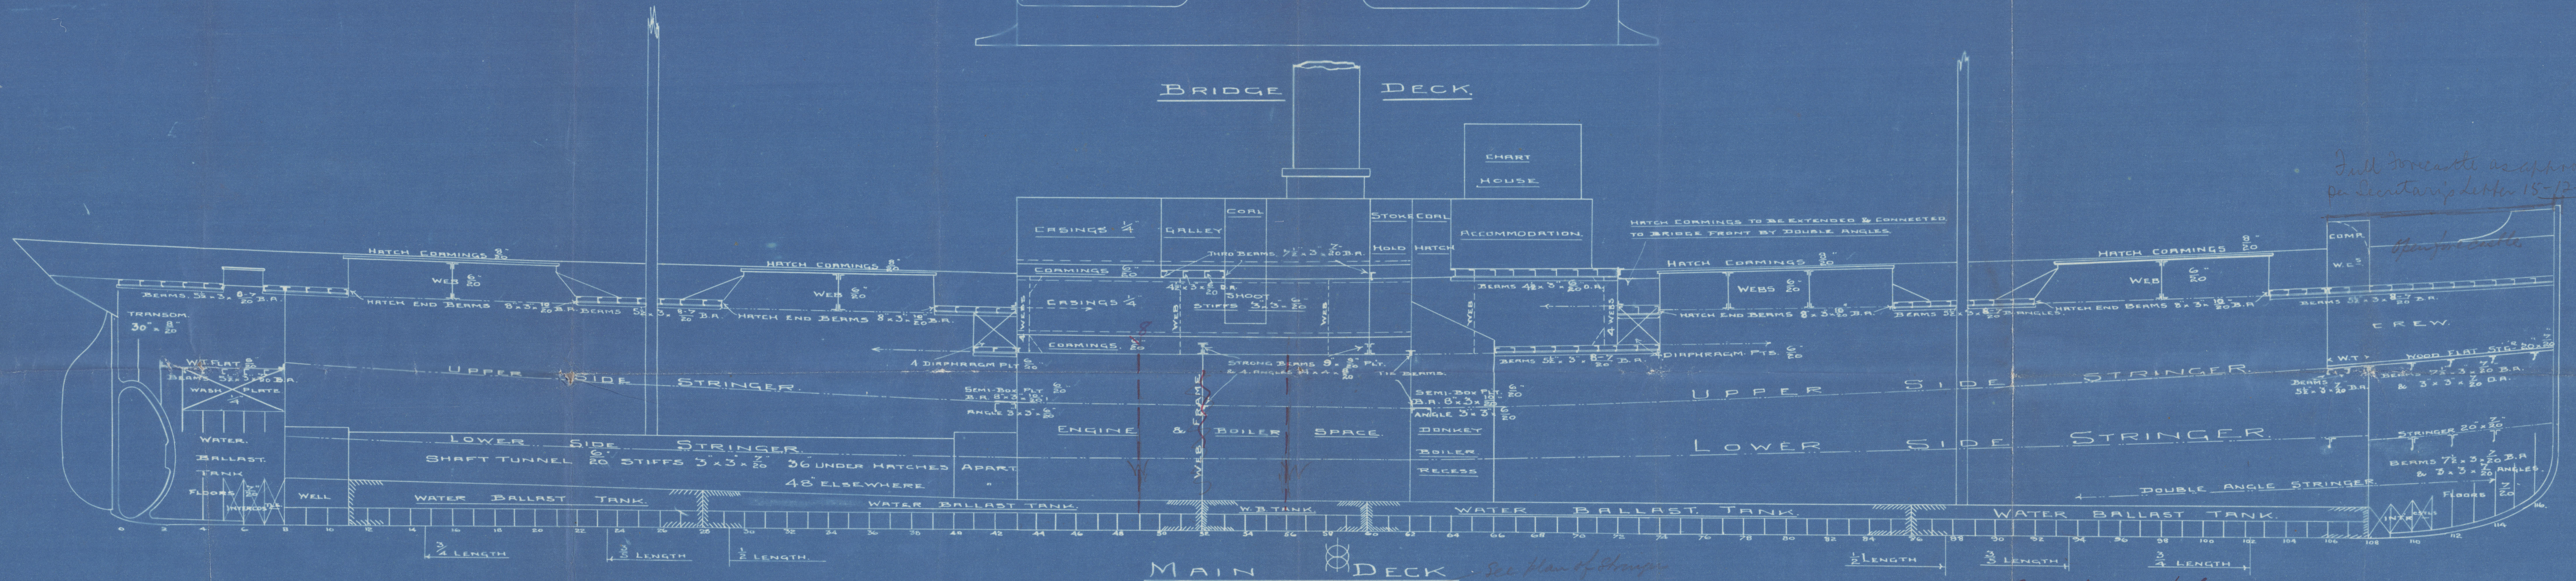

19.10.00
15.12.00
21.1.01

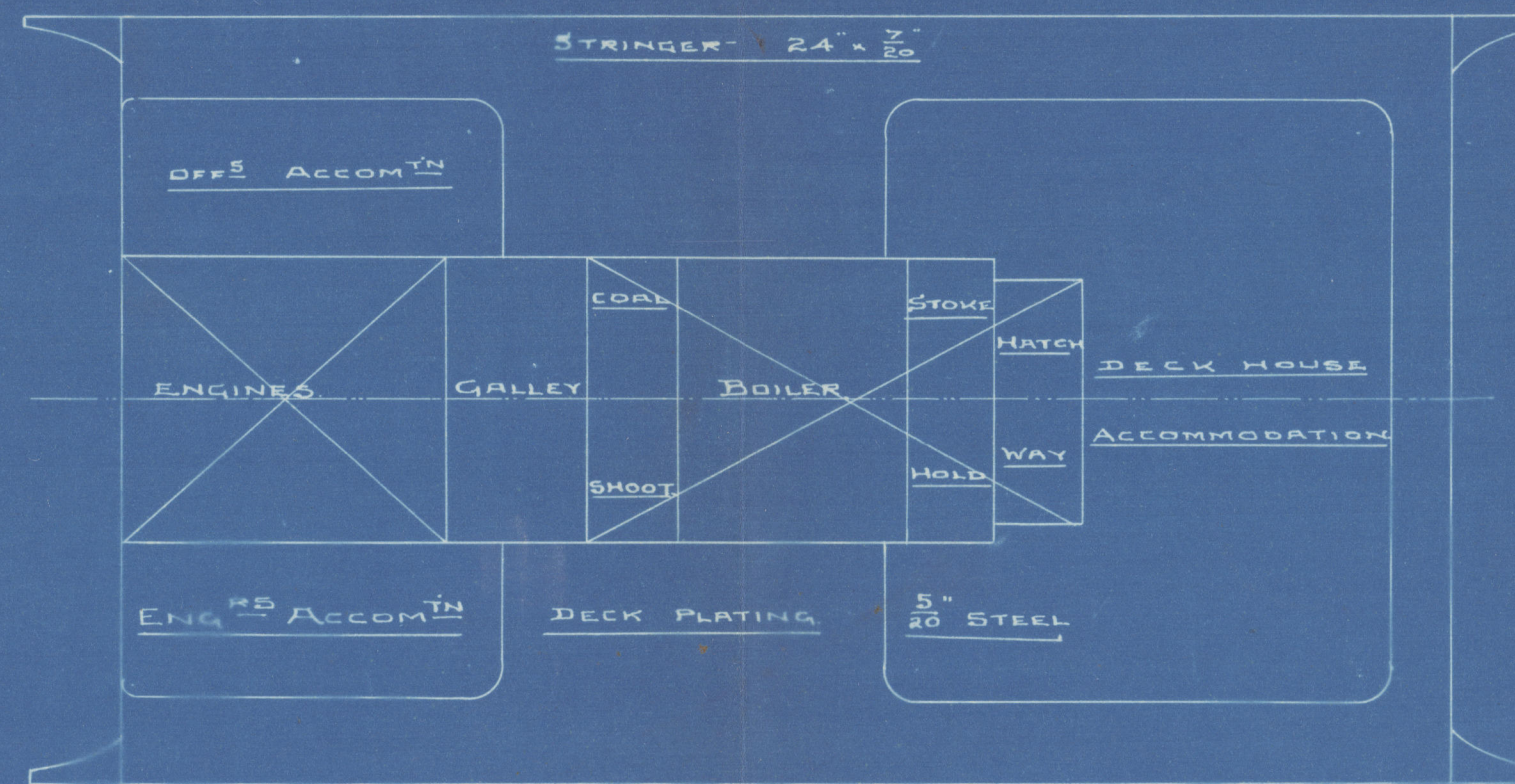

W^d HARRISS & SON
SHIPBUILDERS & REPAIRERS
EAST SLIPWAY
MIDDLESBROUGH - ON-TEES

QUARTER DECK AFT

PROFILE & DECK PLANS

LENGTH B.P. 225'0" BREADTH EX. 35'0" DEPTH M^d 16'6 1/2"
TO CLASS 100 A.I. AT LLOYD'S "RAISED QUARTER DECK"
1/8" SCALE.

QUARTER DECK FWD

N 155 & 6

16.10.00
OK






17.10.00

Lloyd's Register
Foundation

Profile & Deck Plans.

W. Stankens & Sons.

nos. 155 and 156.

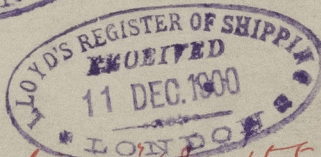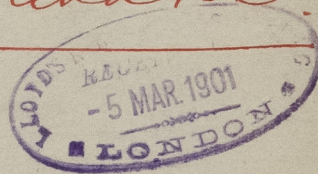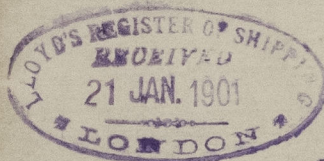


S.S. Griselian (No. 155.)
Mach. Report. No 3178



PLANS TRANSFERRED
TO SISTER VESSEL

Ilham

Dis 100
Box 704

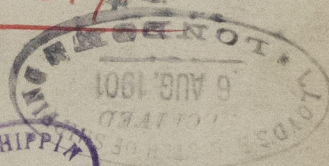

sp. "Coramian" (No. 156)
Mach. F.E. Rpt No 3224

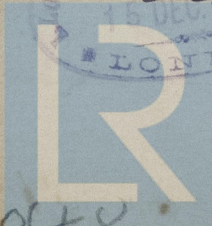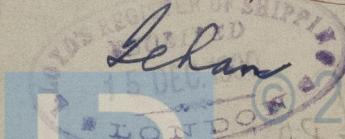

Lloyd's Register
Foundation

004912-009919-0048