

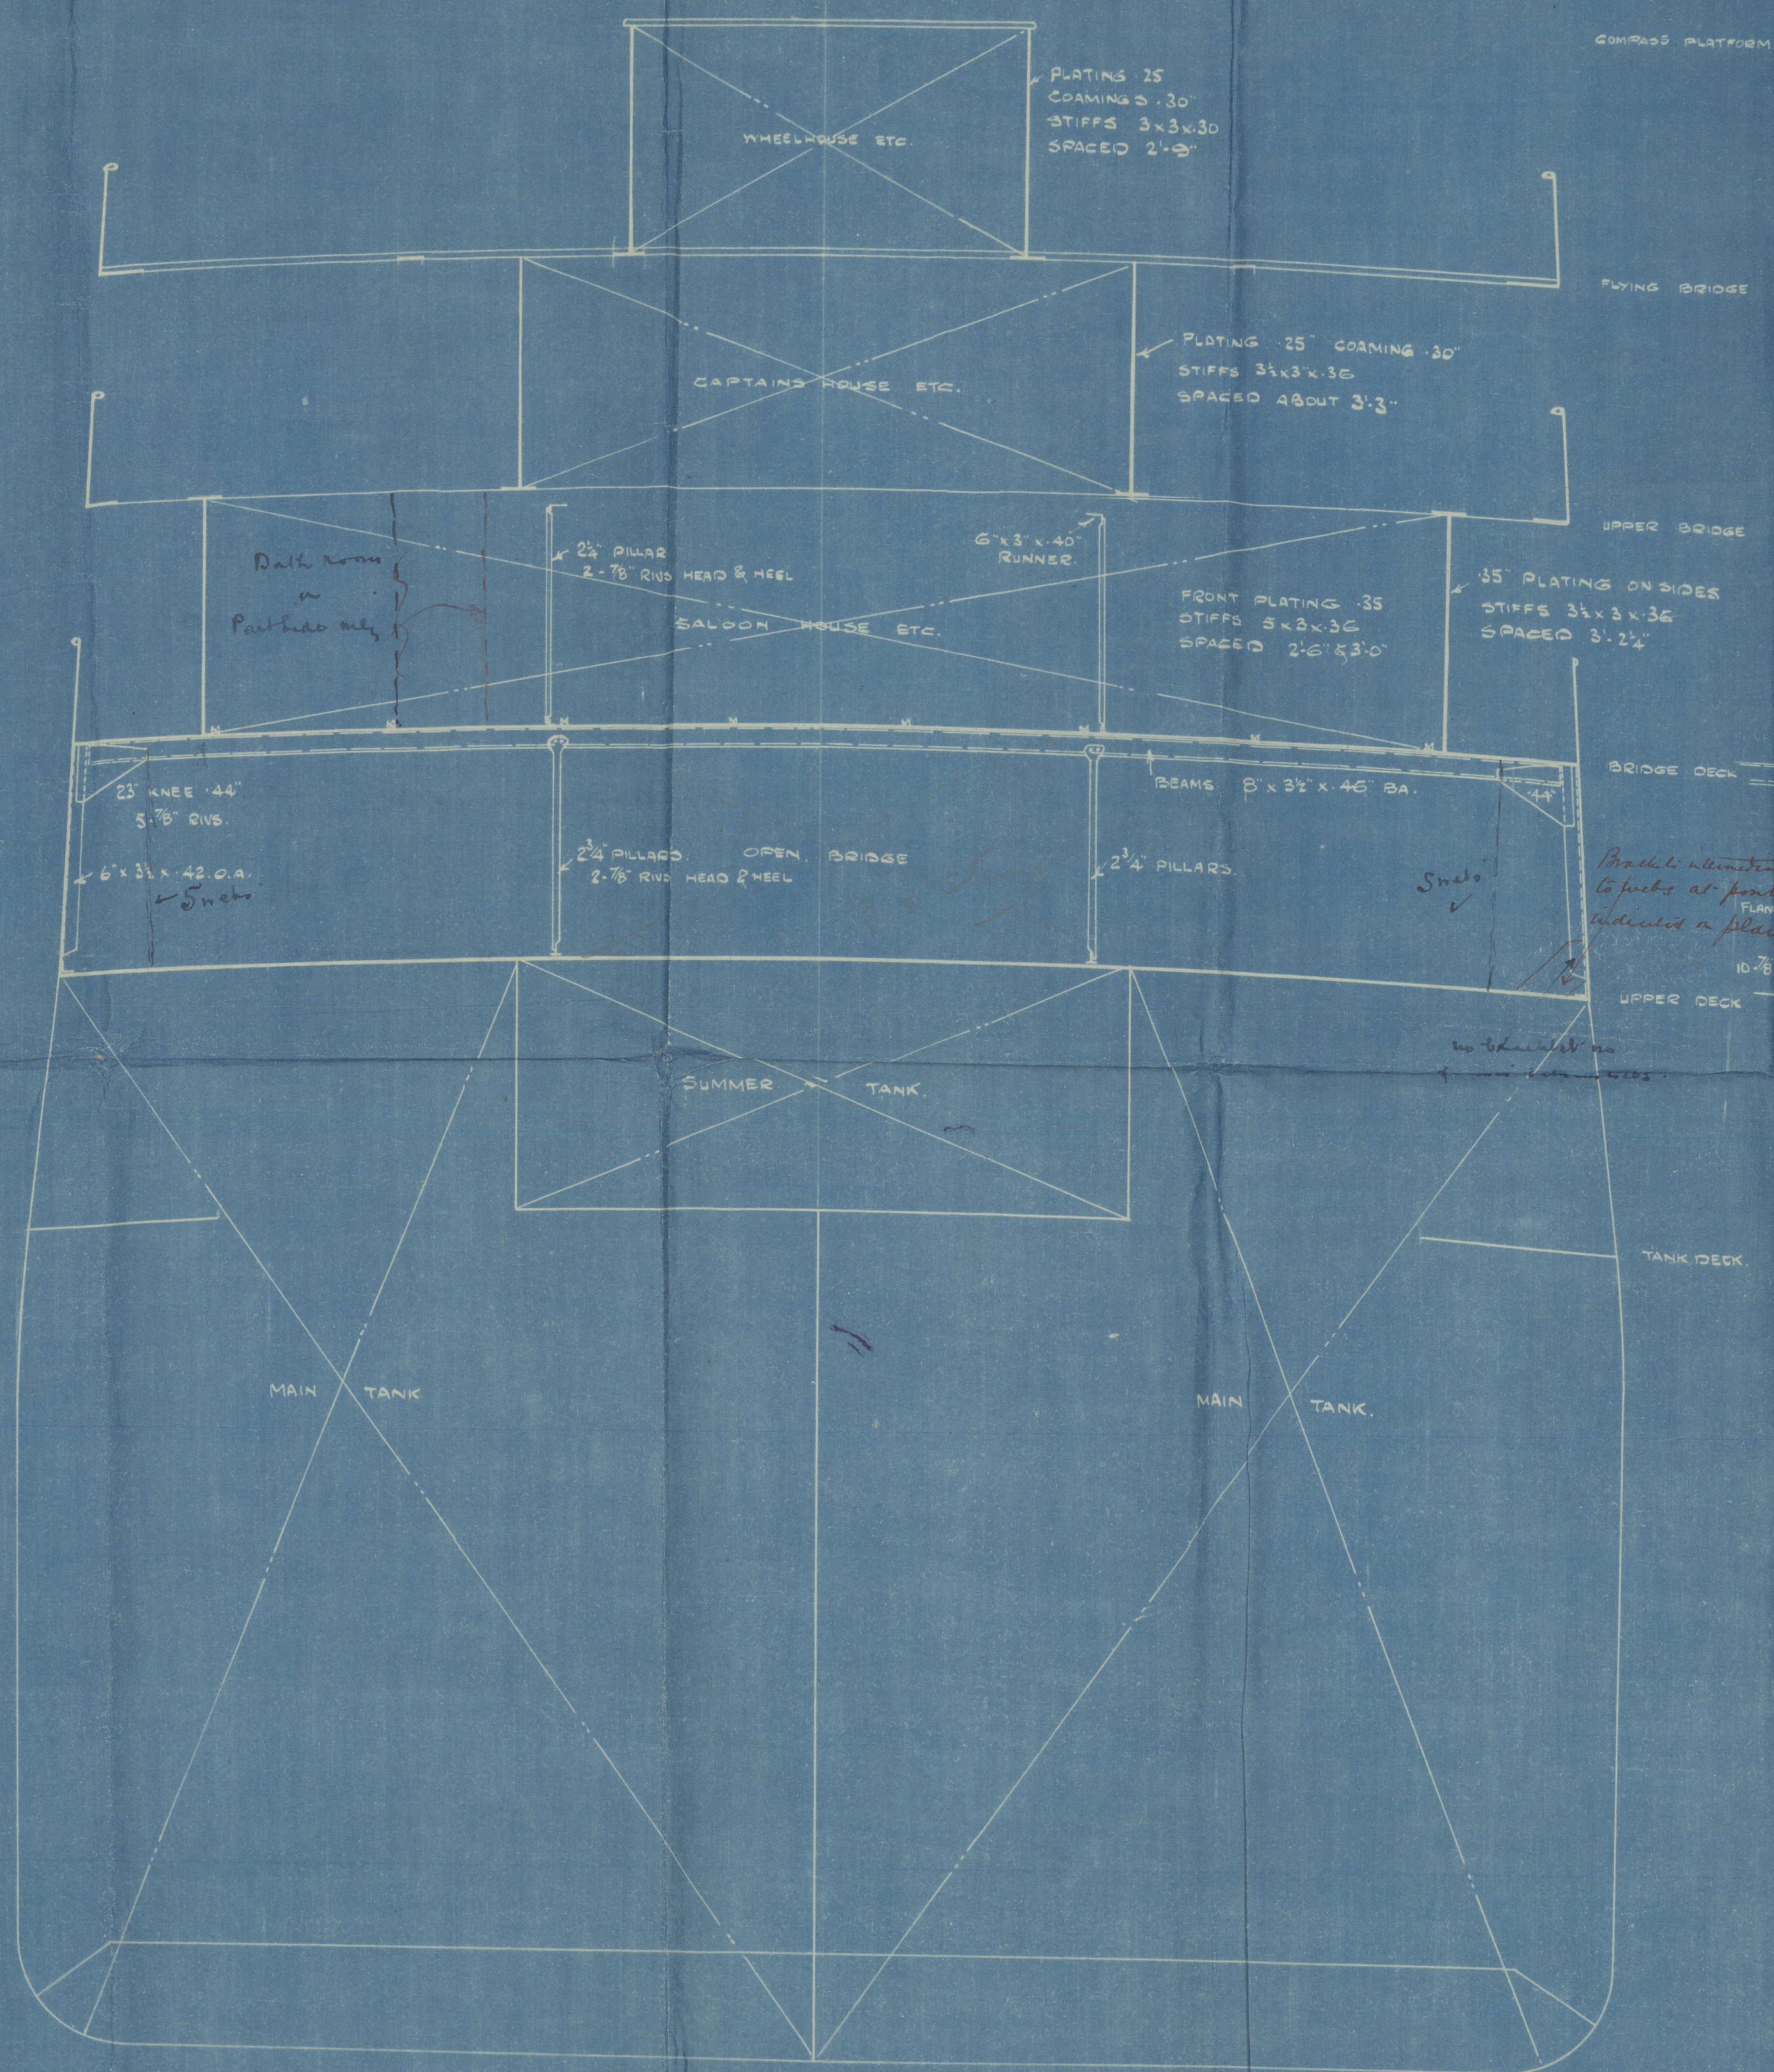
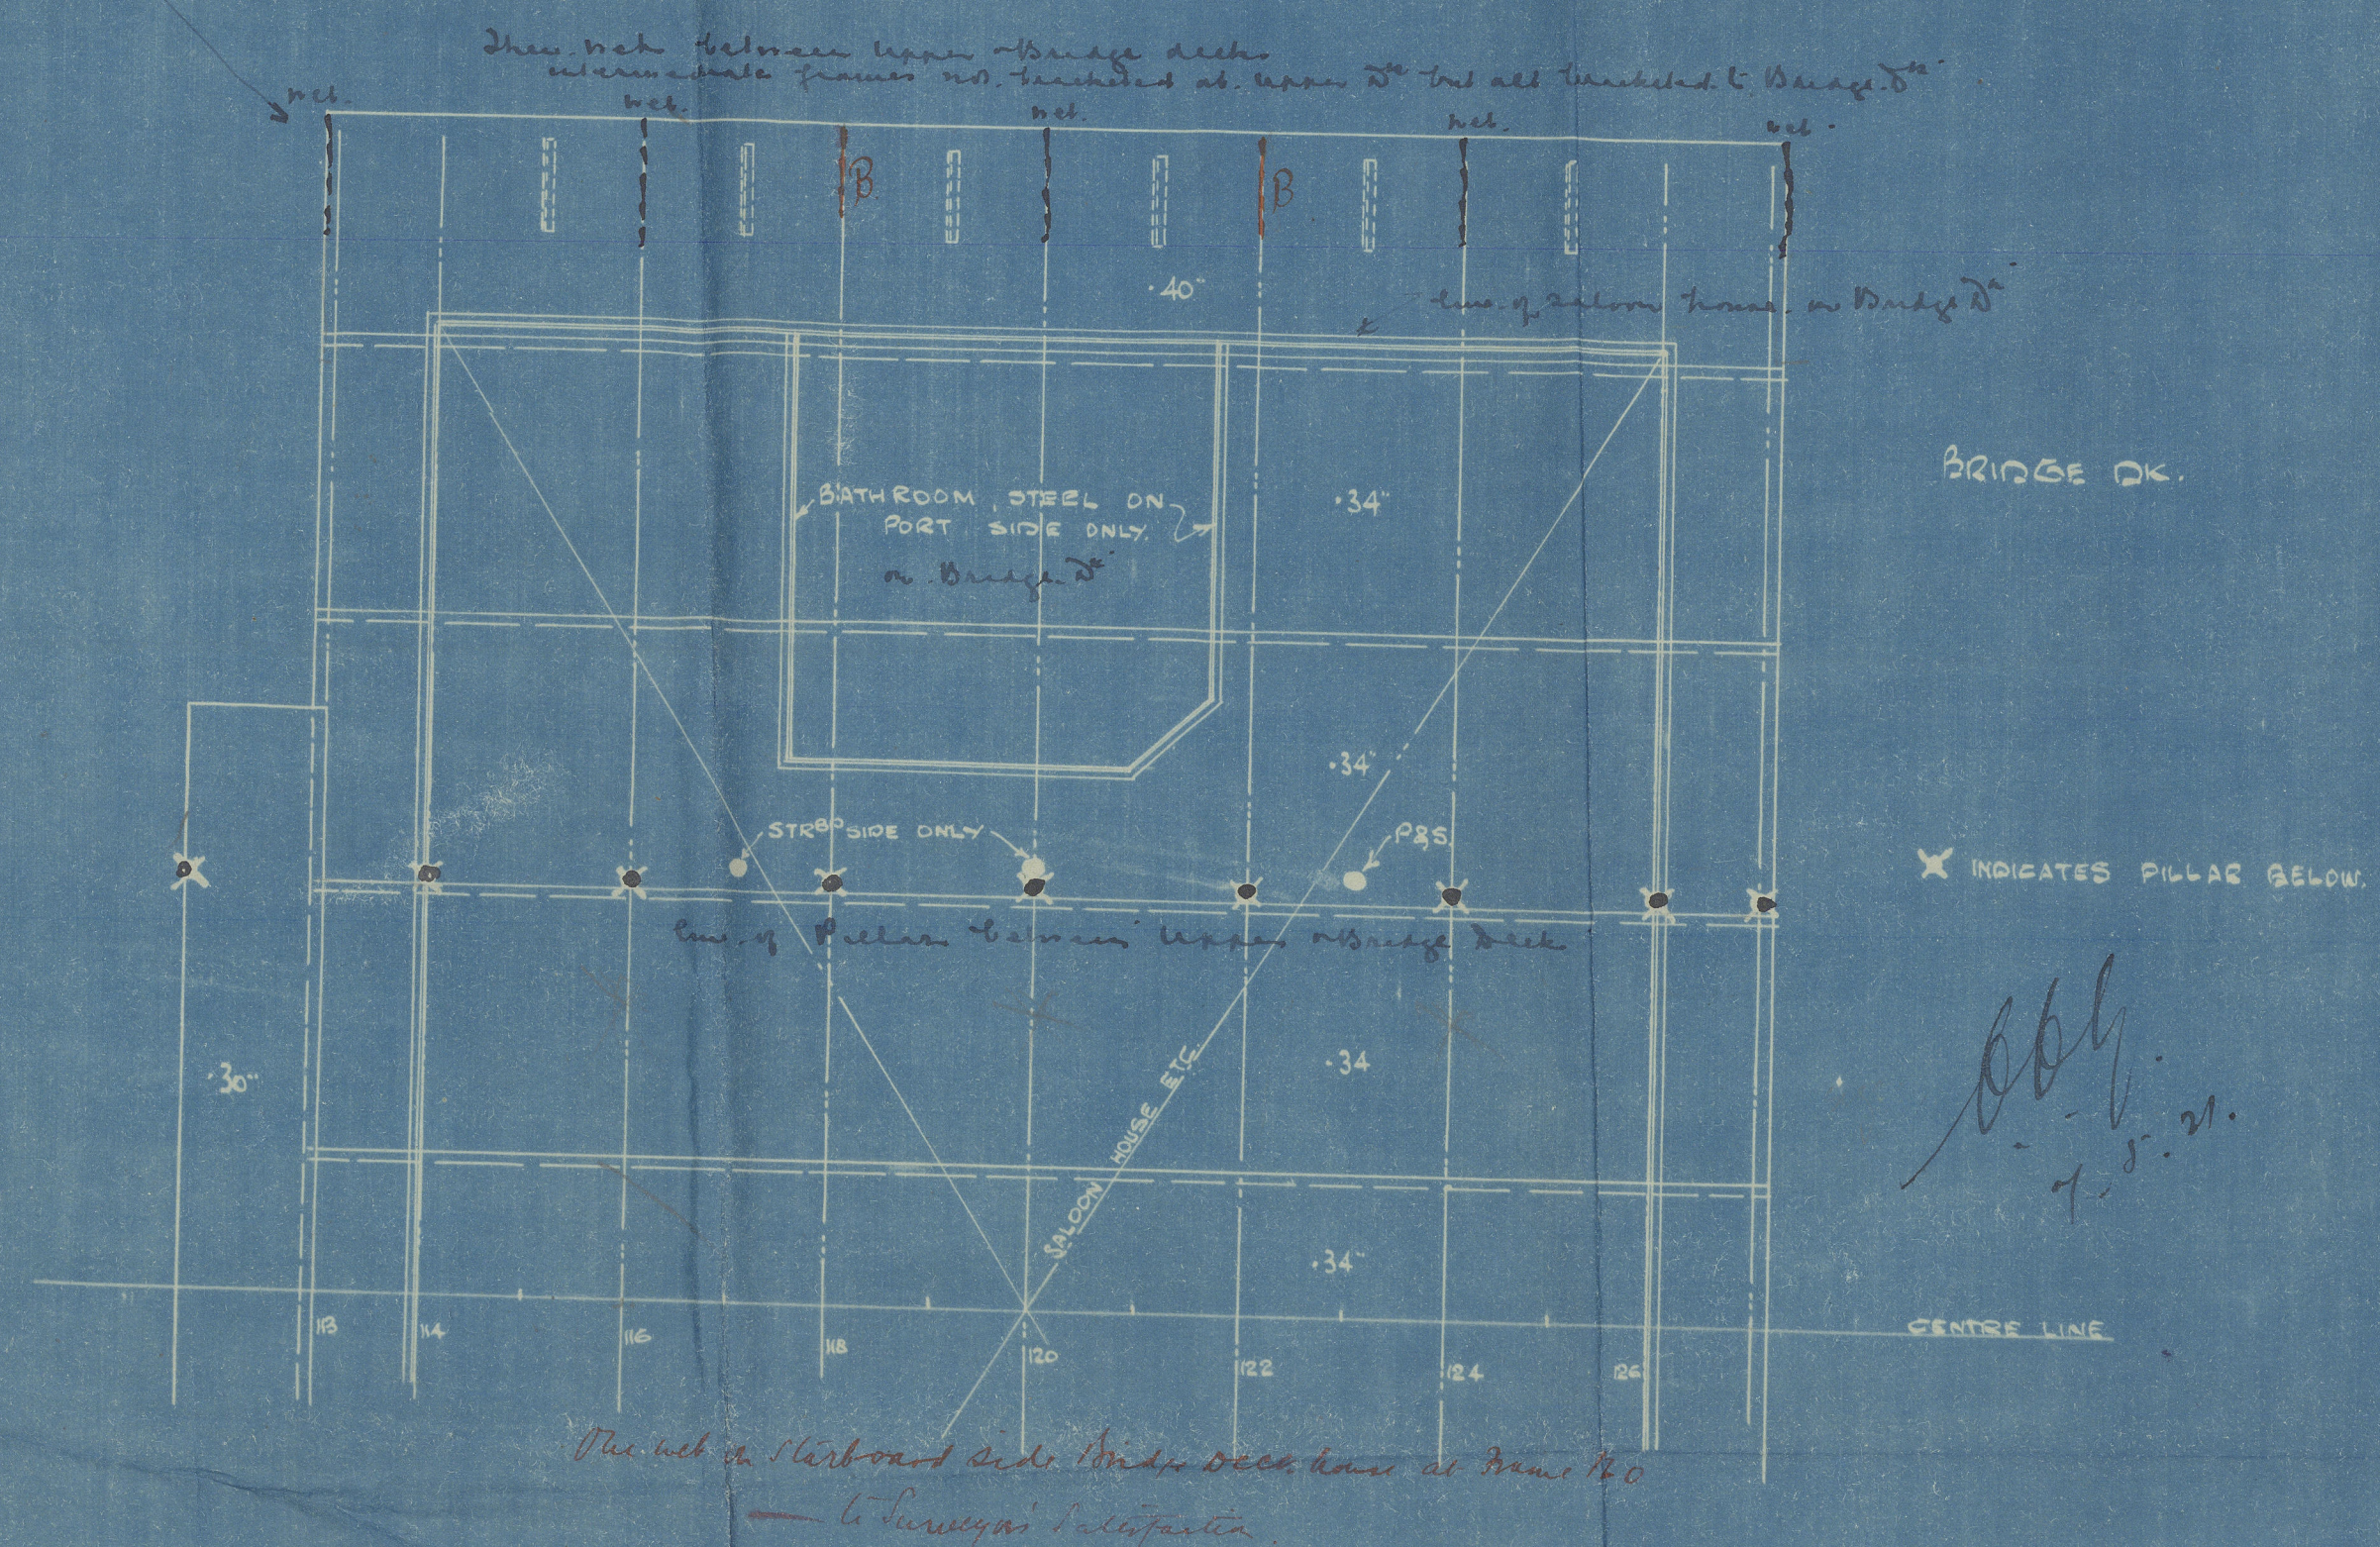


7.5.21

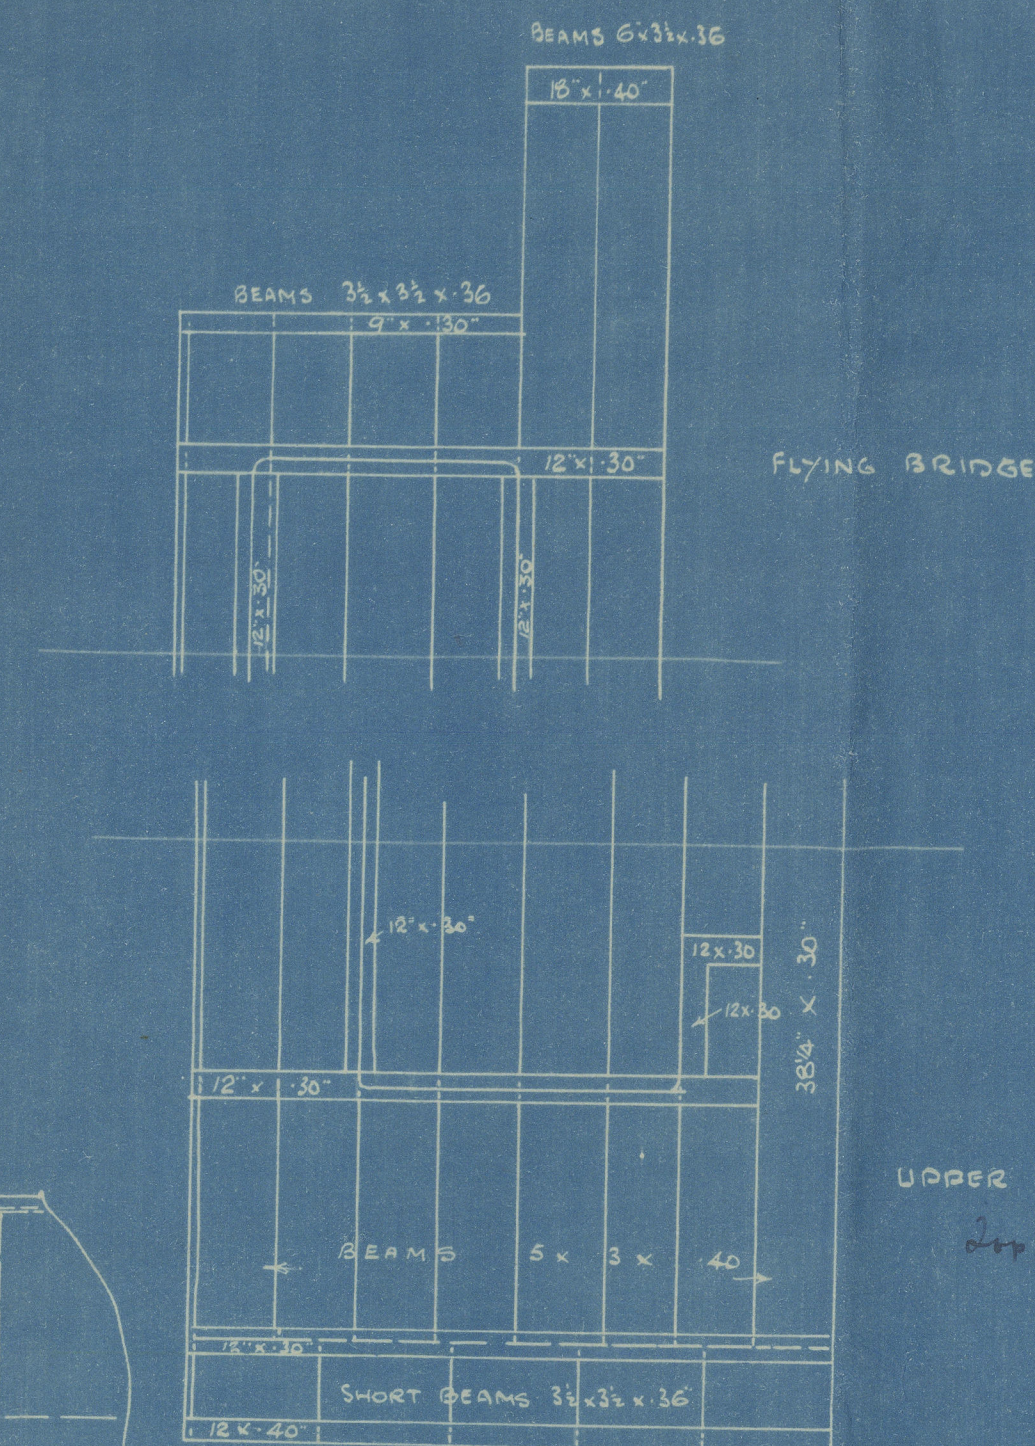

9/8 628
Arrangement of Bridge & Houses.
Scales 1/4" = 1'

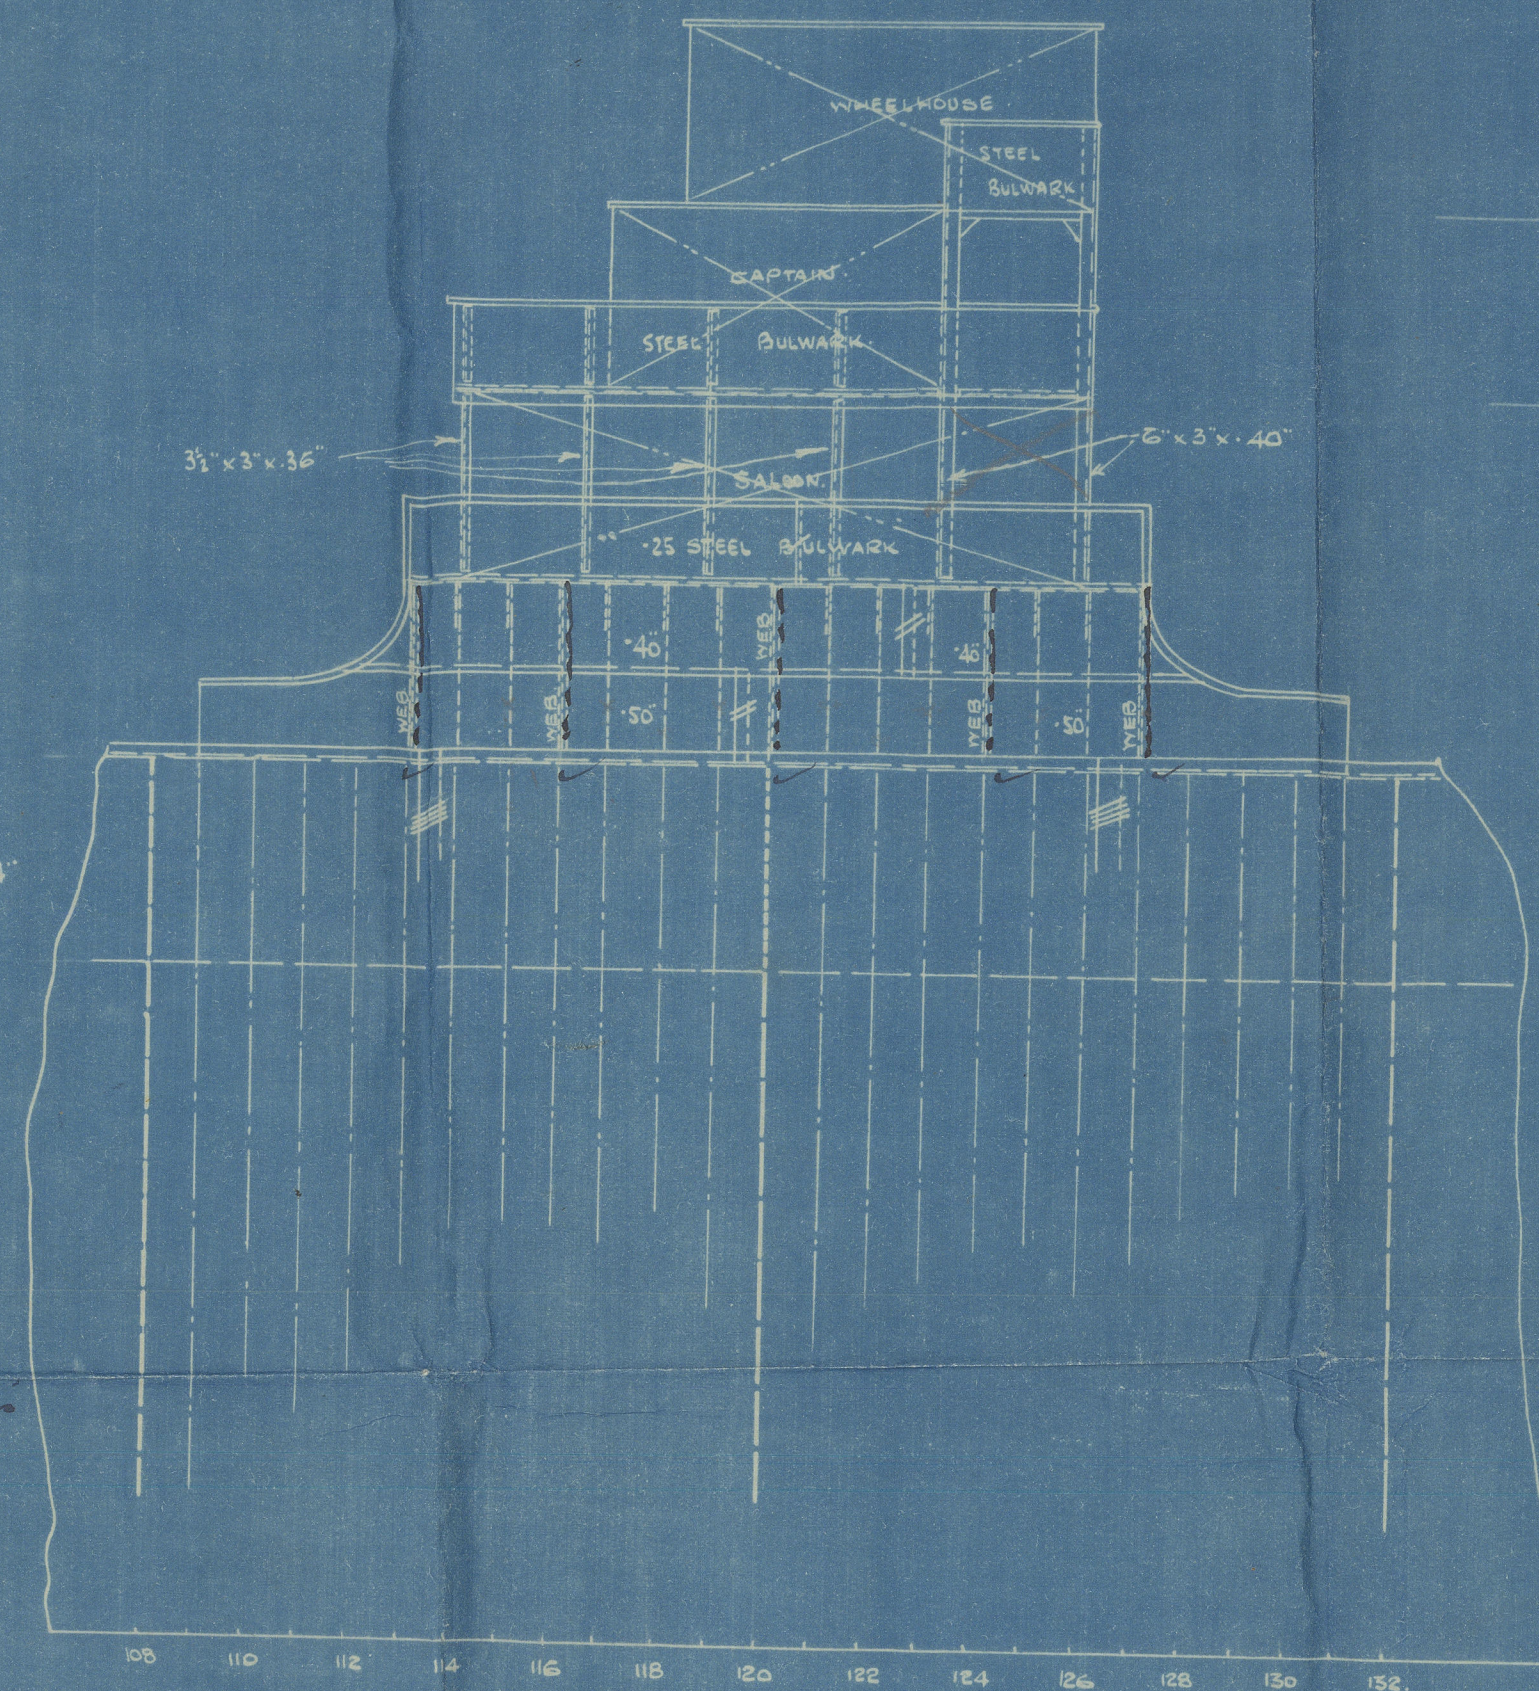

S.O.O.
 Y. 2431
 30.4.21
 S.1851.

Thos. Furness S. B. & Co^d

Nos 6 + 8

arrangement of Short open
Bridge + deck house

o/s "LISS"

MIDDLESBRO Rpt No. 11043.

o/s La Fresca No 8

MIDDLESBROUGH Rpt No. 11650.



© 2021

Lloyd's Register
Foundation

009920-009923-0056