

No 6
PROFILE & DECK PLANS.



DIMENSIONS: 399' 6" B.P. x 52' 66" M.D. x 35' 42" DEPTH M.D.
SCALE: 1/4" = ONE FOOT
TRANSVERSE No 58 08
LONGITUDINAL No 35200
TO CLASS 100 A1 LLOYDS CARRYING PETROLEUM IN BULK

FOOP DECK
BEAMS 7' 36" x 40" S.A.
SIDE PLATING 36
BUTTS DOUBLE SEAMS SINGLE
BEAM KINGS 20' x 40" S 5/8 RIVETS

BRIDGE DECK
BEAMS 8' 24" x 40" BULB ANGLES
SIDE PLATING 40 TOP STRAKE 50 BOTTOM STRAKE
BEAM KINGS 23' x 44" S 7/8 RIVETS
STRINGER ANGLE 24' x 36" x 40"
STRINGER 27' x 40"

TYPICAL SKETCH IN WAY OF EXPANSION TRUNK AT LEVEL OF TANK DECK
SCALE 1/4" = ONE FOOT

FORECASTLE DECK
SIDE PLATING 40

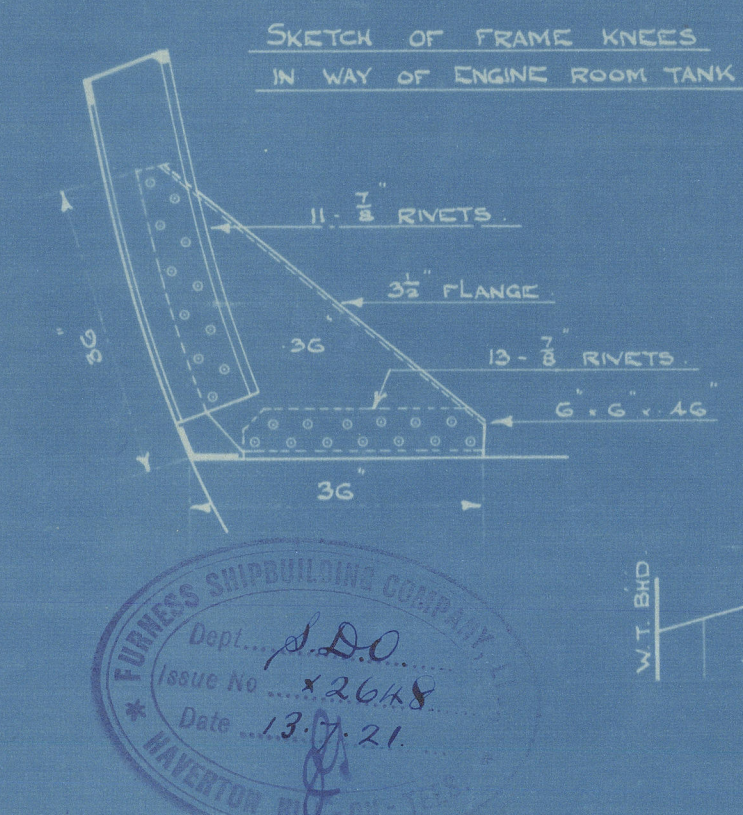 

Furness S. B. Co. Ltd.

No. 6.

PROFILE DECK PLANS

(100. Al carrying Petroleum in bulk)

(as built)

S. S. Liss

Inst. Rpt. No. 11043



© 2021

Lloyd's Register
Foundation

009920-009923-0057

FOR ENCLOSURE TO

Lloyd's Register of Shipping
Middlesbrough.

From FURNESS SHIPBUILDING CO. LD.
HAVERTON HILL-ON-TEES.



© 2021

Lloyd's Register
Foundation