

NOS 211-2


スタンフレーム及ラダー

A 157.50 # (A TAKEN TO C.L. OF PINTLE)  
D 3.50 FT.  
A x D 551.25  
SPEED 16 K. UNDER

MATERIALS :-  
STERN FRAME CAST STEEL  
RUDDER FRAME " "  
RUDDER HEAD FORGED STEEL  
PINTLES " "

KAIJIKYOKAI'S & LLOYD'S  
TEST CERTIFICATE REQUIRED

尺度 1/2" = 1'-0"  
工事 区 H 1

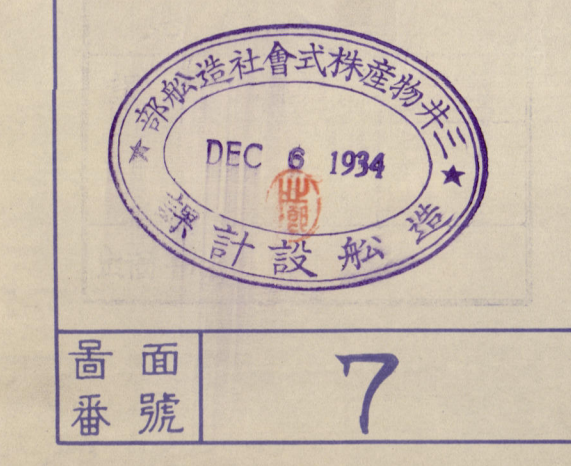

APPROVED  
KOBÉ



NOS 211-2

スタンフレーム及ラダー

尺度  $\frac{1}{2}'' = 1'-0''$

工事区画 H 1




面番 7

乞御承認


Plan of Stairframe  
Ladder.

for  
Mitsui Bussan Kaisha's  
Yard No. 211-2  
rep. "Otoasan Maru."  
rep. "Imroan Maru."

009934-009942-0316

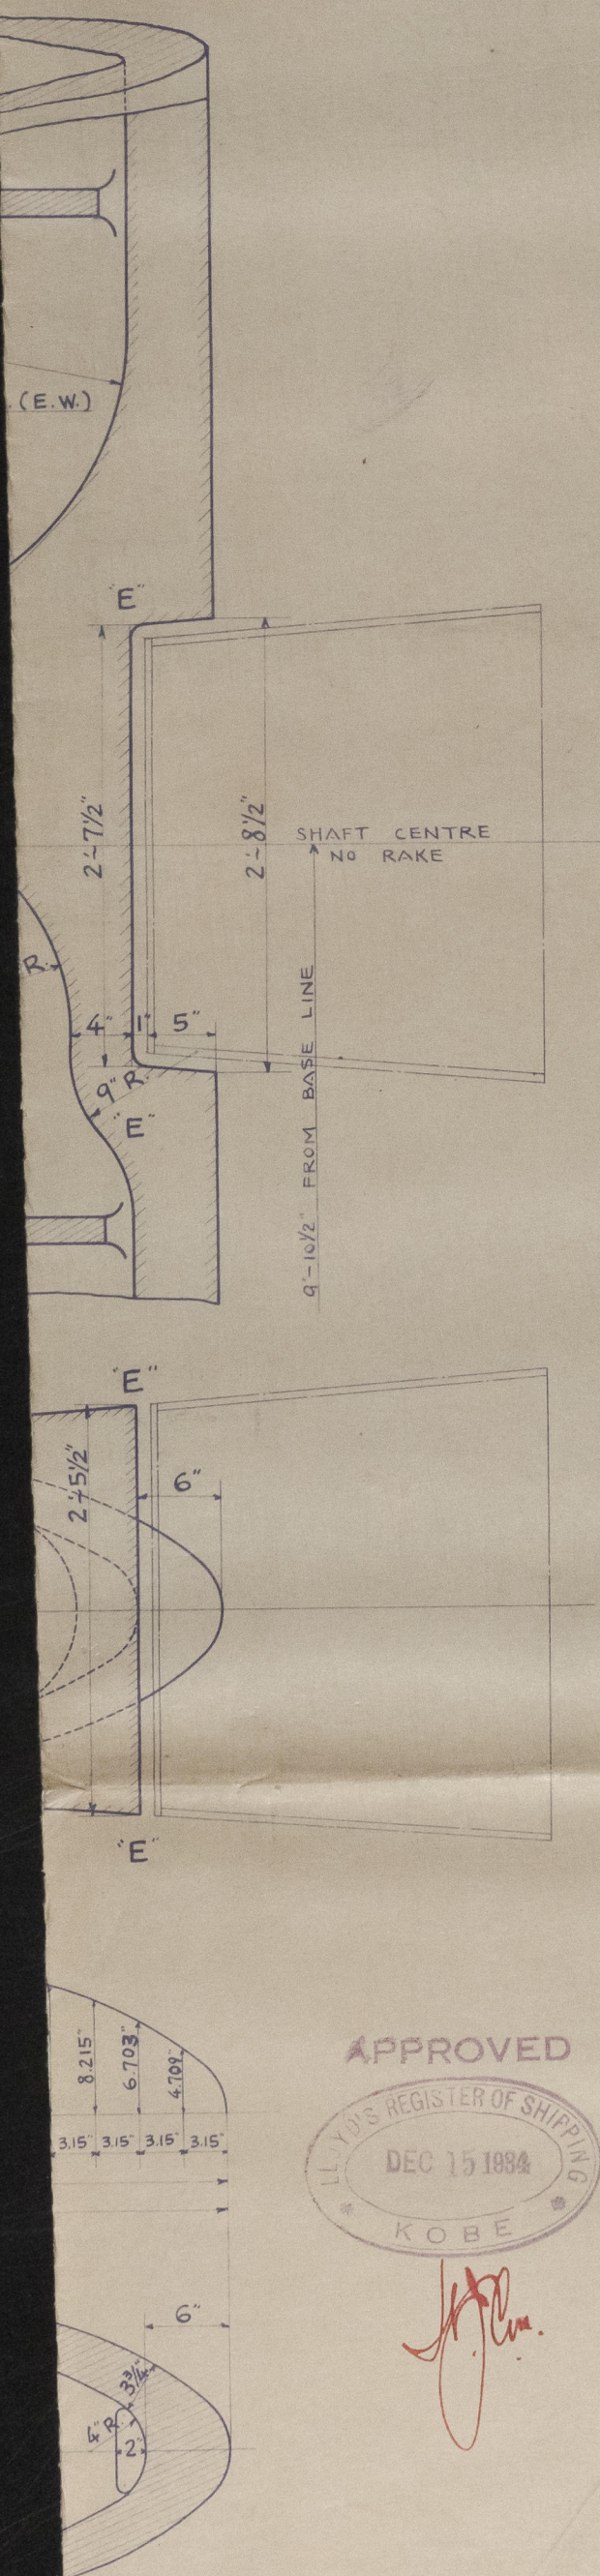

APPROVED

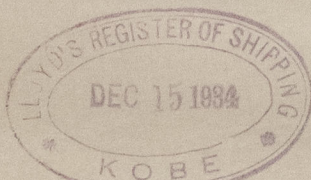

*[Handwritten signature]*

(4)

© 2021



Lloyd's Register  
Foundation