


# M.S. "OTOWASAN MARU" DAMAGE AND REPAIR PLAN

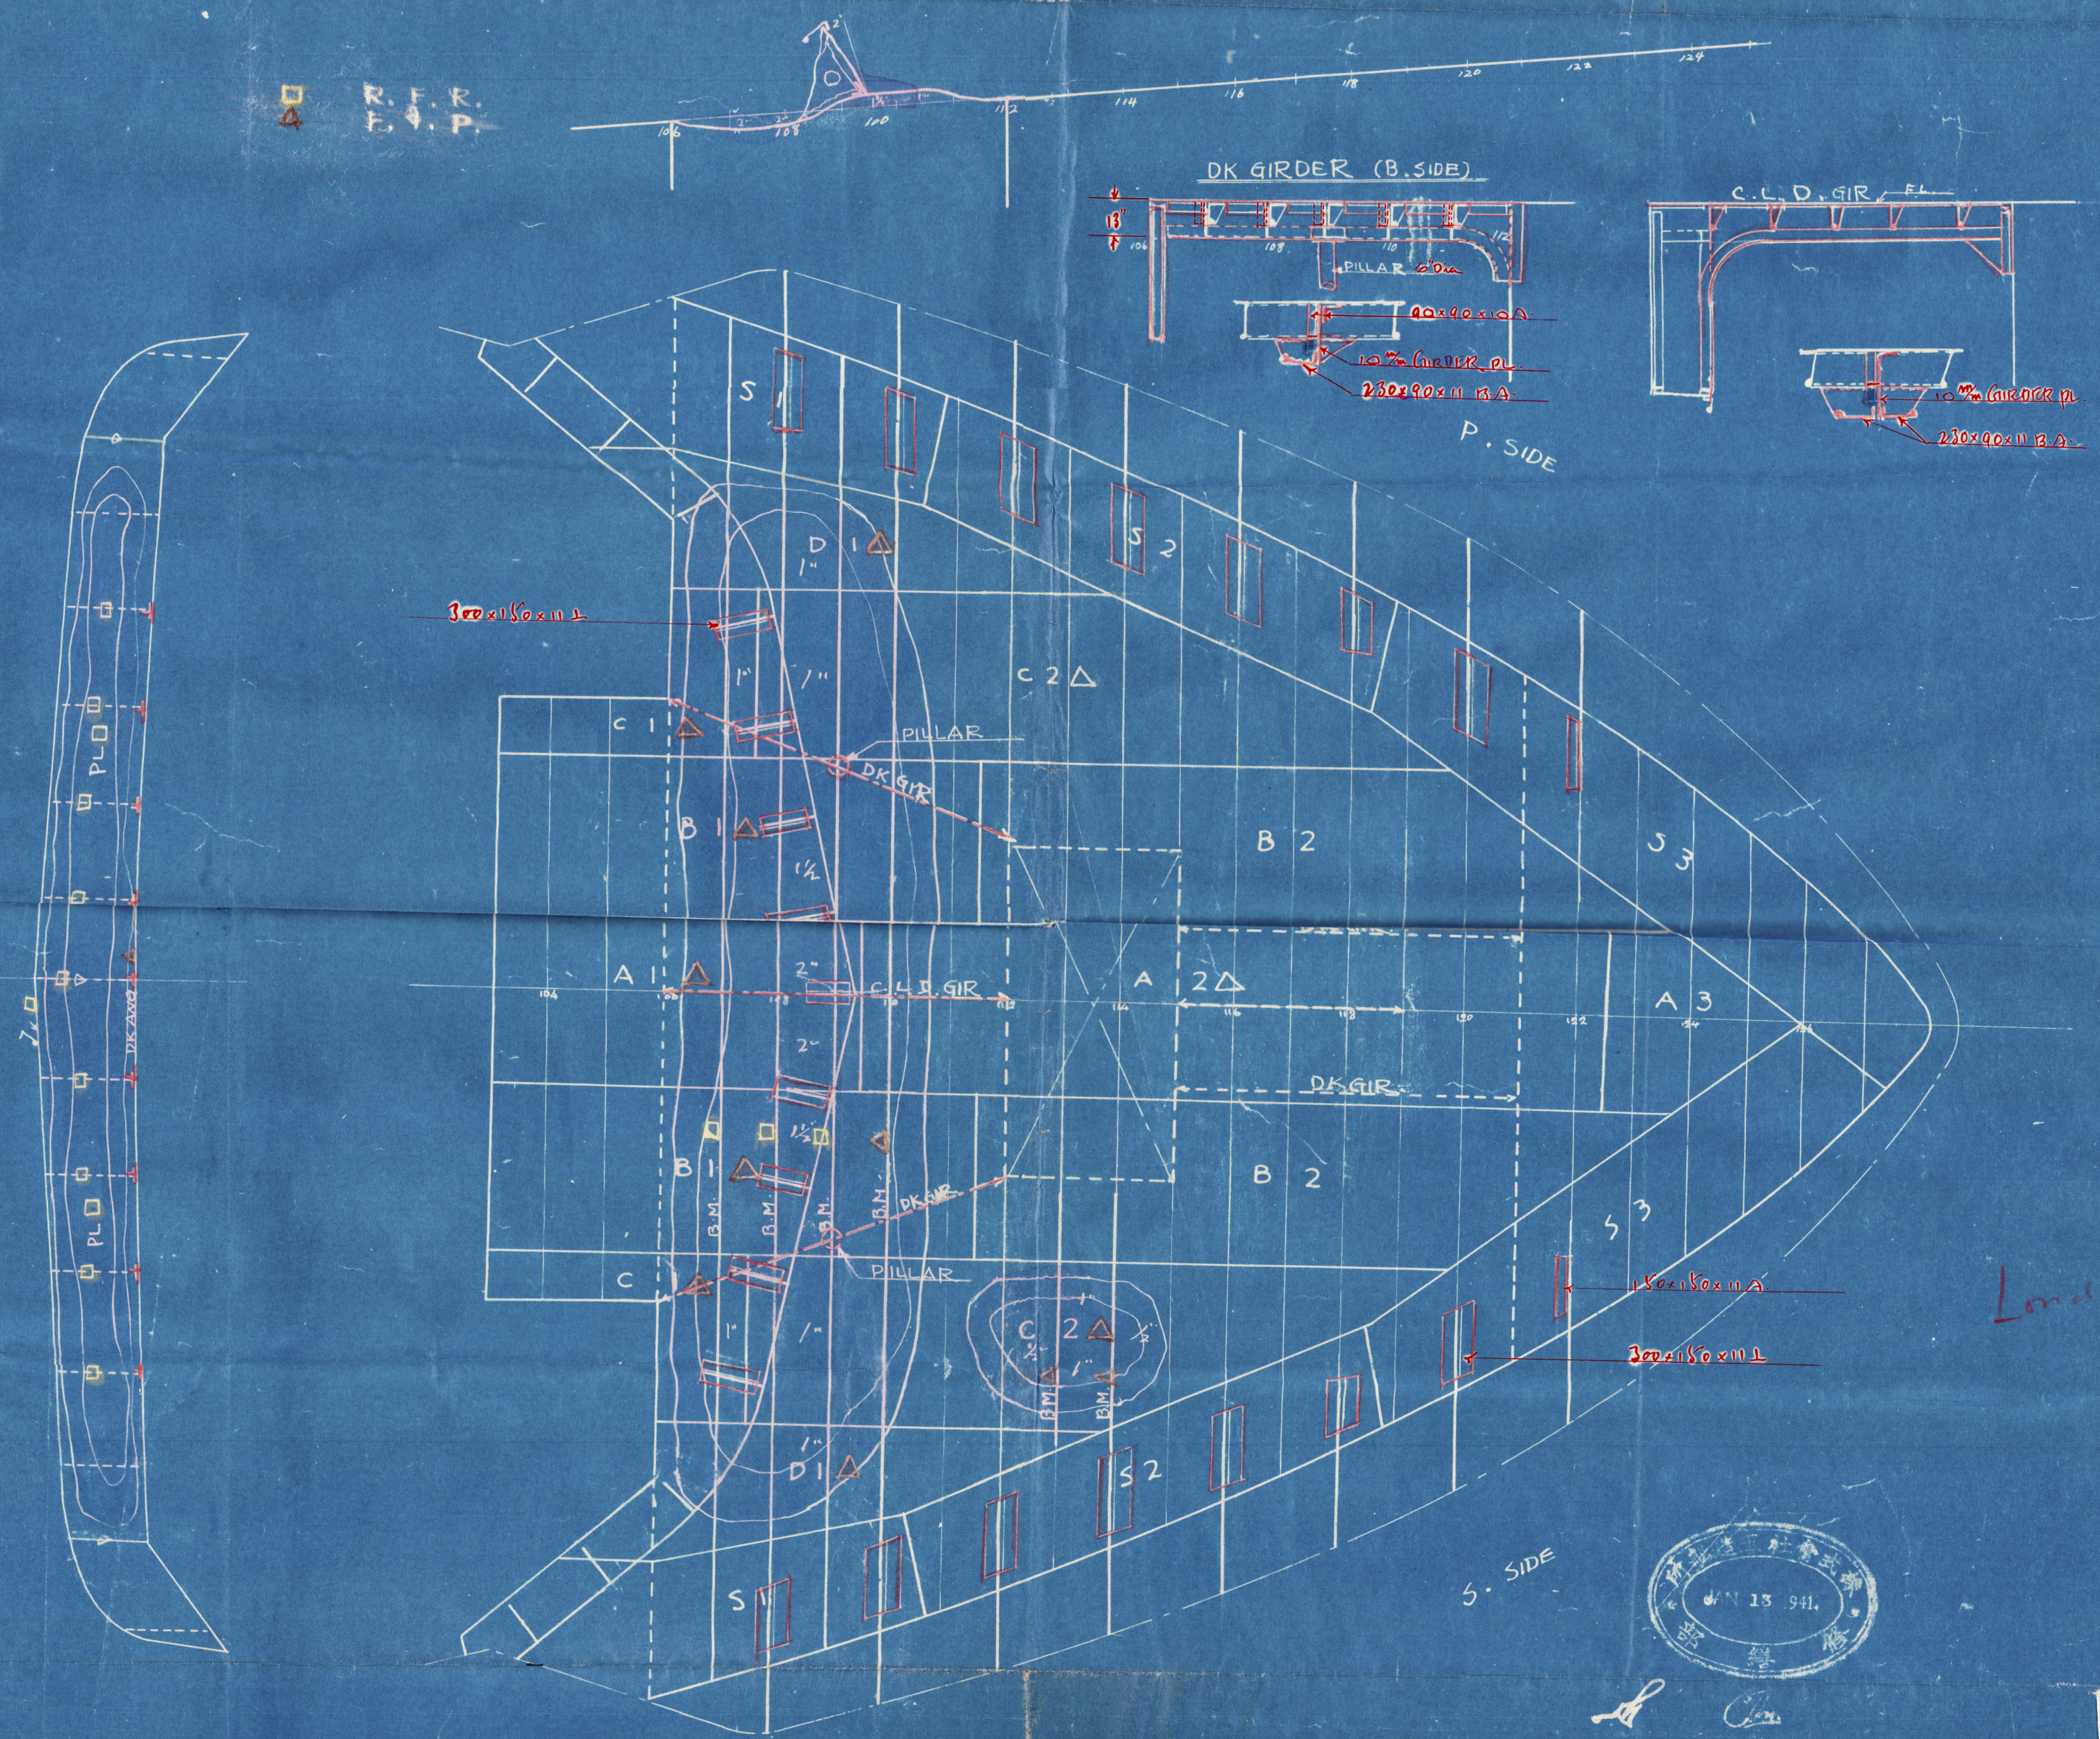



Otowan Manu.  
Kobe 11716.

009934-009942-0324

© 2021



Lloyd's Register  
Foundation