


Lloyd's Register of Shipping.

SURVEYS FOR FREEBOARD.

ANTHAS (CONDITIONS OF ASSIGNMENT.)
MAKEDONIA

Ship's Name *EMPIRE SQUIRE* Port of Survey *Newcastle-on-Tyne*
Official Number *168652* Surveyor's Signature *A.A. Mai*
Nationality and Port of Registry *British. South Shields* Date of Survey *During construction*

Disposition and dimensions of superstructures, trunks, deckhouses and machinery casings to be inserted in the diagrams and tabular statement:—

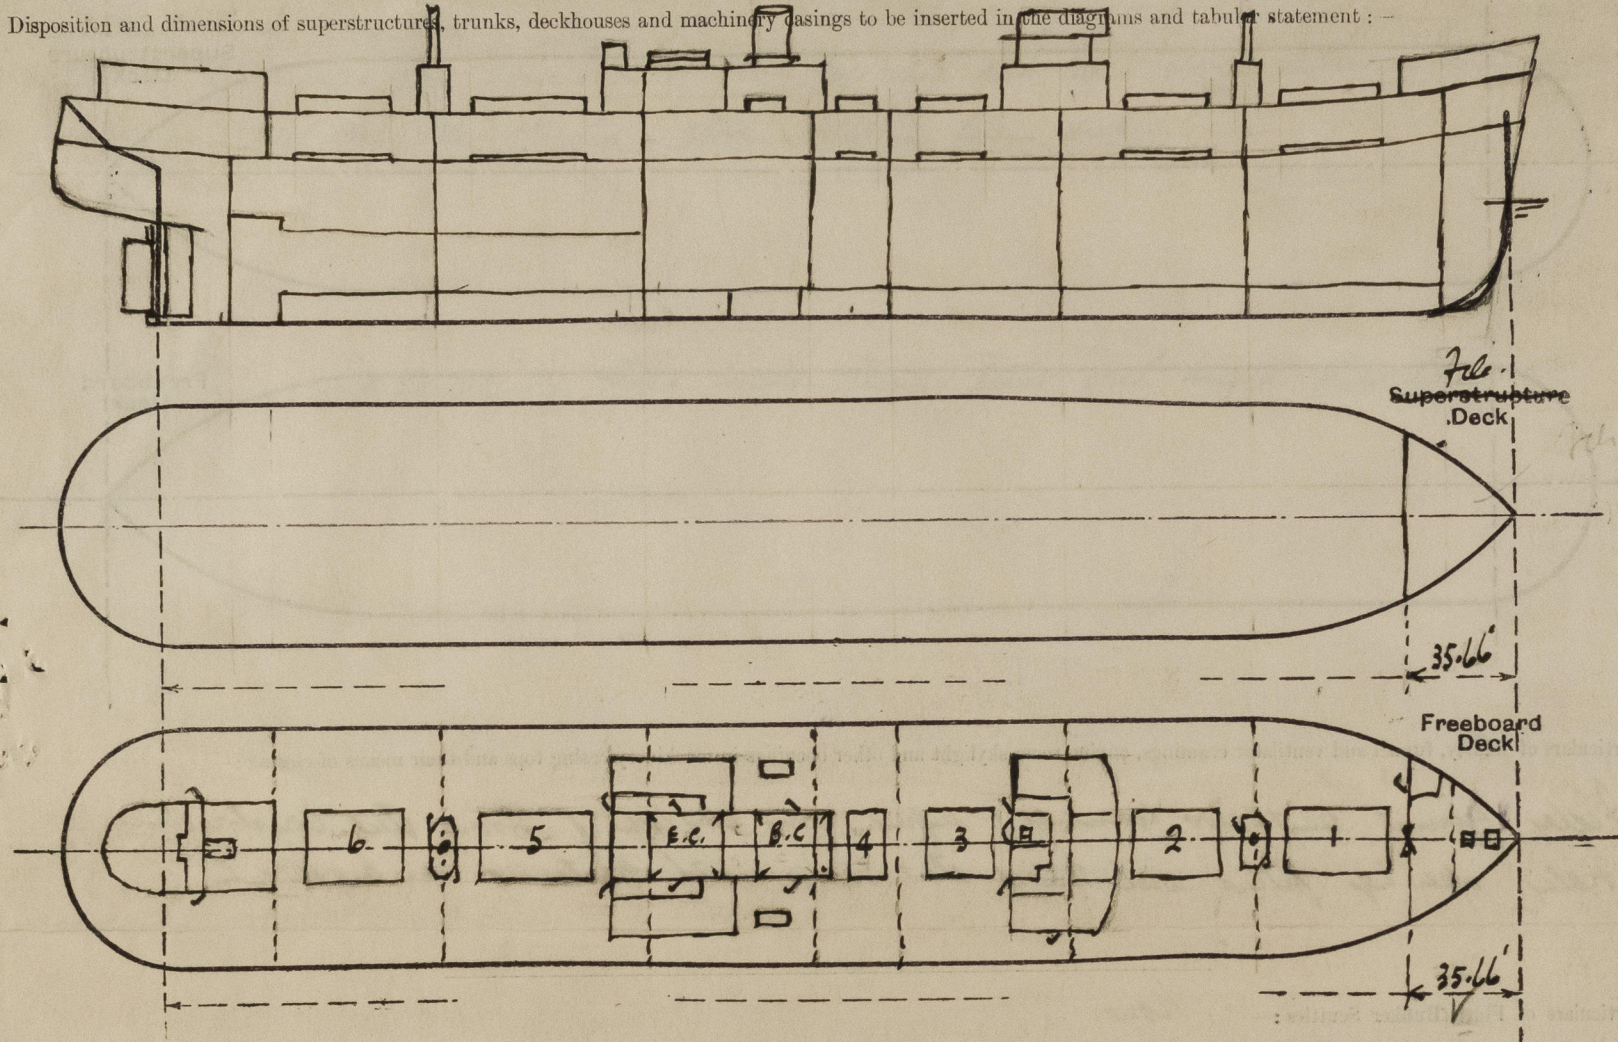


Particulars of Superstructures, Trunks, Casings, Deckhouses.

	Coaming	Plating	Stiffeners	Spacing	End Attachments of Stiffeners	Size of Openings	Height of Sills	Height of Casings
Poop Bulkhead								
Raised Quarter Deck Bulkhead								
Bridge, After Bulkhead								
Bridge, Forward Bulkhead								
Forecastle Bulkhead	30	30	4 x 3 x .32 L	30"	✓	1 @ 5' x 2' 3" 1 @ 5' x 4' 0 1/2"	12"	6' 9" ✓
Trunk, Aft								
Trunk, Forward								
Exposed Machinery Casings on Freeboard or Raised Quarter Decks	40 x .35	30	3 1/2 x 3 x .40 L	31"	✓	2 @ 5' x 2' 3"	22" ✓	7' 6" ✓
Exposed Machinery Casings on Superstructure Decks								
Machinery Casings within Superstructures not fitted with Class I Closing Appliances								
Deckhouses on Flush Deck Ships	✓	25	3 x 3 x .35 3 x 3 x .30	36" L 30" H	As per L. Boundary Br.	2 @ 3' x 2' 1 @ 5' x 4'	18" ✓ 22" ✓	7' 6" ✓

Particulars of Closing Appliances (state if capable of being manipulated from both sides).

Poop Bulkhead	Three deck bulkheads	Fore head and bulkhead at aft end of No. 1 hold:— No openings. Aft head bulkhead:— one hinged steel w.t. escape door between crew quarters and defence personnel's quarters. The openings in the remaining bulkheads are made by w.t. by portable steel plates secured by through bolts spaced five diameters apart.
Raised Quarter Deck Bulkhead		
Bridge, After Bulkhead		
Bridge, Forward Bulkhead		
Forecastle Bulkhead	1 hinged steel door operates both sides. 1 steel plate secured by hook bolts spaced about 12" apart.	
Exposed Machinery Casings on Freeboard or Raised Quarter Decks	Hinged steel doors operated from both sides.	
Exposed Machinery Casings on Superstructure Decks		
Machinery Casings within Superstructures not fitted with Class I Closing Appliances		
Deckhouses on Flush Deck Ships	2 hinged steel doors operate both sides. 1 double hinged steel door with strong lock. Operates both sides.	

Particulars of Gangway Cargo and Coaling Ports:—

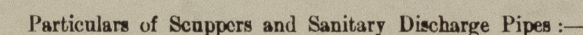

Particulars of Side Scuttles:—

Particulars of Flush Bunker Scuttles:—

None.

Particulars of Guard Rails :—

Particulars of Gangways, Lifelines, etc. :—

Particulars of Freeing Arrangements.

Additional area where sheer is less than standard.

No 1 haulaway fitted with efficient locking arrangements

Particulars of any special features:—

Am T.

Endorsement at first survey and at surveys for renewal of Certificate :—

The fittings and appliances are in accordance with the particulars shown on this form (or as now modified) and are in good condition.

