


1500, 11.28.

FREEBOARD REPORT on the

Extract from Mobile Rpt. 8. No. 959.
dated 8/6/31

Freeboard markings under American Bureau directions
placed on vessels sides and verified

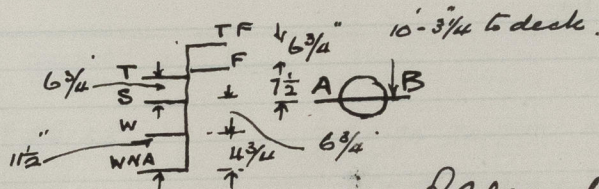

Alterations necessary for freeboard
previously completed



© 2021

Noted.

Lloyd's Register
Foundation

30-6-31

009954-009961-0218