

# Lloyd's Register of Shipping.

## SURVEYS FOR FREEBOARD.


### (CONDITIONS OF ASSIGNMENT.)

 Index No. **37491**  
 (For London Office only).
Ship's Name **S.S. "FORT ST. FRANCOIS"**Port of Survey **QUEBEC, P. Q.**Official Number **168403.**Surveyor's Signature **A. Nislop.**Nationality and Port of Registry **London: British**

Date of Survey

**4th December, 1942.**

Disposition and dimensions of superstructures, trunks, deckhouses and machinery casings to be inserted in the diagrams and tabular statement:—

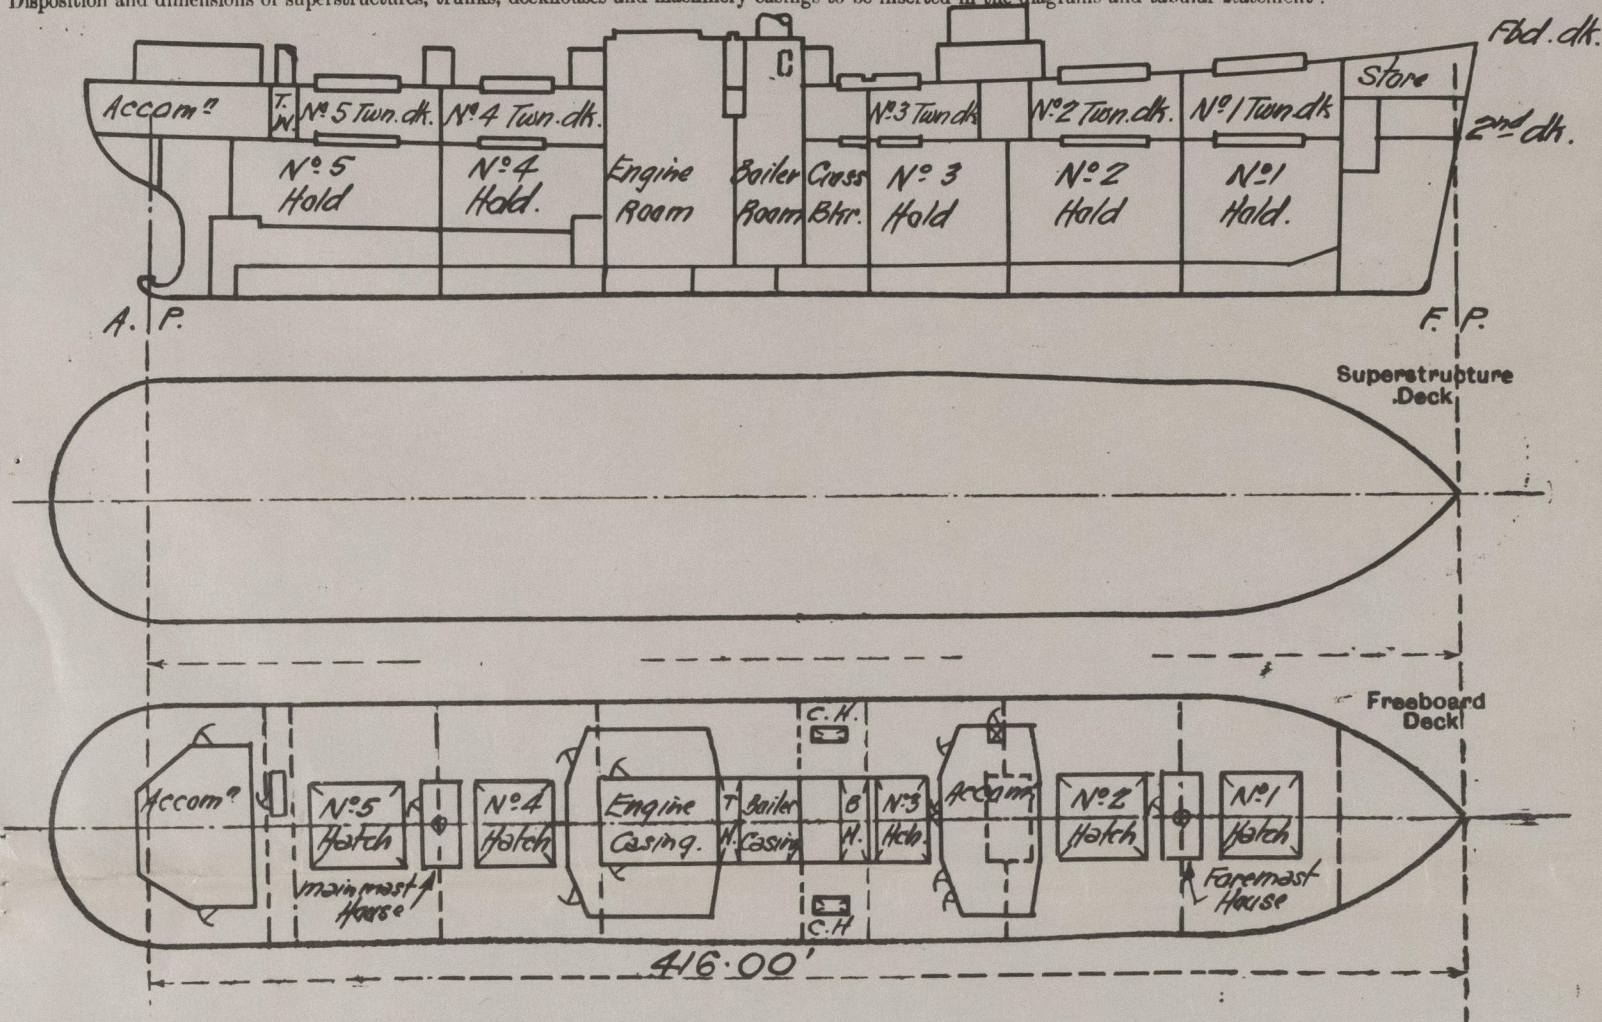

Particulars of Superstructures, Trunks, Casings, Deckhouses.

	Coaming	Plating	Stiffeners	Spacing	End Attachments of Stiffeners	Size of Openings	Height of Sills	Height of Casings
Poop Bulkhead ...	-							
Raised Quarter Deck Bulkhead ...	-							
Bridge, After Bulkhead ...	-							
Bridge, Forward Bulkhead ...	-							
Forecastle Bulkhead ...	-							
Trunk, Aft ...	-							
Trunk, Forward ...	-							
Exposed Machinery Casings on Freeboard or Raised Quarter Decks ...	22½ x .34"	.30"	3"x3"x.31"	30"-39"	Head-Bkt. 2-5'0"x2'0"		24"	10'-6"
Exposed Machinery Casings on Superstructure Decks ...	Vert. Plg.	.40"	5"x3"x.38"	33"	Bottom Con. Ford-5'x2'		18"	7'-6"
Machinery Casings within Superstructures not fitted with Glass Closing Appliances ...	"	.30"	3"x3"x.31"	Max. 40"	Bkts. top & bottom	See Comp'ways	24"	7'-6"
Deckhouses on Flush Deck Ships ...	"	Sides .30" Front .35"	3"x3"x.31" 5"x3"x.44BA	Max. 37½"	All bktd. at top. Altn heels bktd.	See Comp'ways	18"	7'-6"

Particulars of Closing Appliances (state if capable of being manipulated from both sides).

Poop Bulkhead ...	-
Raised Quarter Deck Bulkhead ...	-
Bridge, After Bulkhead ...	-2
Bridge, Forward Bulkhead ...	-
Forecastle Bulkhead ...	-
Exposed Machinery Casings on Freeboard or Raised Quarter Decks ...	Hinged steel doors, manipulated from both sides.
Exposed Machinery Casings on Superstructure Decks - Mast House	" " " " " "
Machinery Casings within Superstructures not fitted with Glass Closing Appliances ...	Hinged hardwood doors, manipulated from both sides.
Deckhouses on Flush Deck Ships ...	" " " " " "



# PARTICULARS OF PROTECTION TO OPENINGS, ETC.

HATCHWAYS ON FREEBOARD AND SUPERSTRUCTURE DECKS.											
On Freeboard Deck											Casing Top
Description of Hatchway	No.1 Cargo	No.2 Cargo	No.3 Cargo	No.4 Cargo	No.5 Cargo	Cross Bunker	WingBkr lp&ls	ForePk Store	Steering Gear	Saddle Back	
Dimensions of Hatchway	33'9"x20'	35'x20'	15x20	35x20	35x20	8x20	7'-2"x4'	2'-6"x3'	6 1-9x2	0 4-5x18-6	
COAMINGS	Height above Deck	30"	30"	30"	30"	30"	30"	24"	24"	9x3 1/2 x.44	
	Thickness	.44"	.44"	.44"	.44"	.44"	.44"	.40"	.40"	Bulb angle	
	Sides	.44"	.44"	.44"	.44"	.44"	.44"	.40"	.40"	Coaming	
	Ends	.44"	.44"	.44"	.44"	.44"	.44"	.40"	.40"	None	
Stiffeners	Bulb angles	7x3x38	9x3x44	7x3x38	9x3x44	8x3x44	7x3x38	None	None	None	
	Brackets, Stays	40flg.3"	40flg.3"	40flg.3"	40flg.3"	40flg.3"	40flg.3"	None	None	None	
HATCH BEAMS	Number	Five	Five	Two	Five	Five	One	None	None	None	
	Spacing	5'-7 1/2"	5'-10"	5'-10"	5'-10"	5'-10"	4'-0"	-	-	-	
	Scantling and Sketch										
	All Mounting Angles 5"x3"x.38"										
Bearing Surface	3"	3"	3"	3"	3"	3"	-	-	-	-	
FORE AND AFTERS	Number	None	None	None	None	None	None	None	None	None	
	Spacing	-	-	-	-	-	-	-	-	-	
	Unsupported Lengths	-	-	-	-	-	-	-	-	-	
	Scantling and Sketch	-	-	-	-	-	-	-	-	-	
Bearing Surface	-	-	-	-	-	-	-	-	-	-	
HATCH COVERS	Material	W.P.	W.P.	W.P.	W.P.	W.P.	W.P.	W.P.	W.P.	W.P.	
	Thickness	3"	3"	3"	3"	3"	3"	3"	3"	3"	
	How fitted	Fore&Aft	F&A.	F&A.	F&A.	F&A.	Athwart	Athwart	Athwart	F&A.	
	Bearing Surface	3 1/2"	3 1/2"	3 1/2"	3 1/2"	3 1/2"	3"	3"	3"	3"	
Spacing of Cleats	24"	24"	24"	24"	24"	24"	24"	24"	17"	21"	
Number of Tarpaulins	Three	Three	Three	Three	Three	Three	Three	Two	Two	Three	
<p>*Are wood fore and afters steel shod at all bearing surfaces? No fore and afters.</p> <p>Are battens and wedges efficient and in good condition? Yes.</p> <p>Are tarpaulins in good condition and in accordance with rule requirements? Yes.</p> <p>Are lashings provided in accordance with rule requirements? Steel locking bars fitted to all hatchways.</p>											

Particulars of any special features:—

This vessel is of the closed shelter deck type, the tonnage opening abaft No. 5 hatchway being closed W.T. by riveted steel plate, efficiently supported by a transverse beam. ~~Under Clause I of Ministry of Shipping memorandum, M3307/41 (Circular Letter No. 1777) and in view of this vessel being in full compliance with the requirements stated therein, the emergency deeper loading regulations apply to this vessel.~~

Moulded W.L.	Full Draft	Full Displacement	Tons/Inch Immersion	Shell & Appendages.
21'	21' - 1-3/8	10,471 tons	46.40	67.0 tons
24'	24' - 1-3/8	12,165 "	47.38	73.0 "
27'	27' - 1-3/8	13,895 "	48.27	77.9 "

Endorsement at first survey and at surveys for renewal of Certificate:—

The fittings and appliances are in accordance with the particulars shown on this form (or as now modified) and are in good condition.



© 2021

Lloyd's Register  
Foundation

0163 2/4



Particulars of Gangway Cargo and Coaling Ports:—

None.

Particulars of Scuppers and Sanitary Discharge Pipes:—

All scuppers from spaces below freeboard deck discharge to bilges.  
Sanitary discharges from spaces above freeboard deck are fitted with brass storm valves at ships side.  
" " " "tonnage well" space below freeboard deck aft are fitted with brass N.R. valves at ship's side with extended spindles to freeboard deck.  
2" scuppers p&s. from stores, fitted with brass N.R. valves below second deck with extended spindles to freeboard deck.  
Strongly constructed ash shoot, midships, starb'd side, casing watertight from ship's side to hopper, 39" above freeboard deck. Hopper fitted with hinged steel weathertight cover. Ship's side opening above second deck.

Particulars of Side Scuttles:—

To accommodation and steering gear spaces below freeboard deck aft, 10" diameter side scuttles, strongly constructed with brass frames and hinged bronze deadlights.  
To Deckhouses on Freeboard deck, 15", 12" and 10" diameter side scuttles, strongly constructed with brass frames and hinged malleable cast iron deadlights.

Vertical distance of Sill of lowest Side Scuttle above top of keel Side scuttles fitted below freeboard deck, aft only.  
Vertical distance of will of lowest side scuttle, 61'-1 1/2" forward of A.P., 36'-3" above top of keel.

Particulars of Guard Rails:—

Strongly constructed steel bulwarks, efficiently stayed, fitted on freeboard deck for about 36' at fore end and also abreast midship houses.  
Elsewhere on freeboard deck, steel stanchions, 3" x 1" flat, 3'-6" in height, spaced about 5'-0" apart, with 1 1/2" diam. pipe top rail and two 7/8" diam. solid rod rails.

Particulars of Gangways, Lifelines, etc.:—


Provision made for rigging life lines on each side of vessel, between midship deckhouses and from engineers deckhouse to after house.

Particulars of Freeing Arrangements.						
	Length of Bulwark	Height of Bulwark	Size of Freeing Ports	Number each side	Area each side	Rule area each side
After-Well Amidships...	127.75'	3'-6"	3'-0" x 9"	Four	9 sq.ft.	-
Forward Well ... ..						
State position of each freeing port ... .. (After-Well:— (F. and A. position and height above deck edge) Amidships:— 4" above deck. Forward Well:—						
State whether the freeing ports are fitted with shutters, bars, or rails, and give particulars of such:—No shutters, bars or rails fitted.						
Additional area where sheer is less than standard.						



### PARTICULARS OF PROTECTION TO OPENINGS, ETC.

The following diagrams should be used to indicate the positions of cargo and coaling hatchways, gangway, cargo and coaling ports, ventilators, companionways, etc., which would affect the seaworthiness of the ship:—

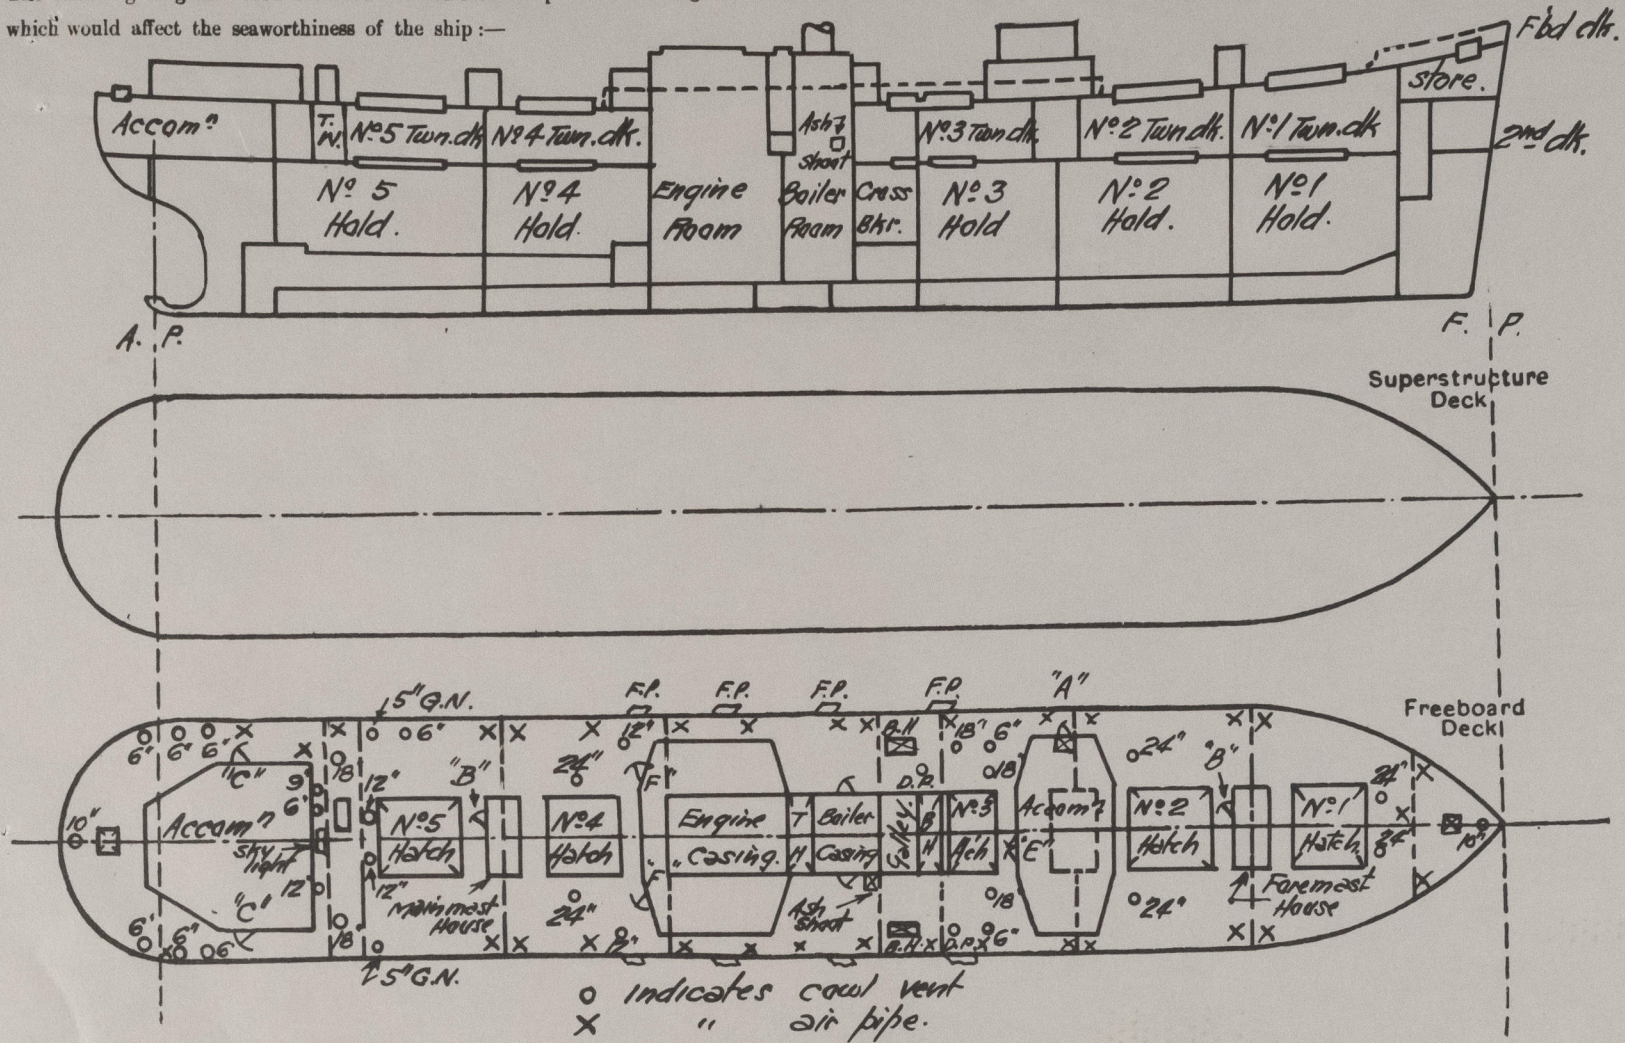

Particulars of fiddley, funnel and ventilator coamings, engine room skylight and other openings in machinery casing tops and their means of closing :—

Engine Room skylight of steel, strongly constructed.  
Funnel and ventilator coamings, strongly constructed.  
Fiddley openings fitted with hinged steel covers with locking arrangements

**Particulars of Flush Bunker Scuttles :—**

None.

Particulars of Companionways :-		All companionway doors operated from both sides.	
"A" - 5'-0" x 2'-0"	opening, sill 18" with hinged steel watertight door in dkhse. side, port, to hold.	"	" masthses, encl. hold escape
"B" - 5'-0" x 2'-0"	"	"	" solid h'wood door to poop hse., encl. comp'way to Accommodation.
"C" - 4'-10 1/2" x 2'-0"	"	"	" " " " strong steel comp'way to tonnage well.
"D" - 5'-11 1/2" x 2'-3"	"	"	" " " " double solid h'wood doors to saloon hse., encl. access to cabin store
"E" - 5'-0" x 3'-4"	"	"	" " " " solid h'wood door to dkhse., encl. engine.
"F" - 5'-0" x 2'-0"	"	"	" " " " One skylight to crew space aft 3'-6" x 2'-0", coaming .30" x 16" above wood deck with hinged steel covers.

One skylight to crew space aft 3'-6"x2'-0", coaming .30"x16" above wood deck with hinged steel covers.

Particulars of Ventilators in exposed positions on freeboard and superstructure decks:—

Particulars of Ventilators in exposed positions on freeboard and upper decks.			
6-24"	diam.	cowl vents,	coamings 36"x.42" to Holds and Tween decks.
3-18"	"	"	" " " " " " " "
2-18"	"	"	10'-6"x.40" " " " " " coamings stayed to end of house.
2-12"	"	"	36"x.34" " Deep Tank.
2-12"	"	"	36"x.34" " No. 5 Tween decks.
1-10"	"	"	36"x.32" " Stores.
1-10"	"	"	36"x.32" " Steering gear compartment.
1-9"	"	"	36"x.32" " Crews accommodation
8-6"	"	"	36"x.30" " " "
2-6"	"	"	36"x.30" " Cabin store, etc.
1-12"	"	"	36"x.34" " Tunnel escape,
2-5"	"	goosenecks,	18"x.62" " Crews wash & W.C.

2-5" goosenecks, 18 ft. long.  
All ventilators fitted with wood plugs and canvas covers.

Particulars of Air Pipes in exposed positions on freeboard, ~~raised quarter, or superstructure~~ decks:—

2-3" diam. air pipes to fore peak.  
2-2" and 1-2½" diam. air pipes to No. 1 D.B.  
4-3" diam. air pipes to No. 2 D.B.  
2-3" and 2-2½" diam. air pipes to No. 3 D.B.  
2-3" " 2-2½" " " " 4 D.B.  
2-3" diam. air pipes to No. 5 D.B.  
2-3" " " " " 6 D.B.

All air pipe openings 30" above deck and fitted with wood plugs and canvas covers.