


LLOYD'S REGISTER OF SHIPPING

UNITED WITH THE BRITISH CORPORATION REGISTER

Ship's Name "OTIS" EX "WESTBRIS" Official No.

Memorandum of alterations reported since ship was surveyed for assignment of Load Lines in DECEMBER 1950 AT KIEL

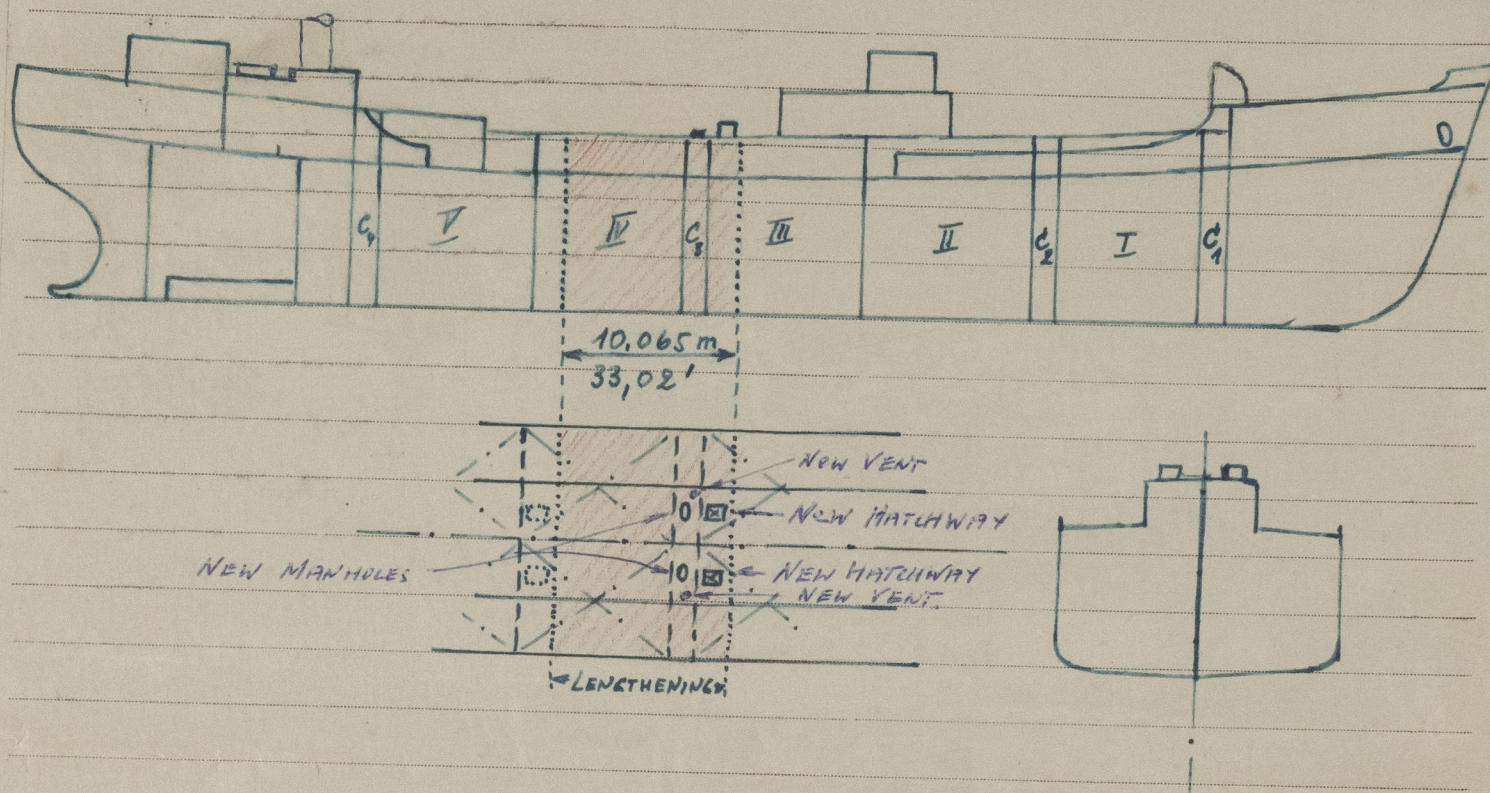

ALTERATIONS NOW EFFECTED: -

- 1.) Lengthening of the hull by 10.065 mm - 33,02'
- 2.) Fitting of 2 additional oil hatches for No.III cargo oil tanks (1 p.s., 1 s.s.) of same dimensions, (see above sketch) coamings, covers and closing arrangements as the existing 8 cargo oil hatchways, viz.: 1140 x 760 mm, coaming 200 x 12 mm with steel hatch covers of 12,5 mm thickness and hemp packing.
- 3.) Fitting of 2 main holes and doors for access to the now installed No.3 cofferdam, 400 x 600 mm, coaming 250 x 10 mm with steel hatch covers and hemp packing.
- 4.) Fitting of 2 additional ventilators for the now installed No.3 cofferdam of substantial construction coaming 760 x 8 mm, E.W. to deck plating and closed by steel covers and canvas covers.

A. H. Berg

G.H.W.

21 SEP 1951