

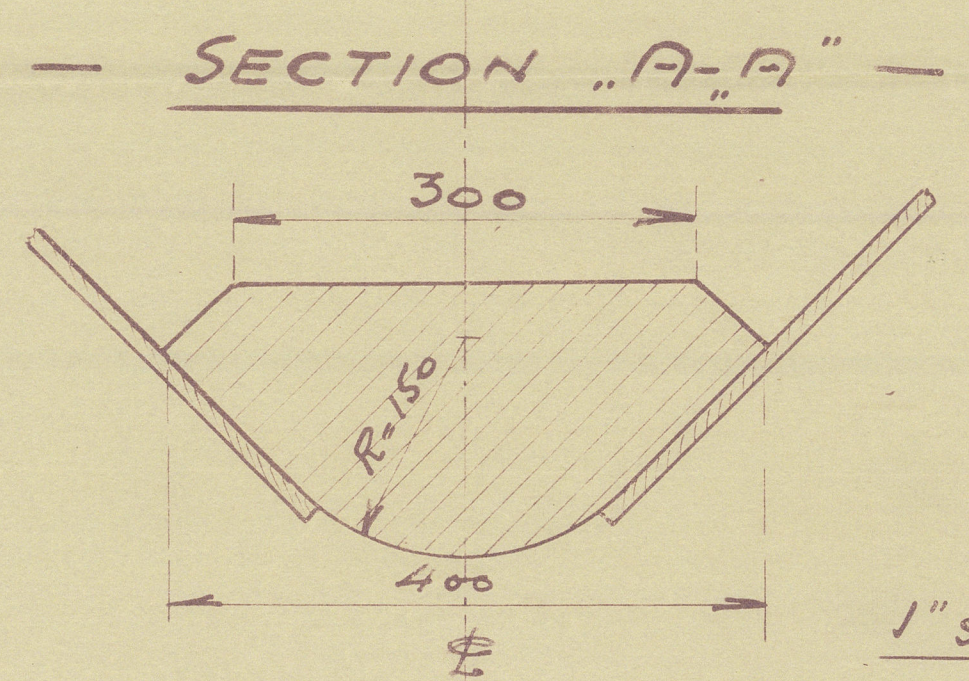
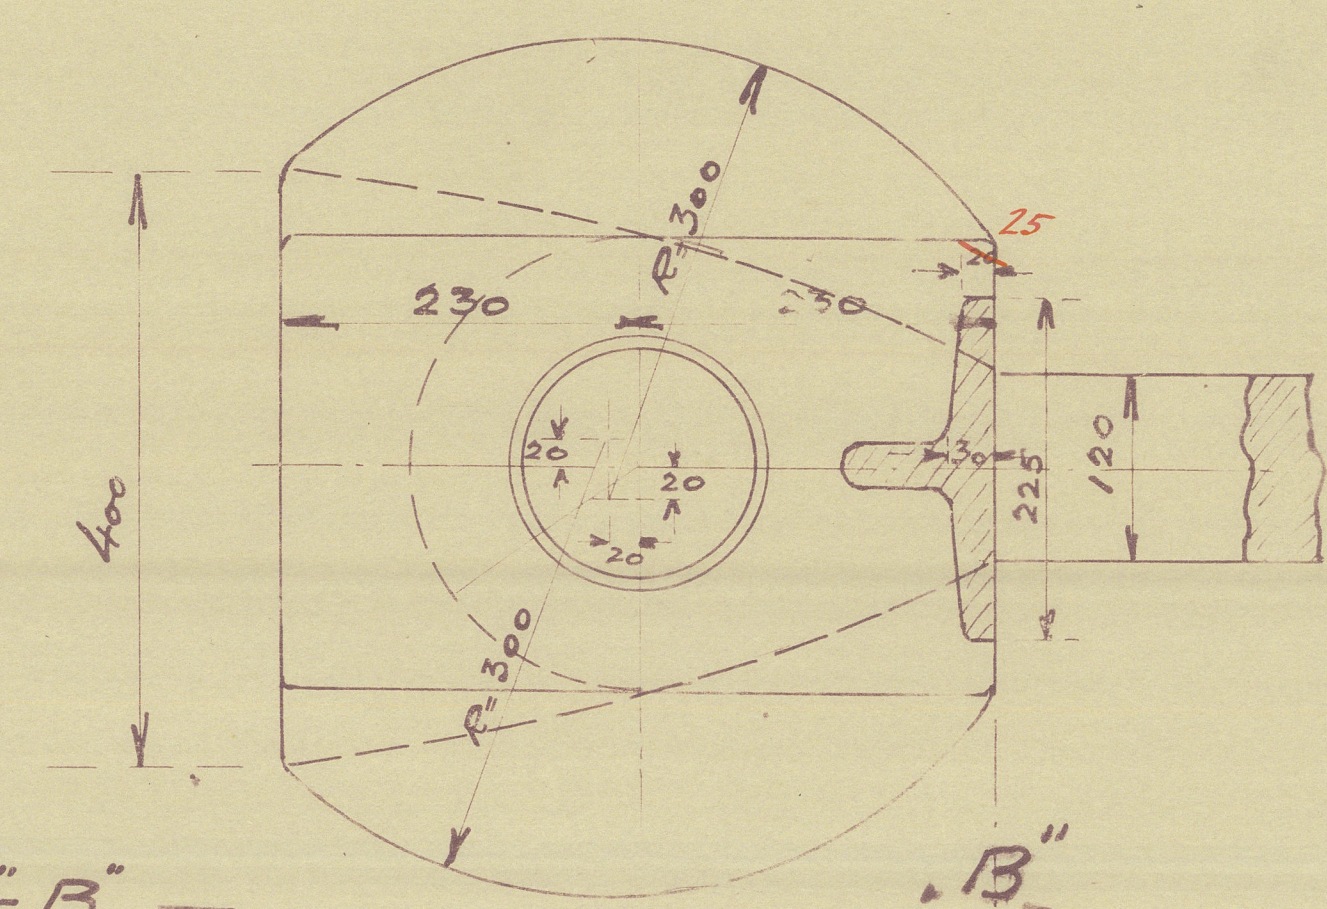
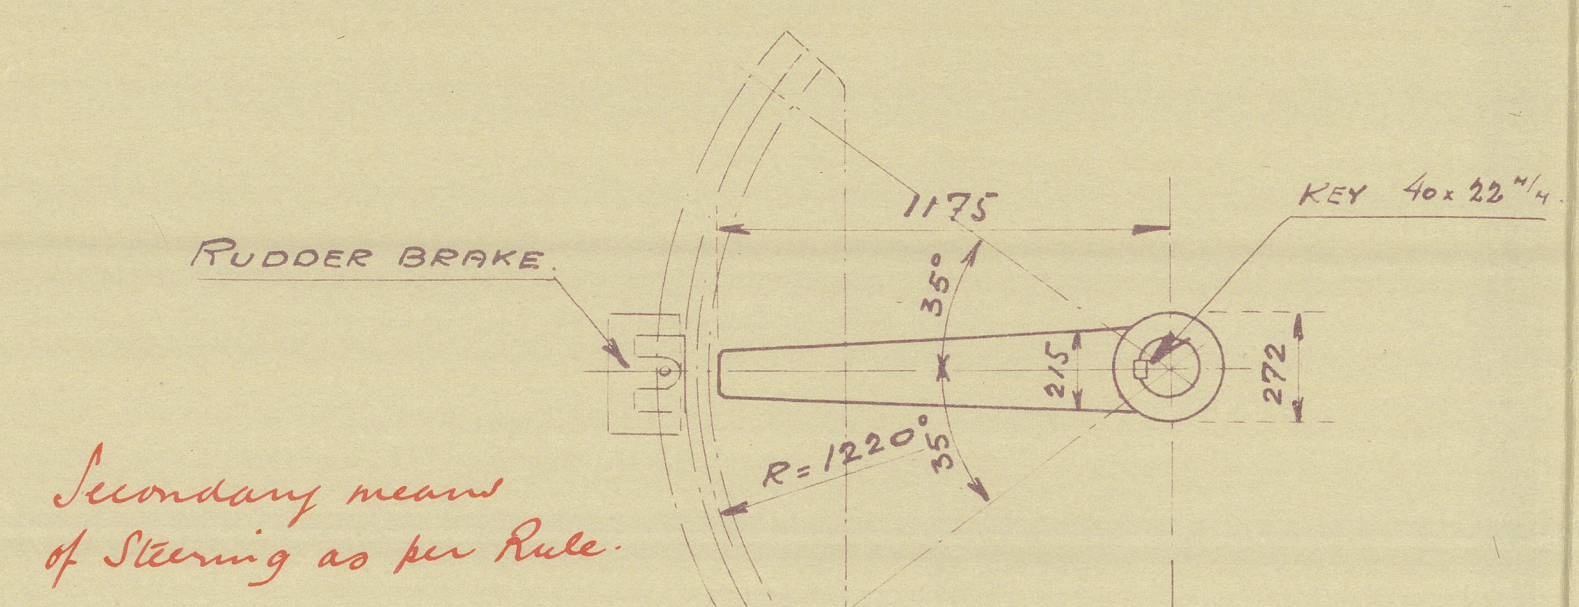











BUILDING NR. 178.
STERNFRAME AND RUDDER.
SCALE 1/20 - 1/5.

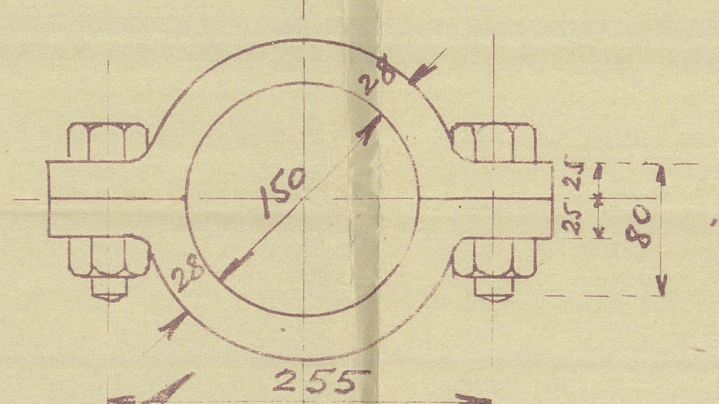

SECTION "B-B"

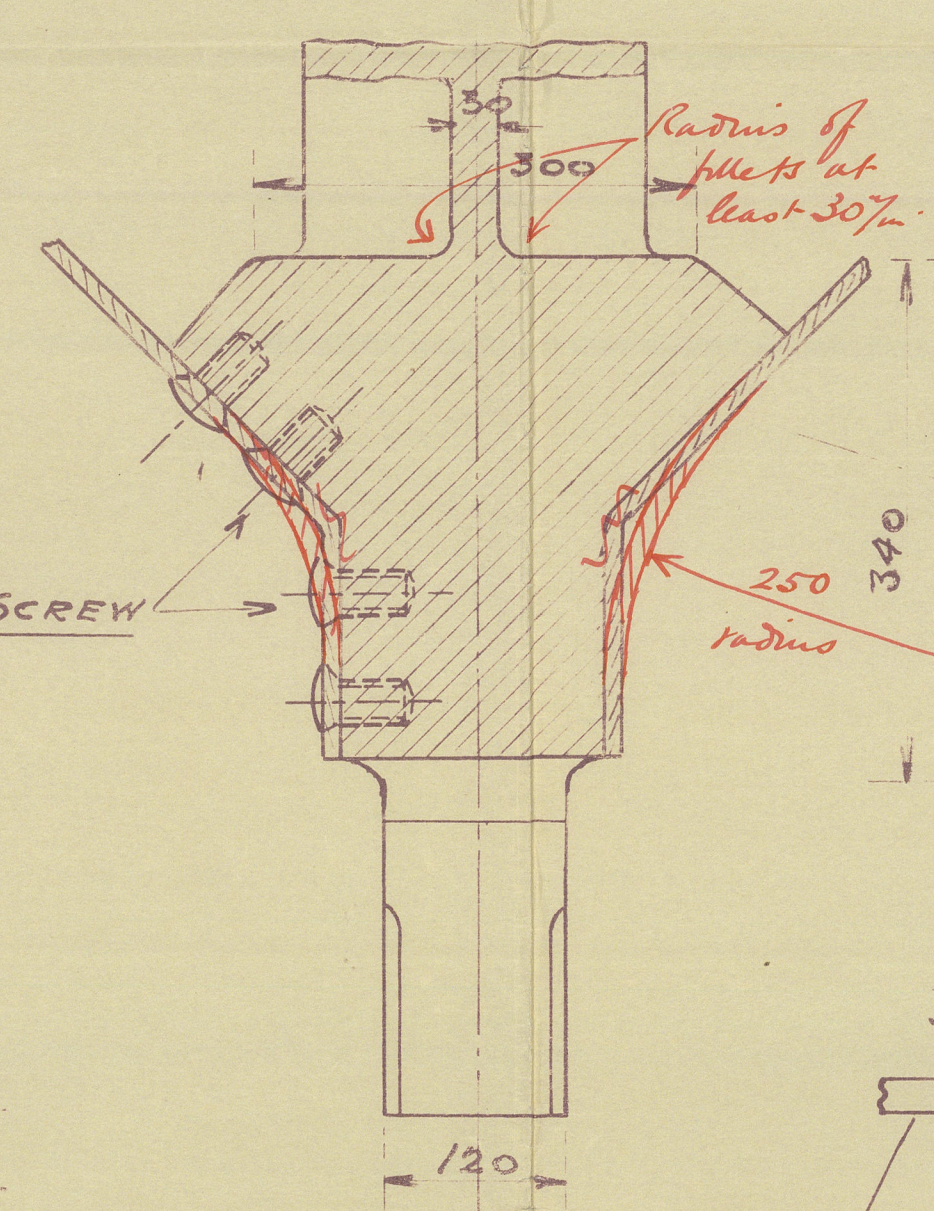

SECTION "C-C"

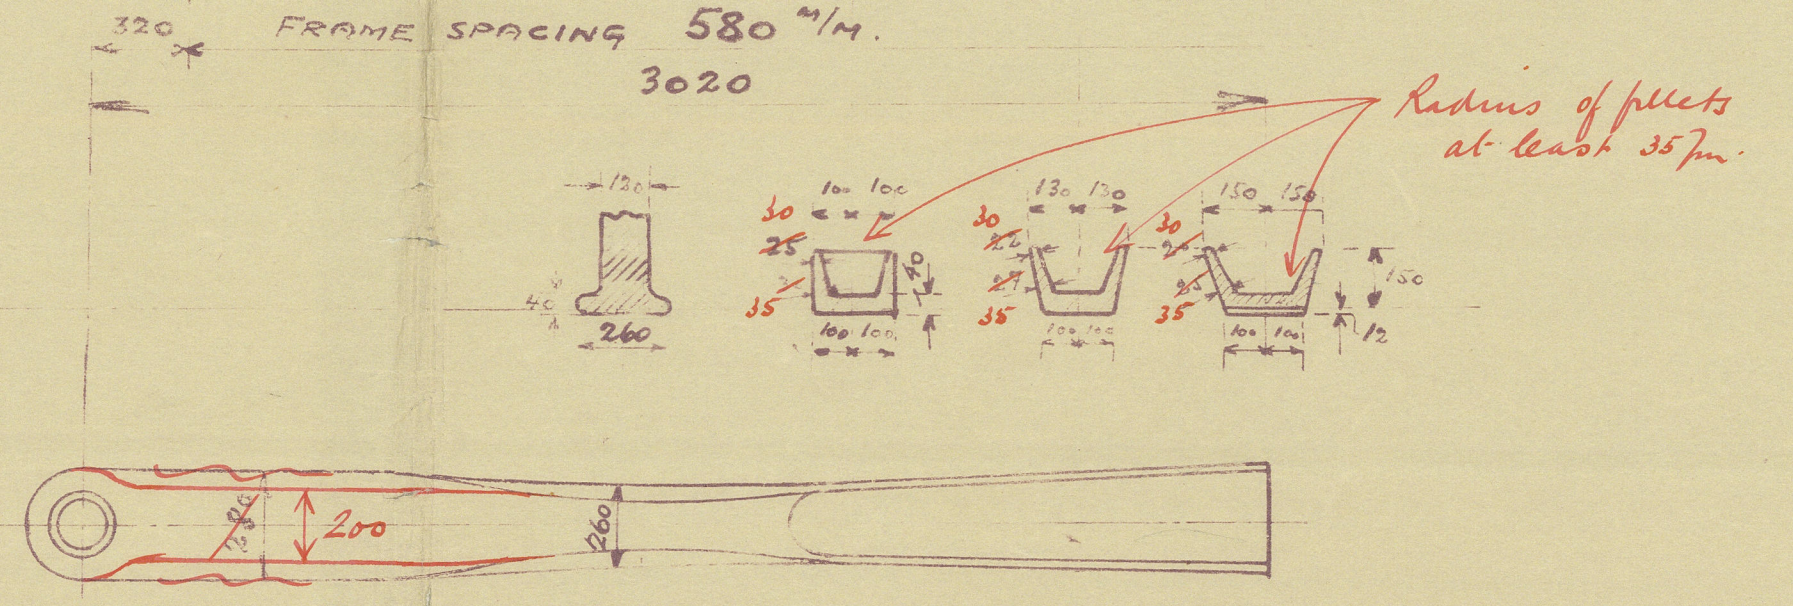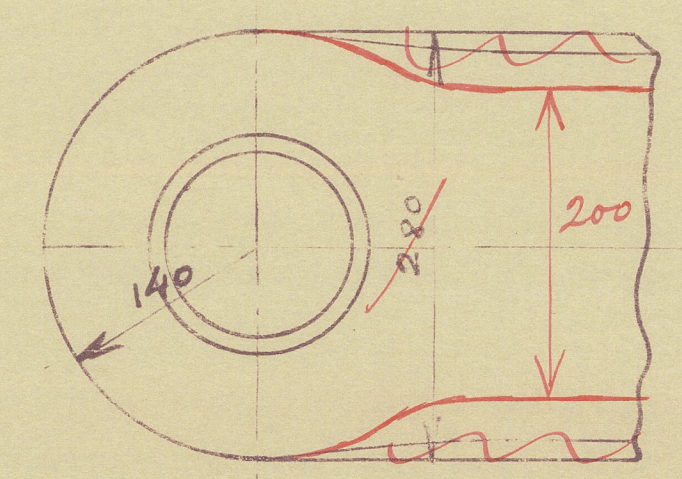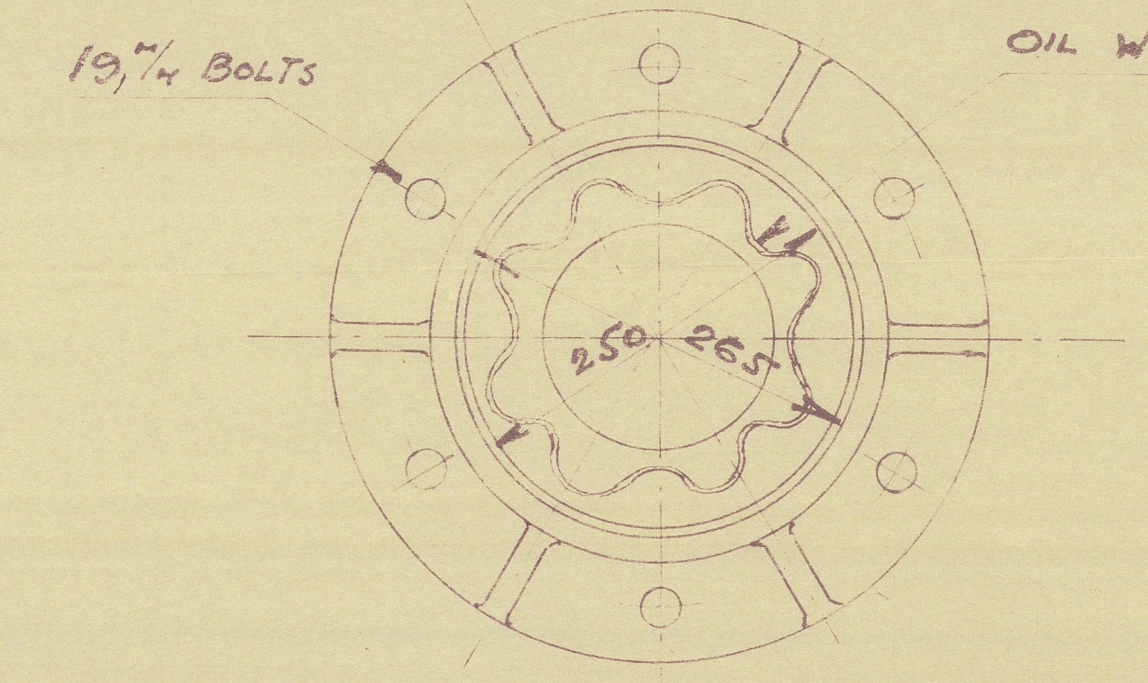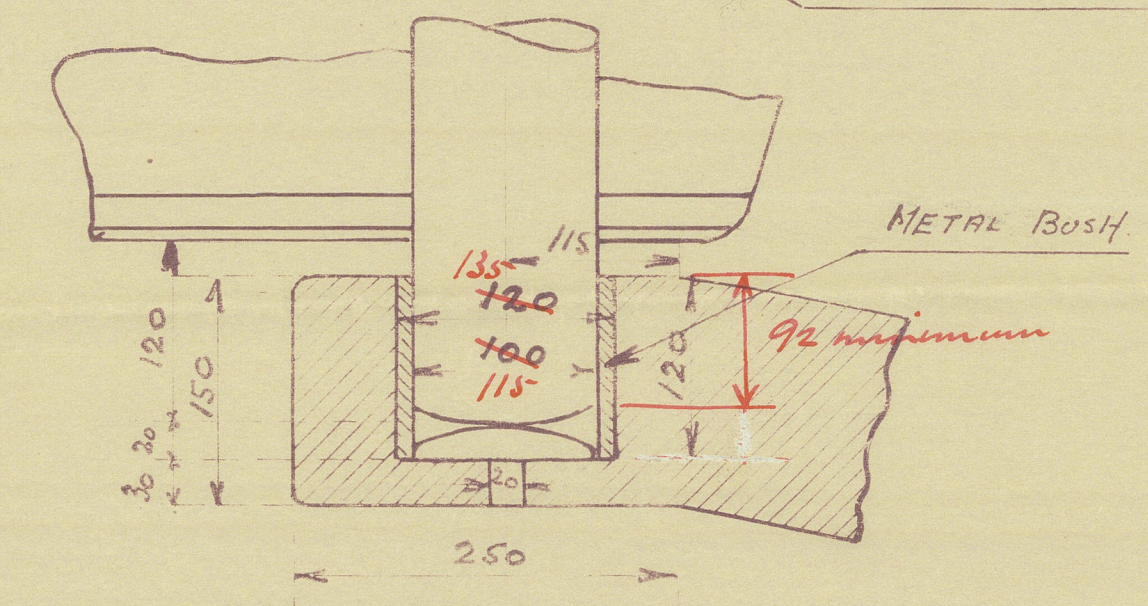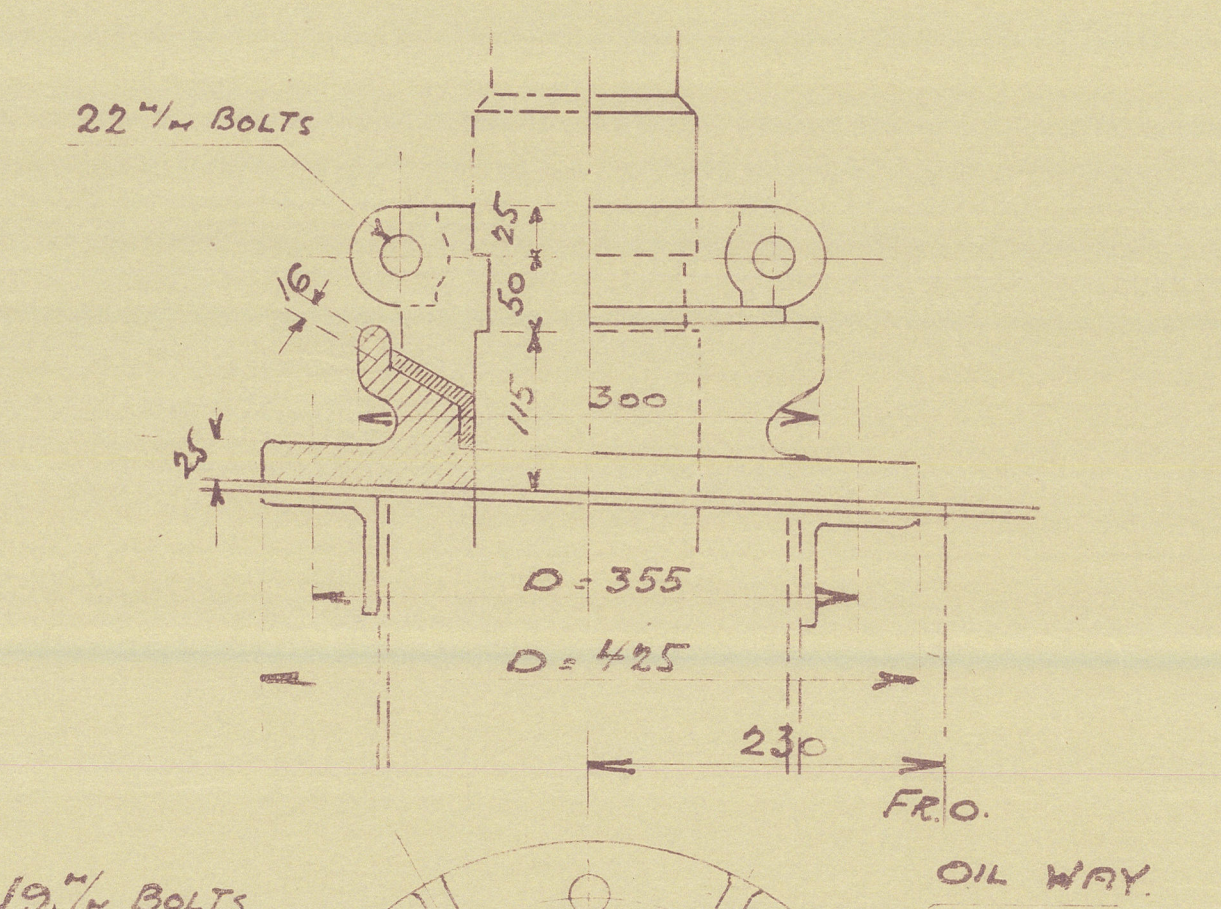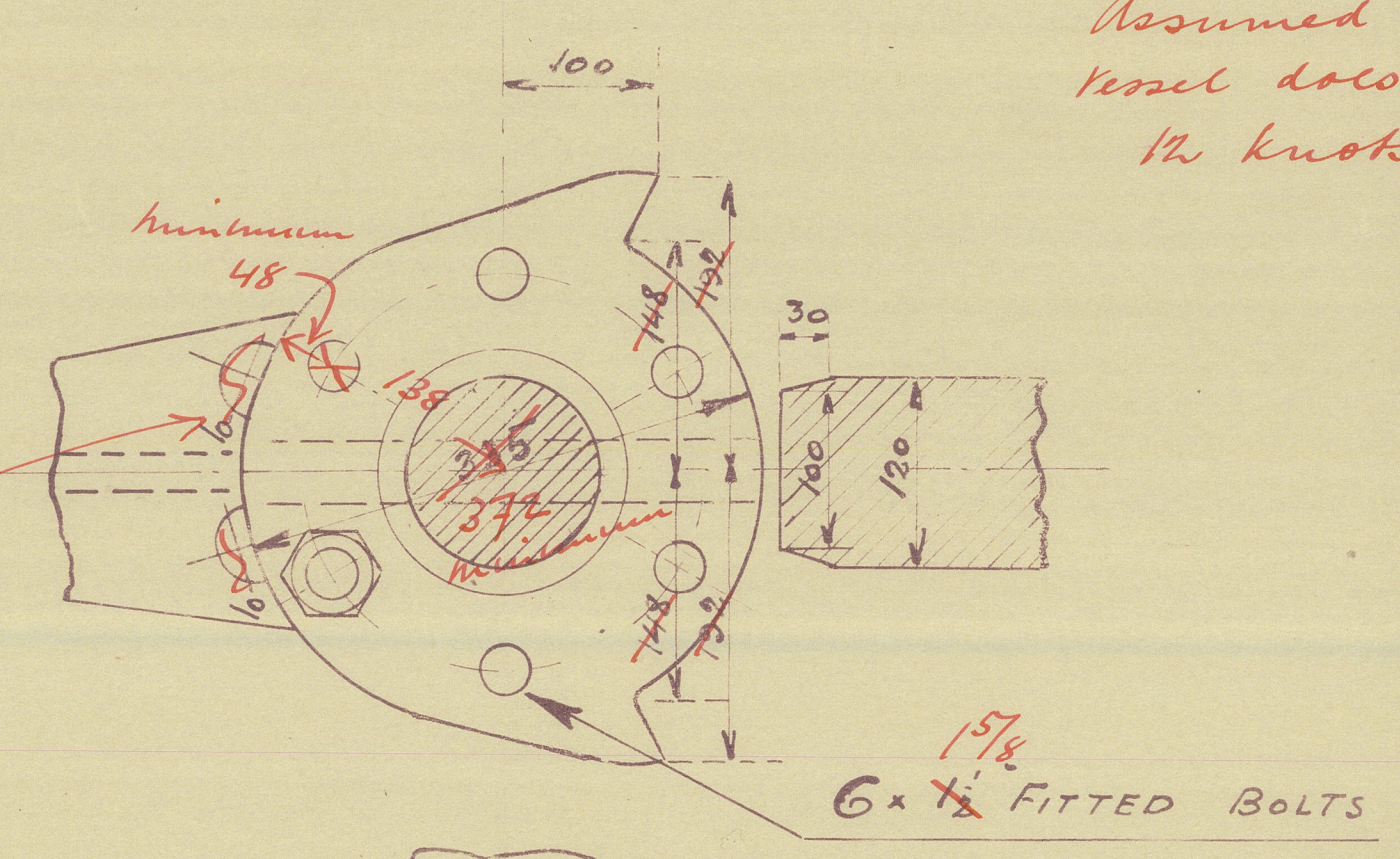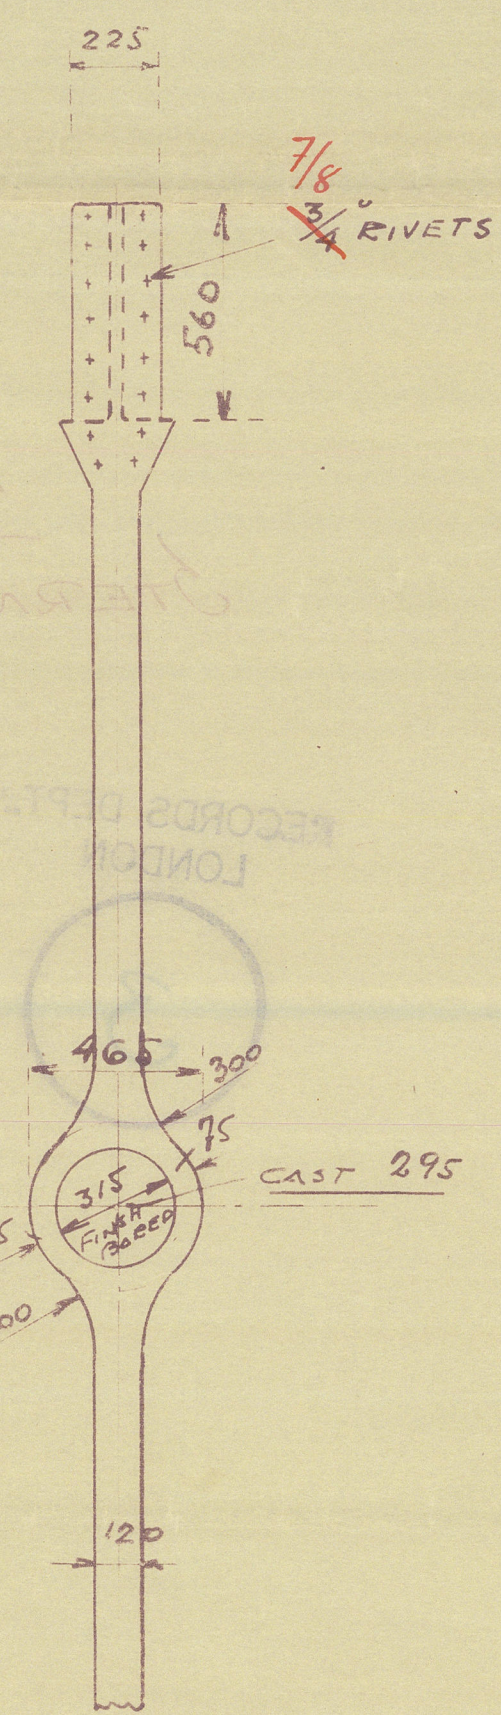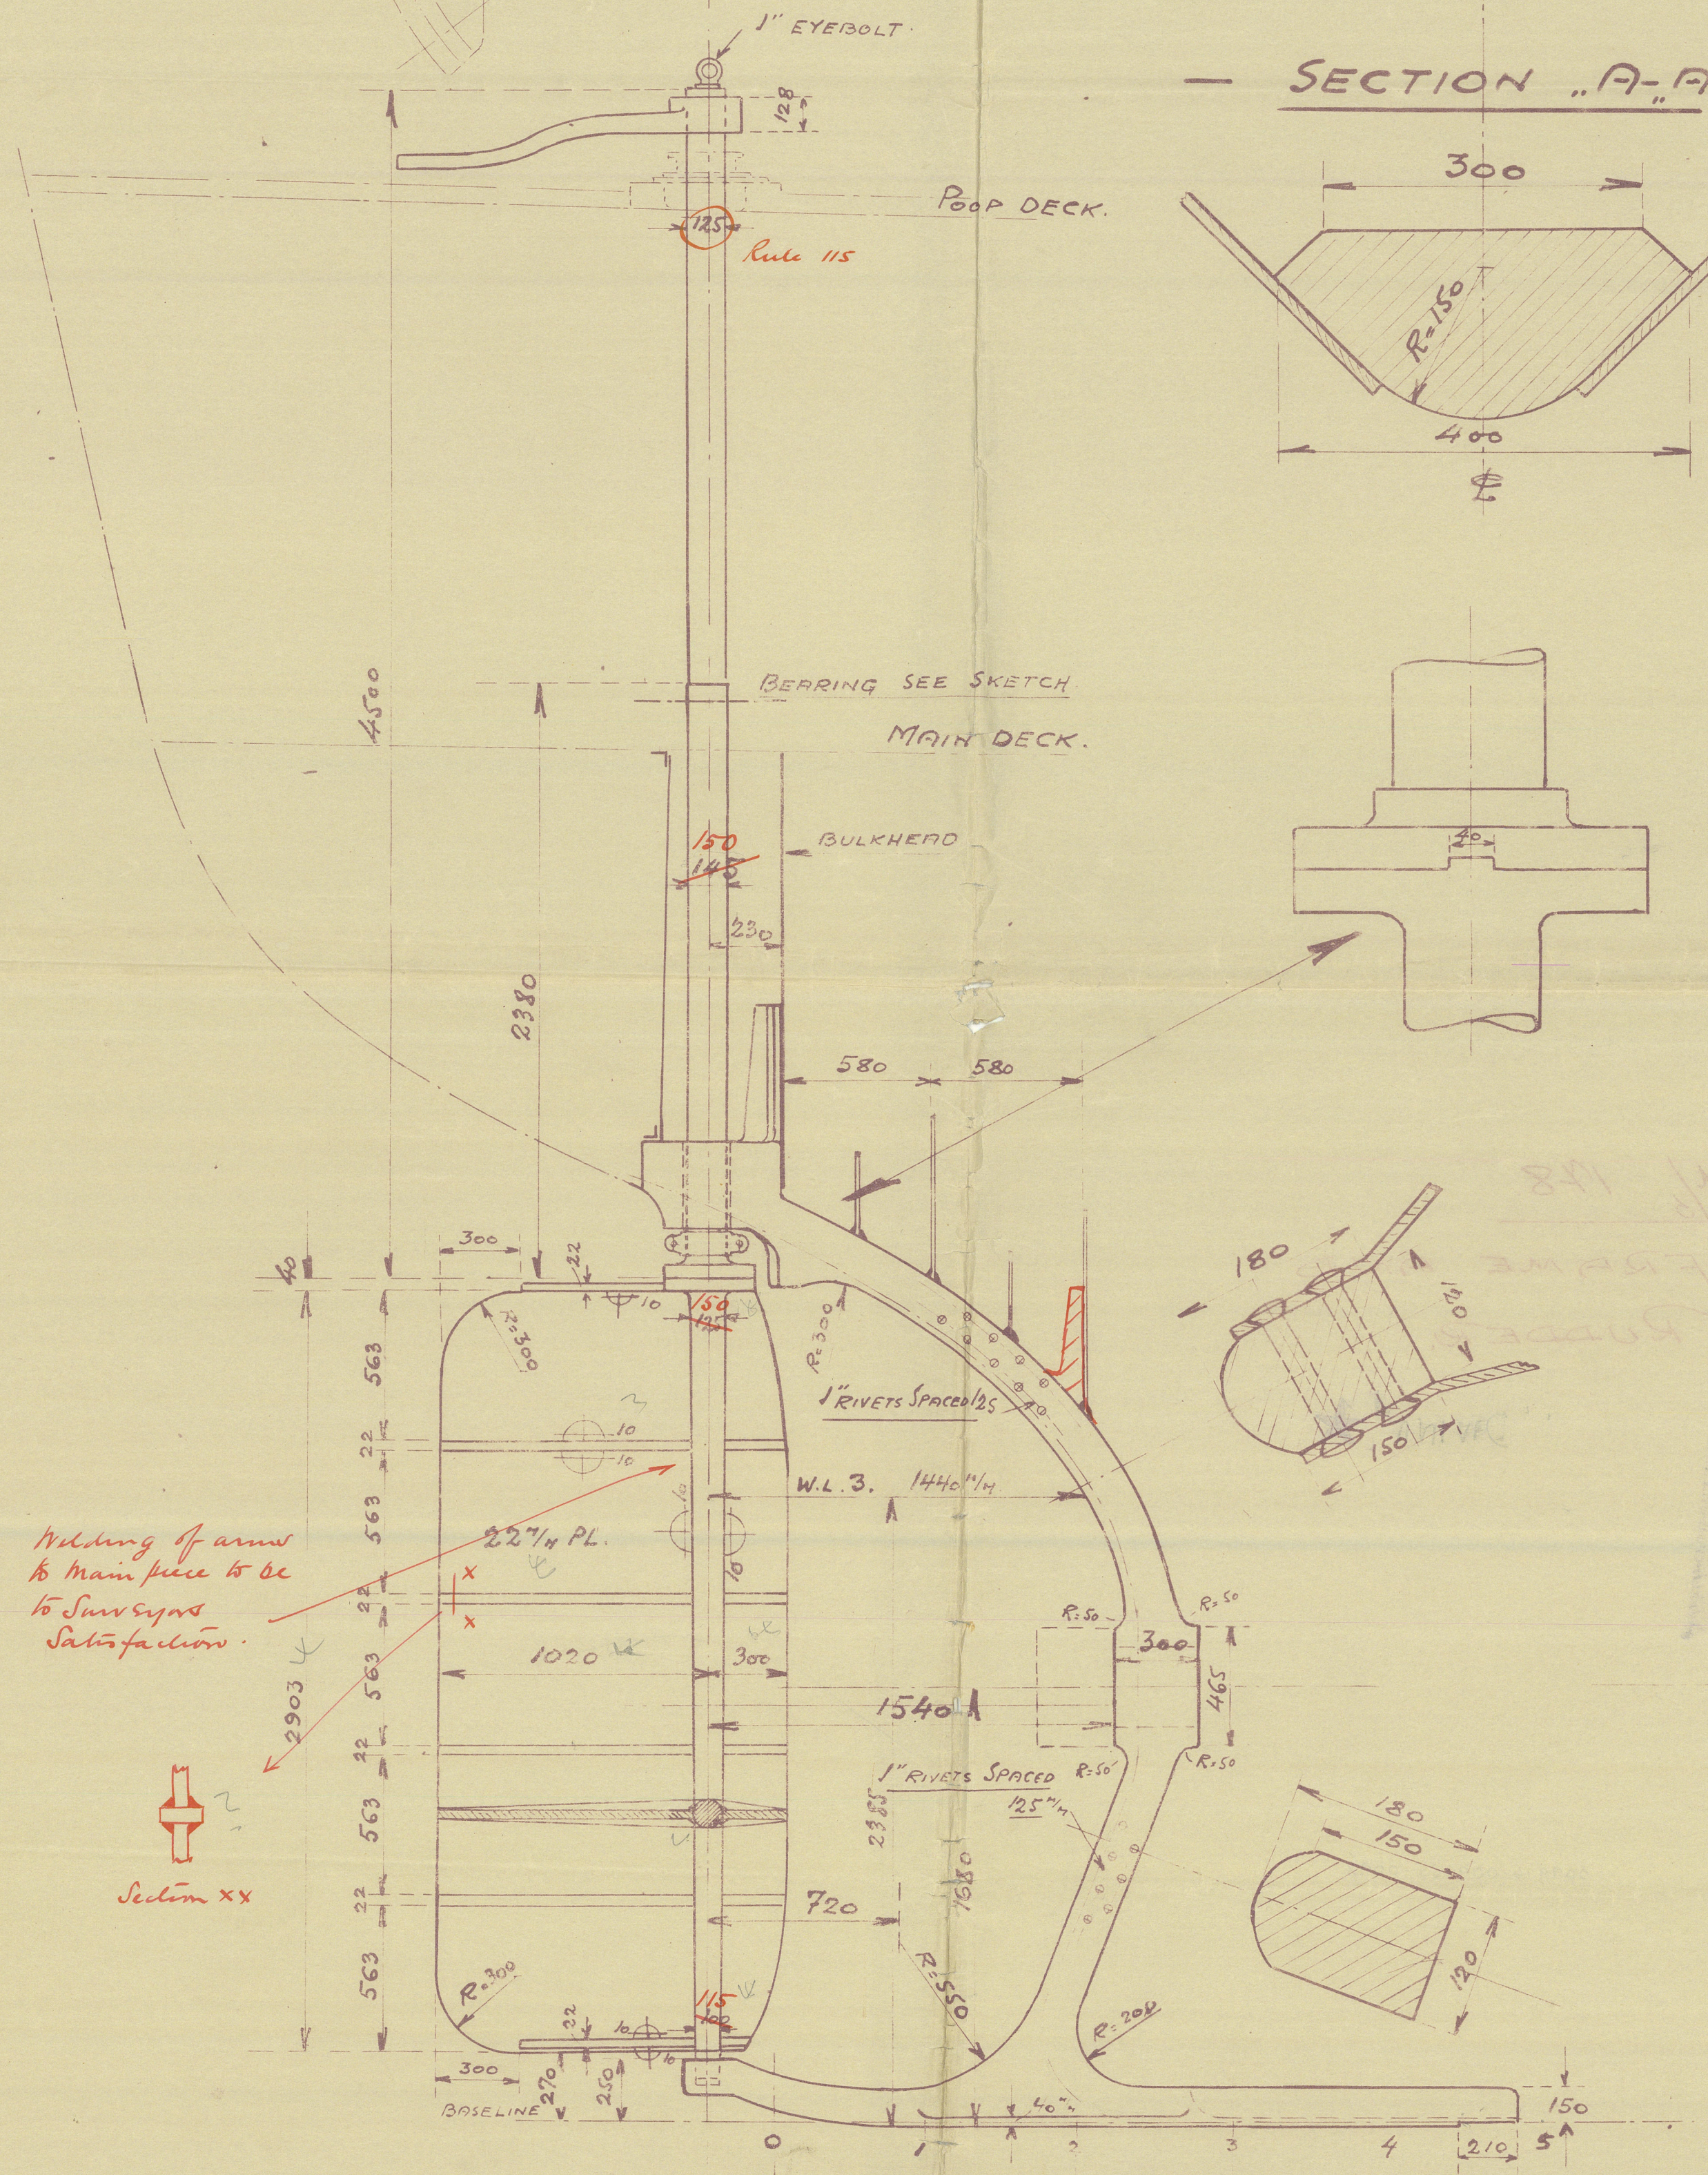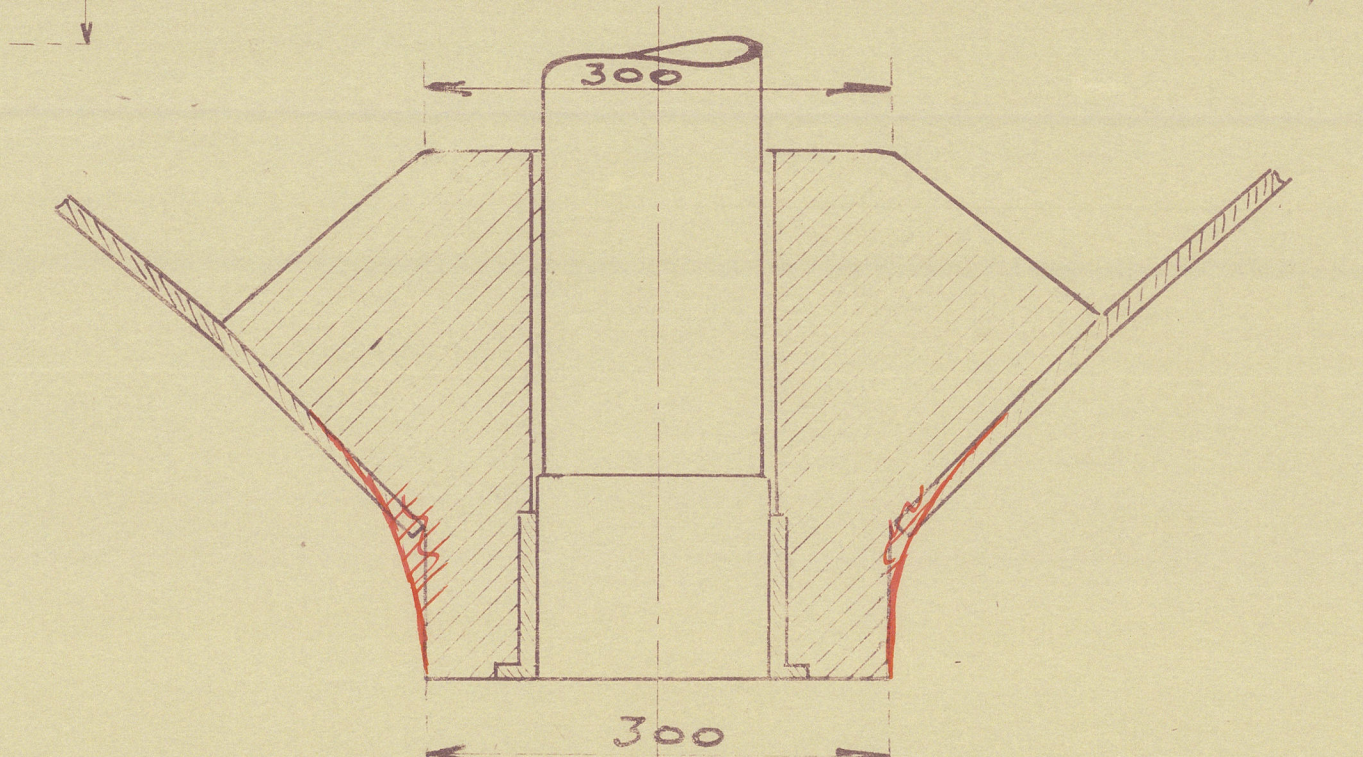

A-B. EKENSBERGS VARV
 - 178 -
 STERNFRAME AND
 RUDDER.


14
 6.6.41

M/ 178.

STERN FRAME AND
RUDDER.

RECORDS DEPT.
LONDON

3

DIV INF 



© 2021

Lloyd's Register
Foundation

009976-009985-0093