


SHIP N^{os} 468 & 472

PRELIMINARY DRAWING

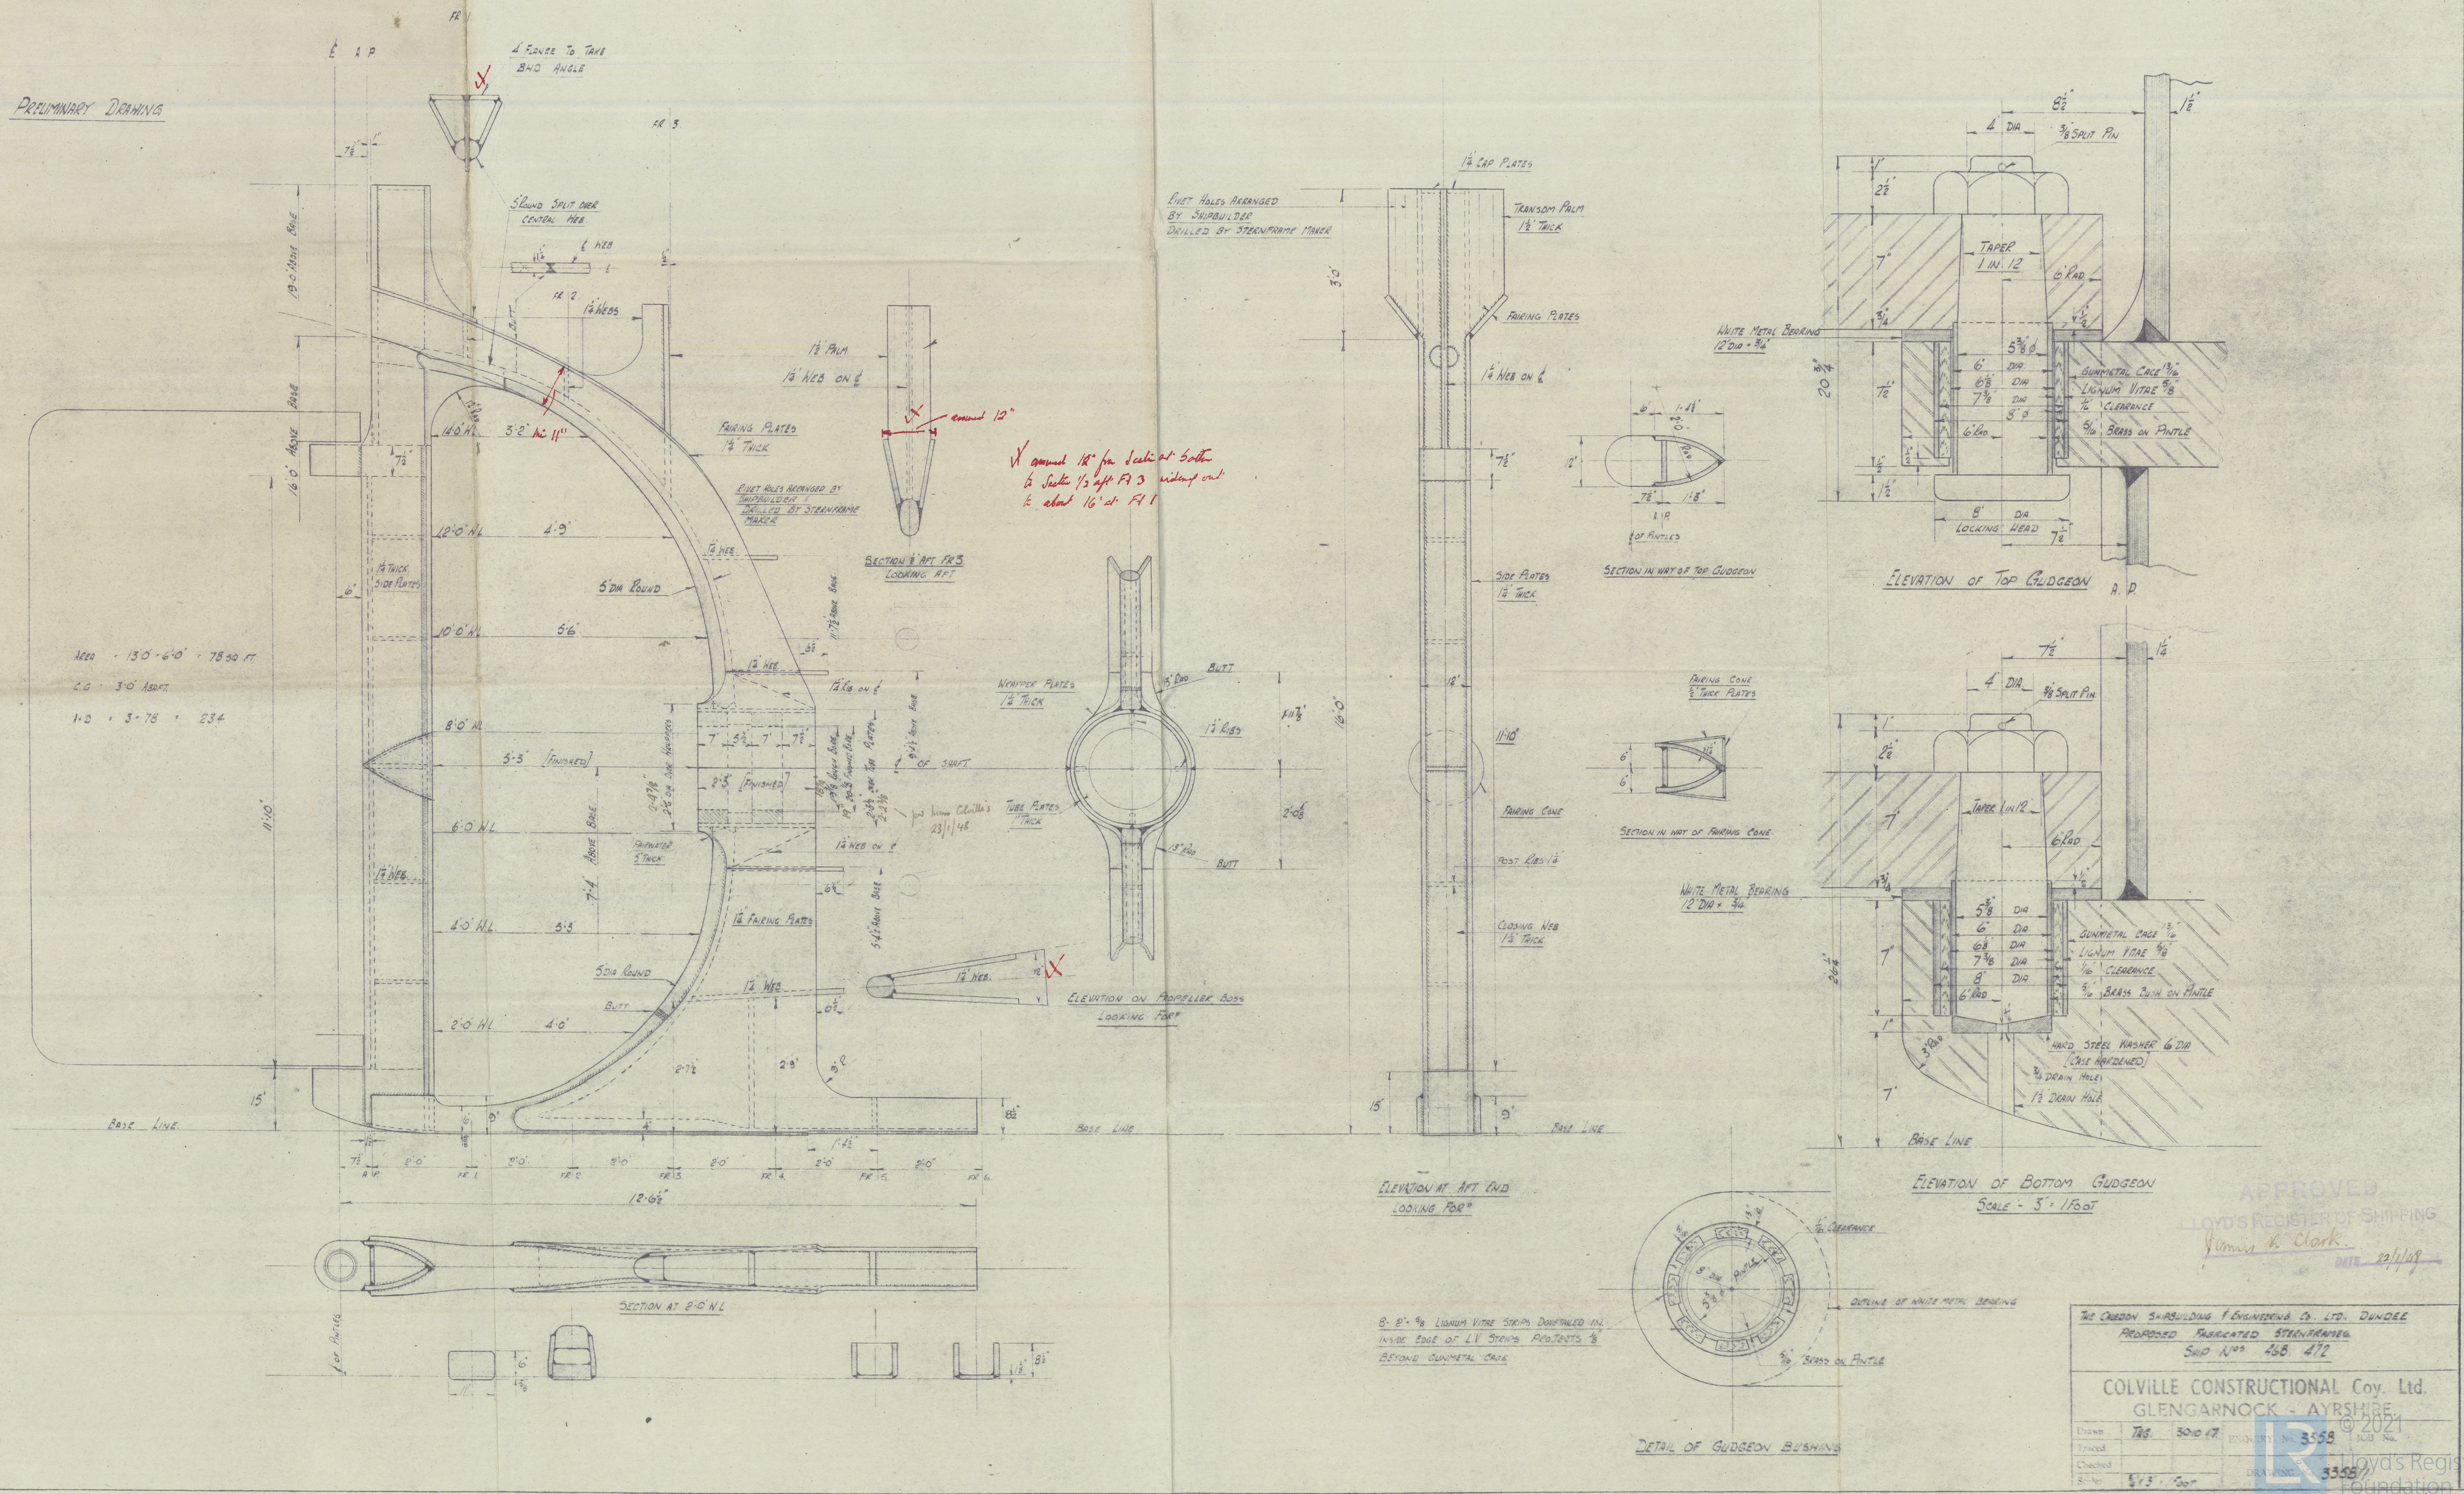

SHIP NO. 468, 472

COLVILLE CONSTRUCTIONAL Coy. Ltd.
GLENGARNOCK - AYRSHIRE


Drawn	TAG. 30-10-17	ENQUIRY No. 3358	JOB No.
Traced			
Checked			

Fabricated Sternframe

S. S. "WOODLAND" - CALEDON YARD No. 468

★ S. S. "PINELAND" - CALEDON YARD No. 472.

RECORDS DEPT.,
LONDON

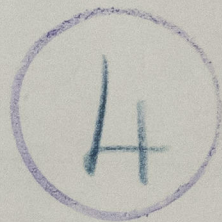

© 2021

Lloyd's Register
Foundation

009976-009985-0159