
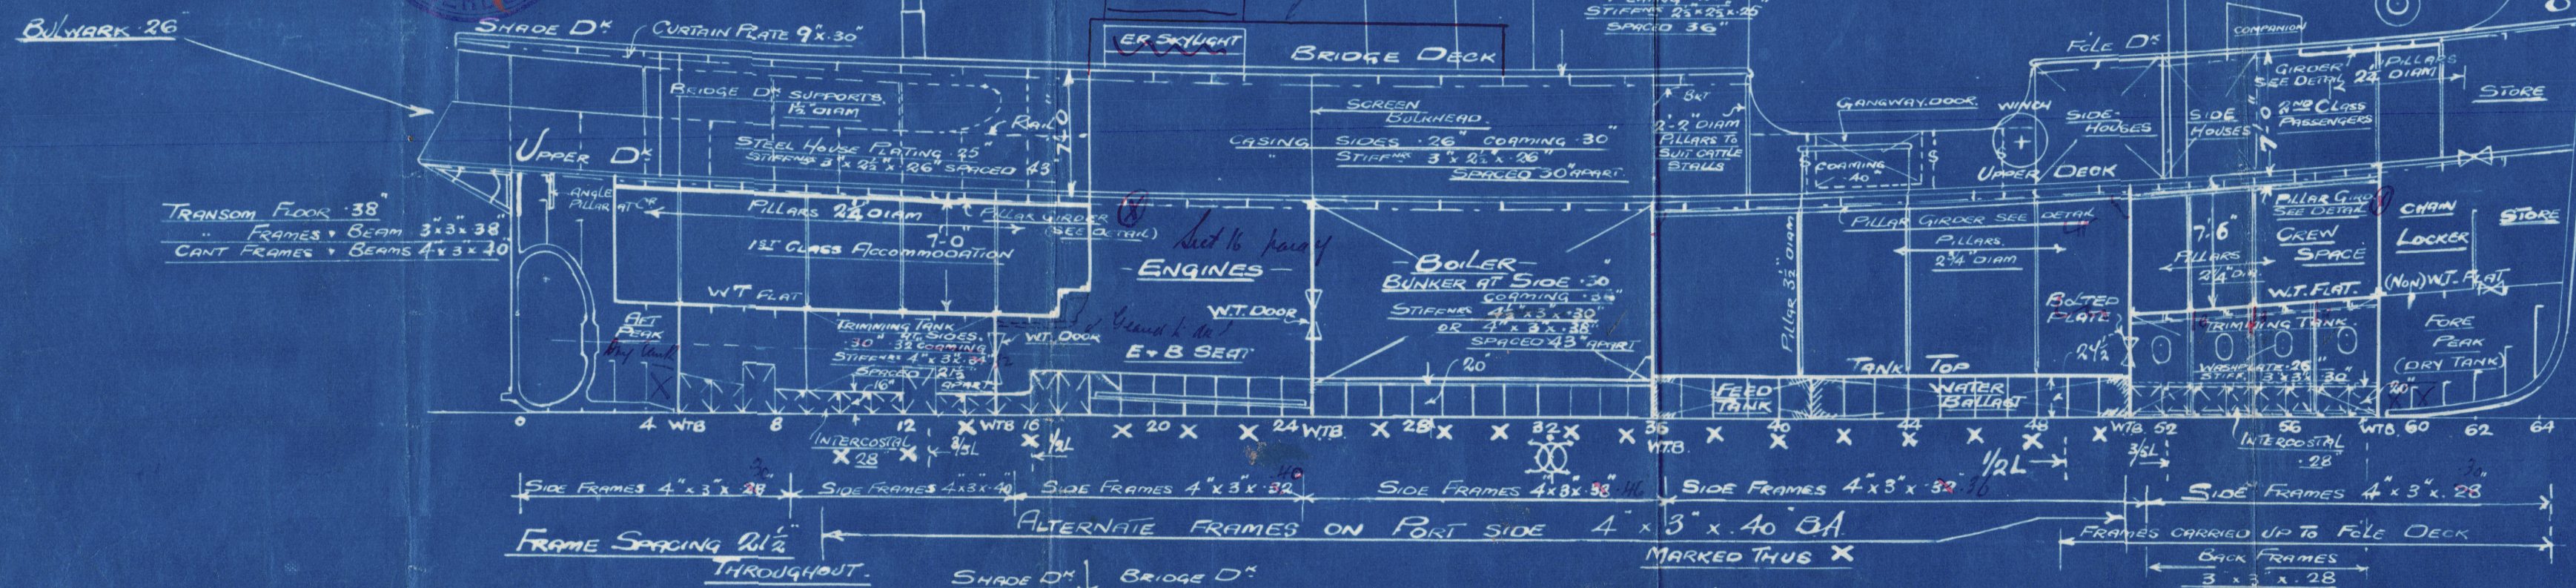


-N^o 718- (DIMENSIONS 117'-0" BP X 24'-0" BDN M^o X 11'-6" DEPTH M^o)


-PROFILE & DECK PLANS-

-SCALE 1/8" = 1'-0"




-TO CLASS 100 A1-

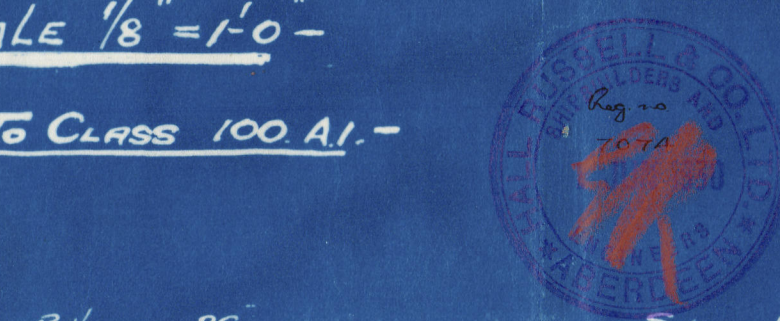

GIRDER IN ACCOMMODATION AFT, UNDER FOLE D^o
IN WAY OF BULB A BEAM (TO GIVE HEAD ROOM)

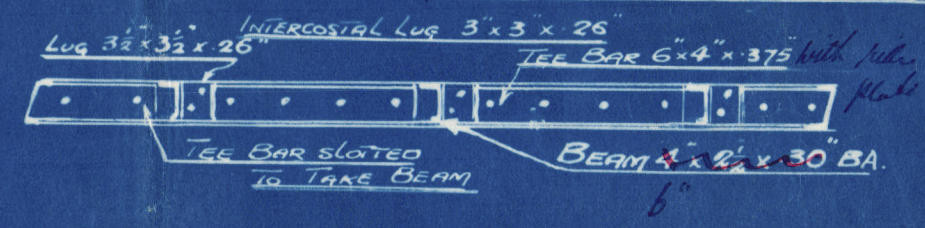

*Welding of Bottom
forward to be submitted

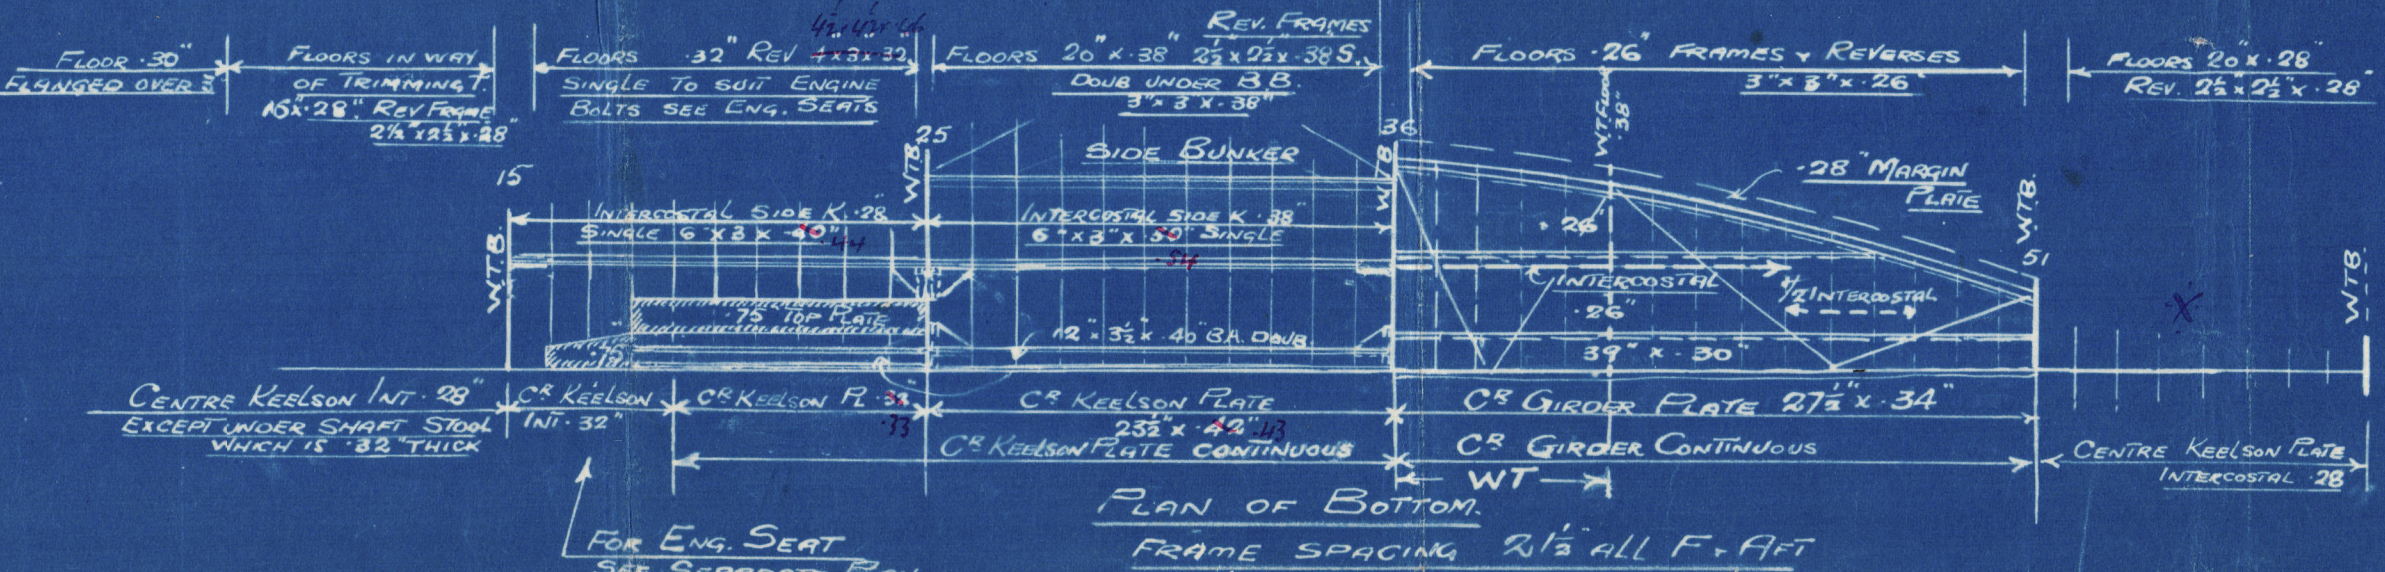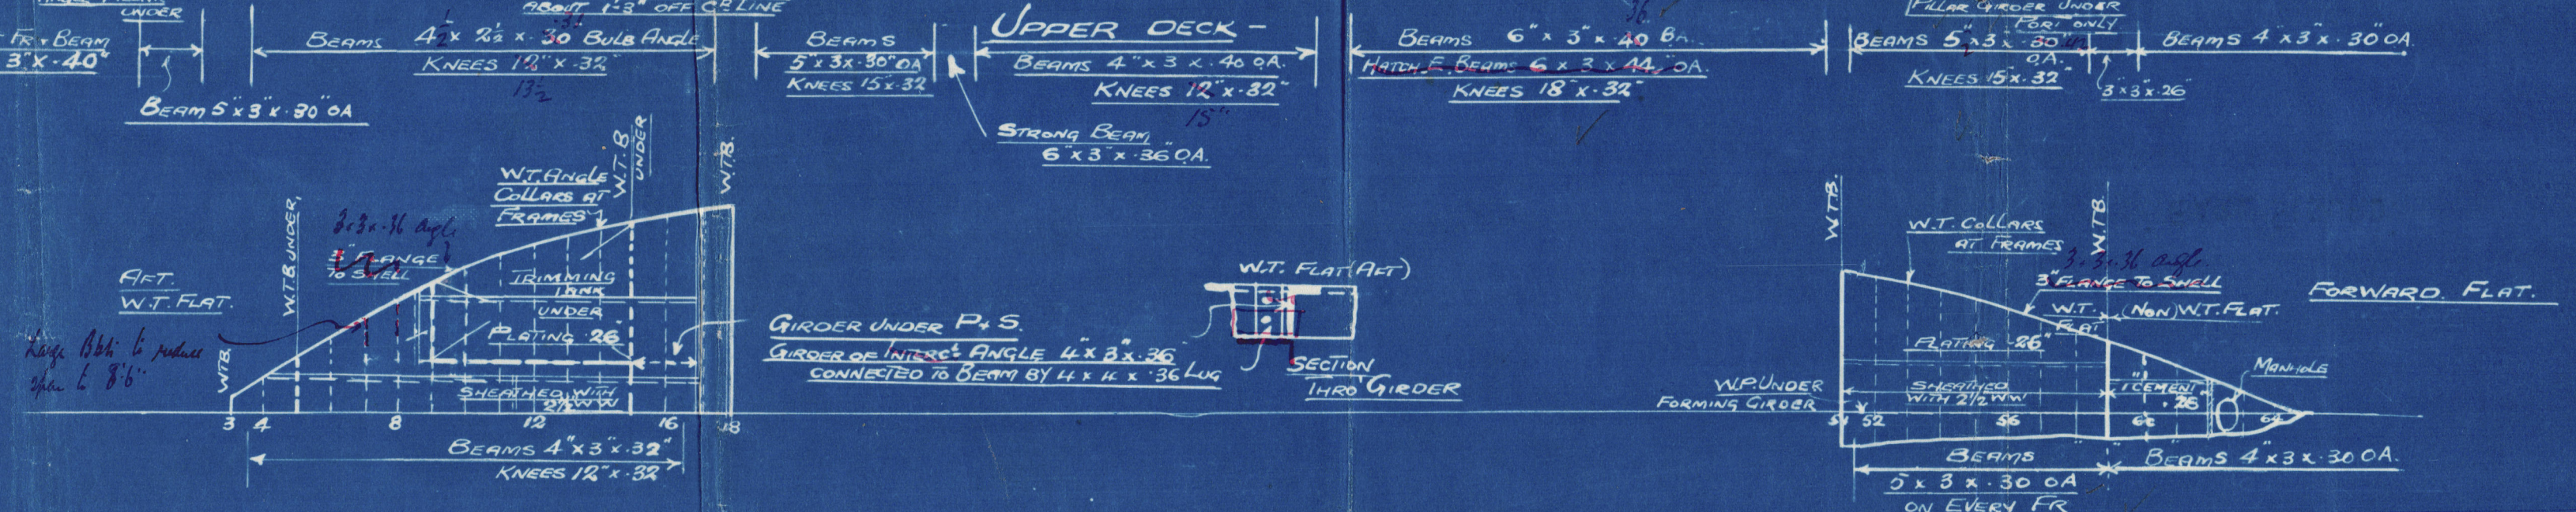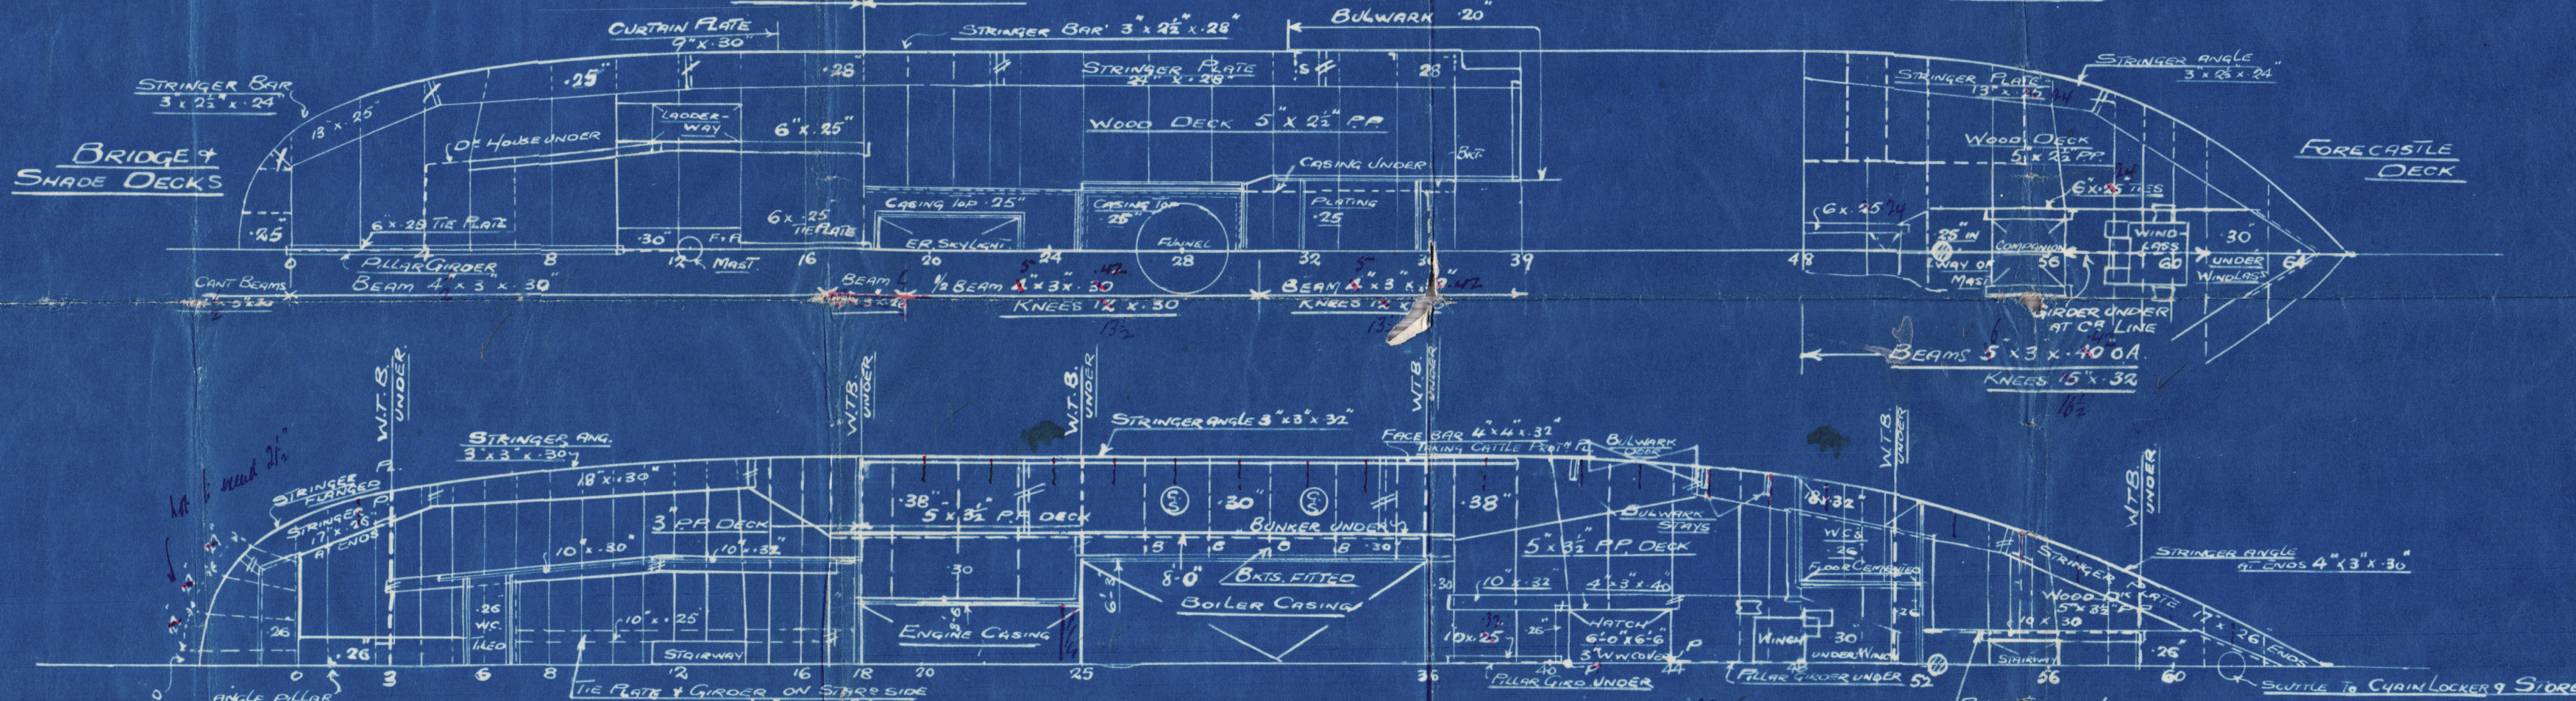

APPROVED
LLOYDS REGISTER OF SHIPPING

17.6.30



Hall, Russell & Co. L td.,

No. 718.

Profile & Decks.

=====

S. S. "EARL SIGURD."

abu. Report. 16451.



© 2021

Lloyd's Register

609986-009993-0047