

# S. S. N<sup>os</sup> 88 & 92.

## MIDSHIP SECTION.

TO CLASS LLOYD'S 100A1.

EQUIPMENT	LETTER R
LONGITUDINAL NUMBER	17290.0
RAISED QUARTER DECK	84.21.4
POOP DECK	18.75.7.75
BRIDGE DECK	64.62.7.75
FOKLE DECK	22.63.7.75
CASING	66.60.7.75




EQUIPMENT	NO
2 CORNER ANCHORS	35 1/2 CENTS EACH
1 STREAM	80
1 REDGE	9 1/2
240 FATHOMS	1/16" STUD LINK CABLE
75	4" STEEL WIRE STREAM
30	2 1/2" 30
2 1/2" 30	2

LENGTH BETWEEN PERPENDICULARS 120.0  
BREADTH MOULDED 21.0  
DEPTH MOULDED 21.0

SCALE 1/2" INCH = ONE FOOT

LLOYD'S NUMERALS:  
S = 40.5  
Q = 21.0  
L = 280  
17220" LONGITUDINAL NO  
ADD FOR ERECTIONS 1111.07  
16531.07 EQUIPMENT NO

MOULDED DEPTH 21.0  
D.B. TANK 3.0  
R.Q. DECK 4.0  
D. 11.20 TO R.Q. DECK  
D. 13.33 TO UPPER DECK

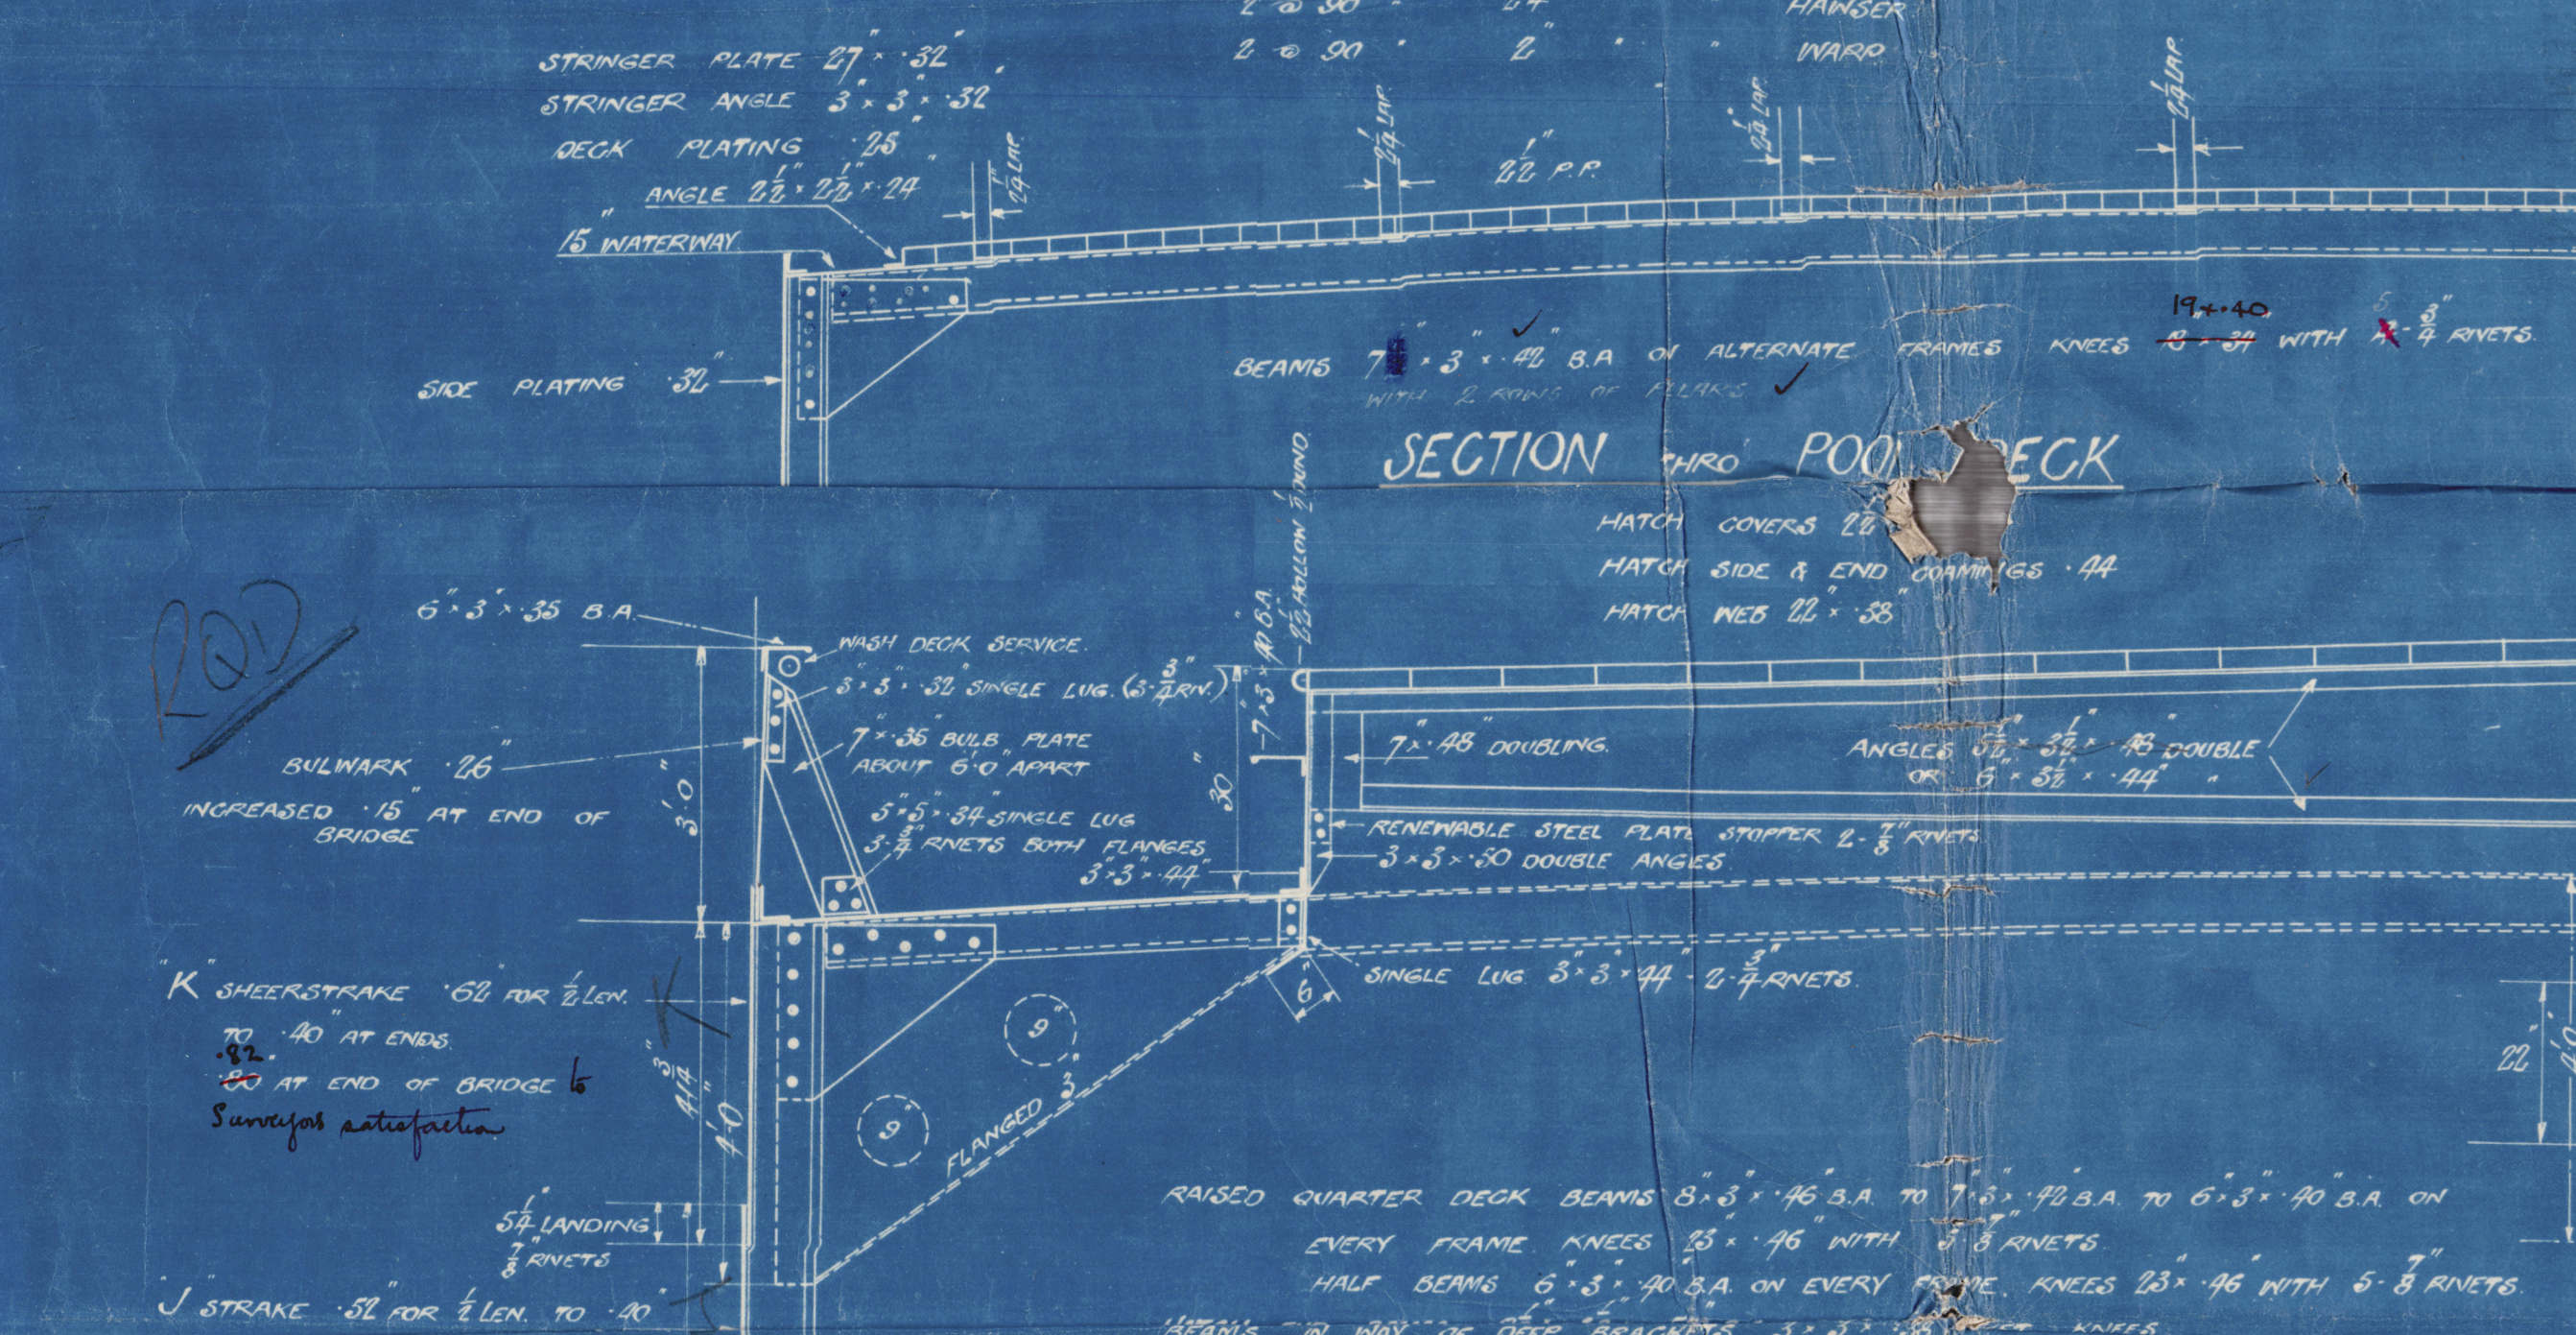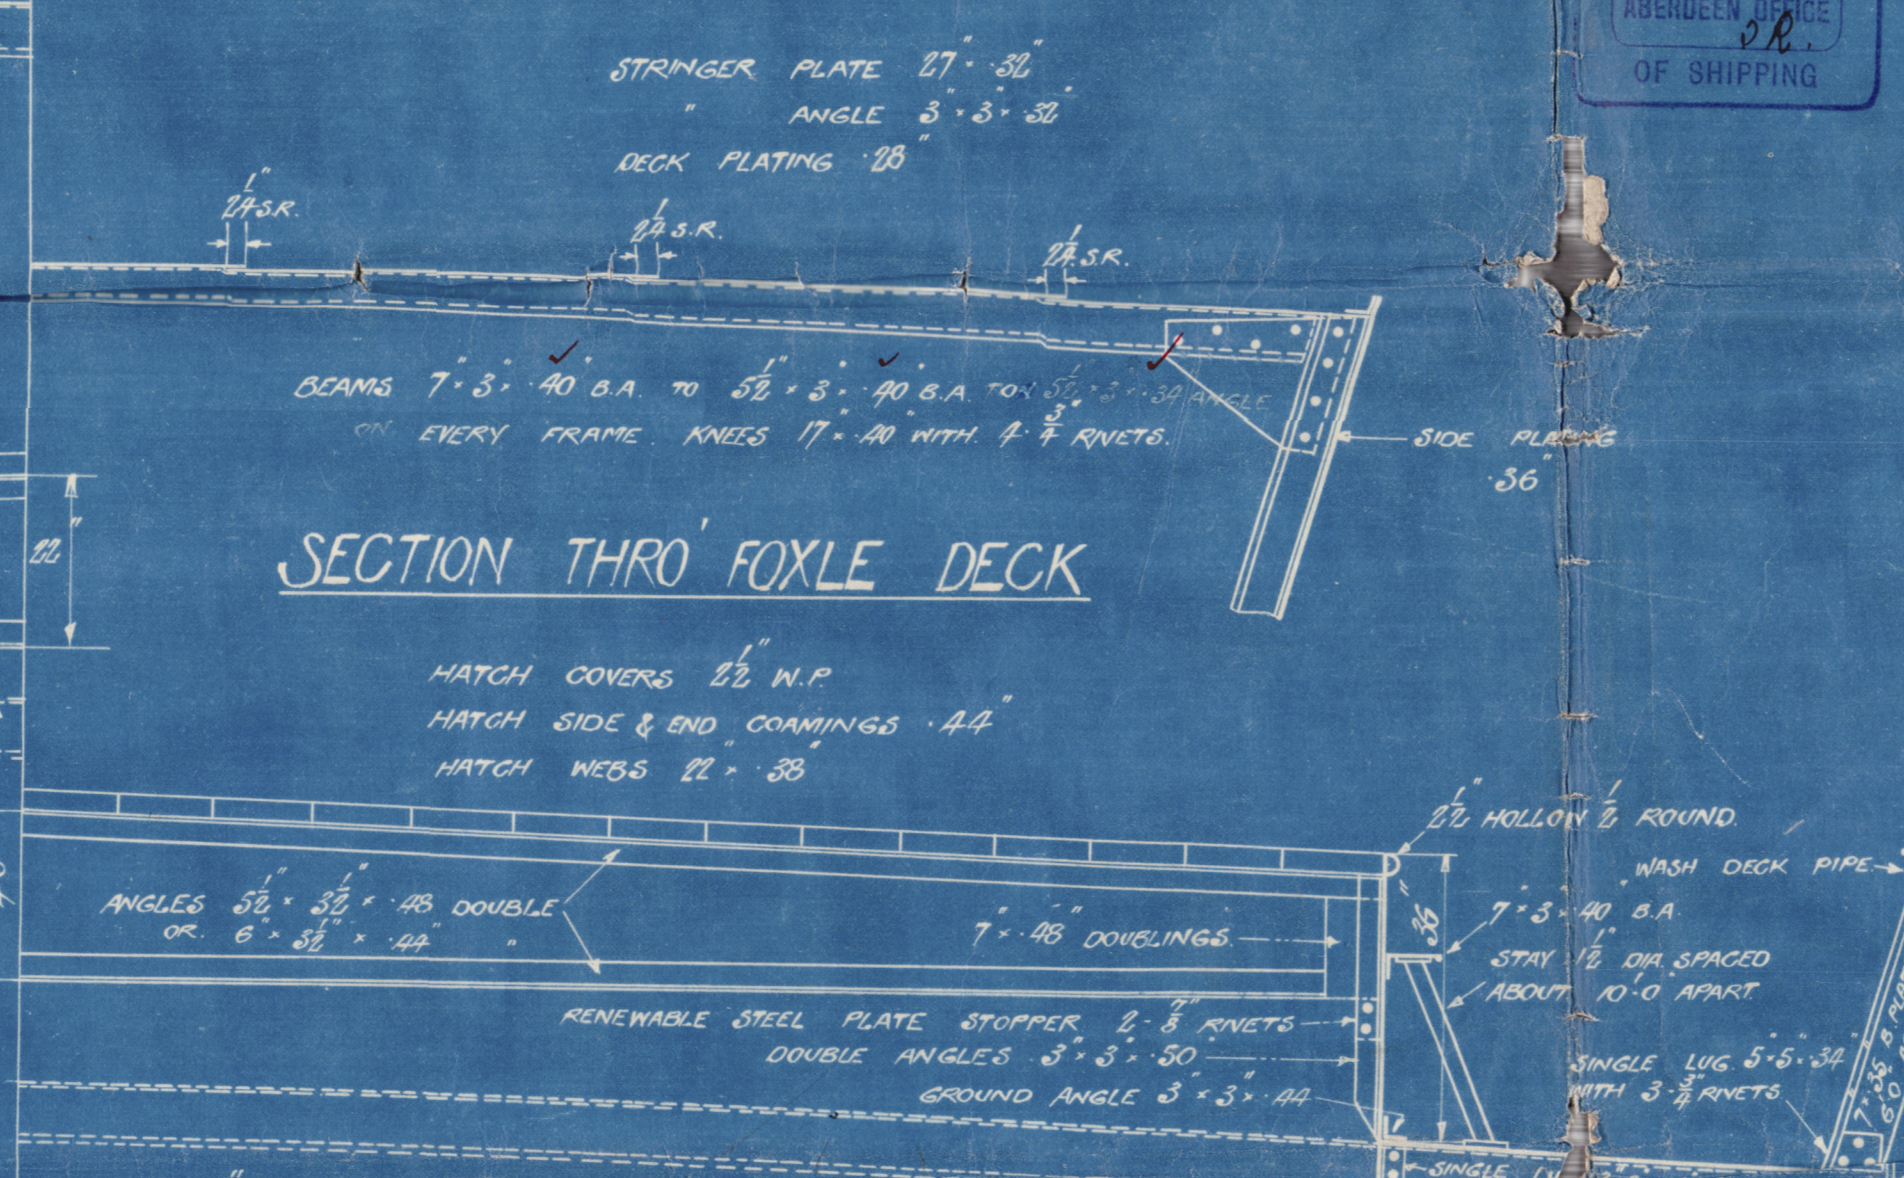
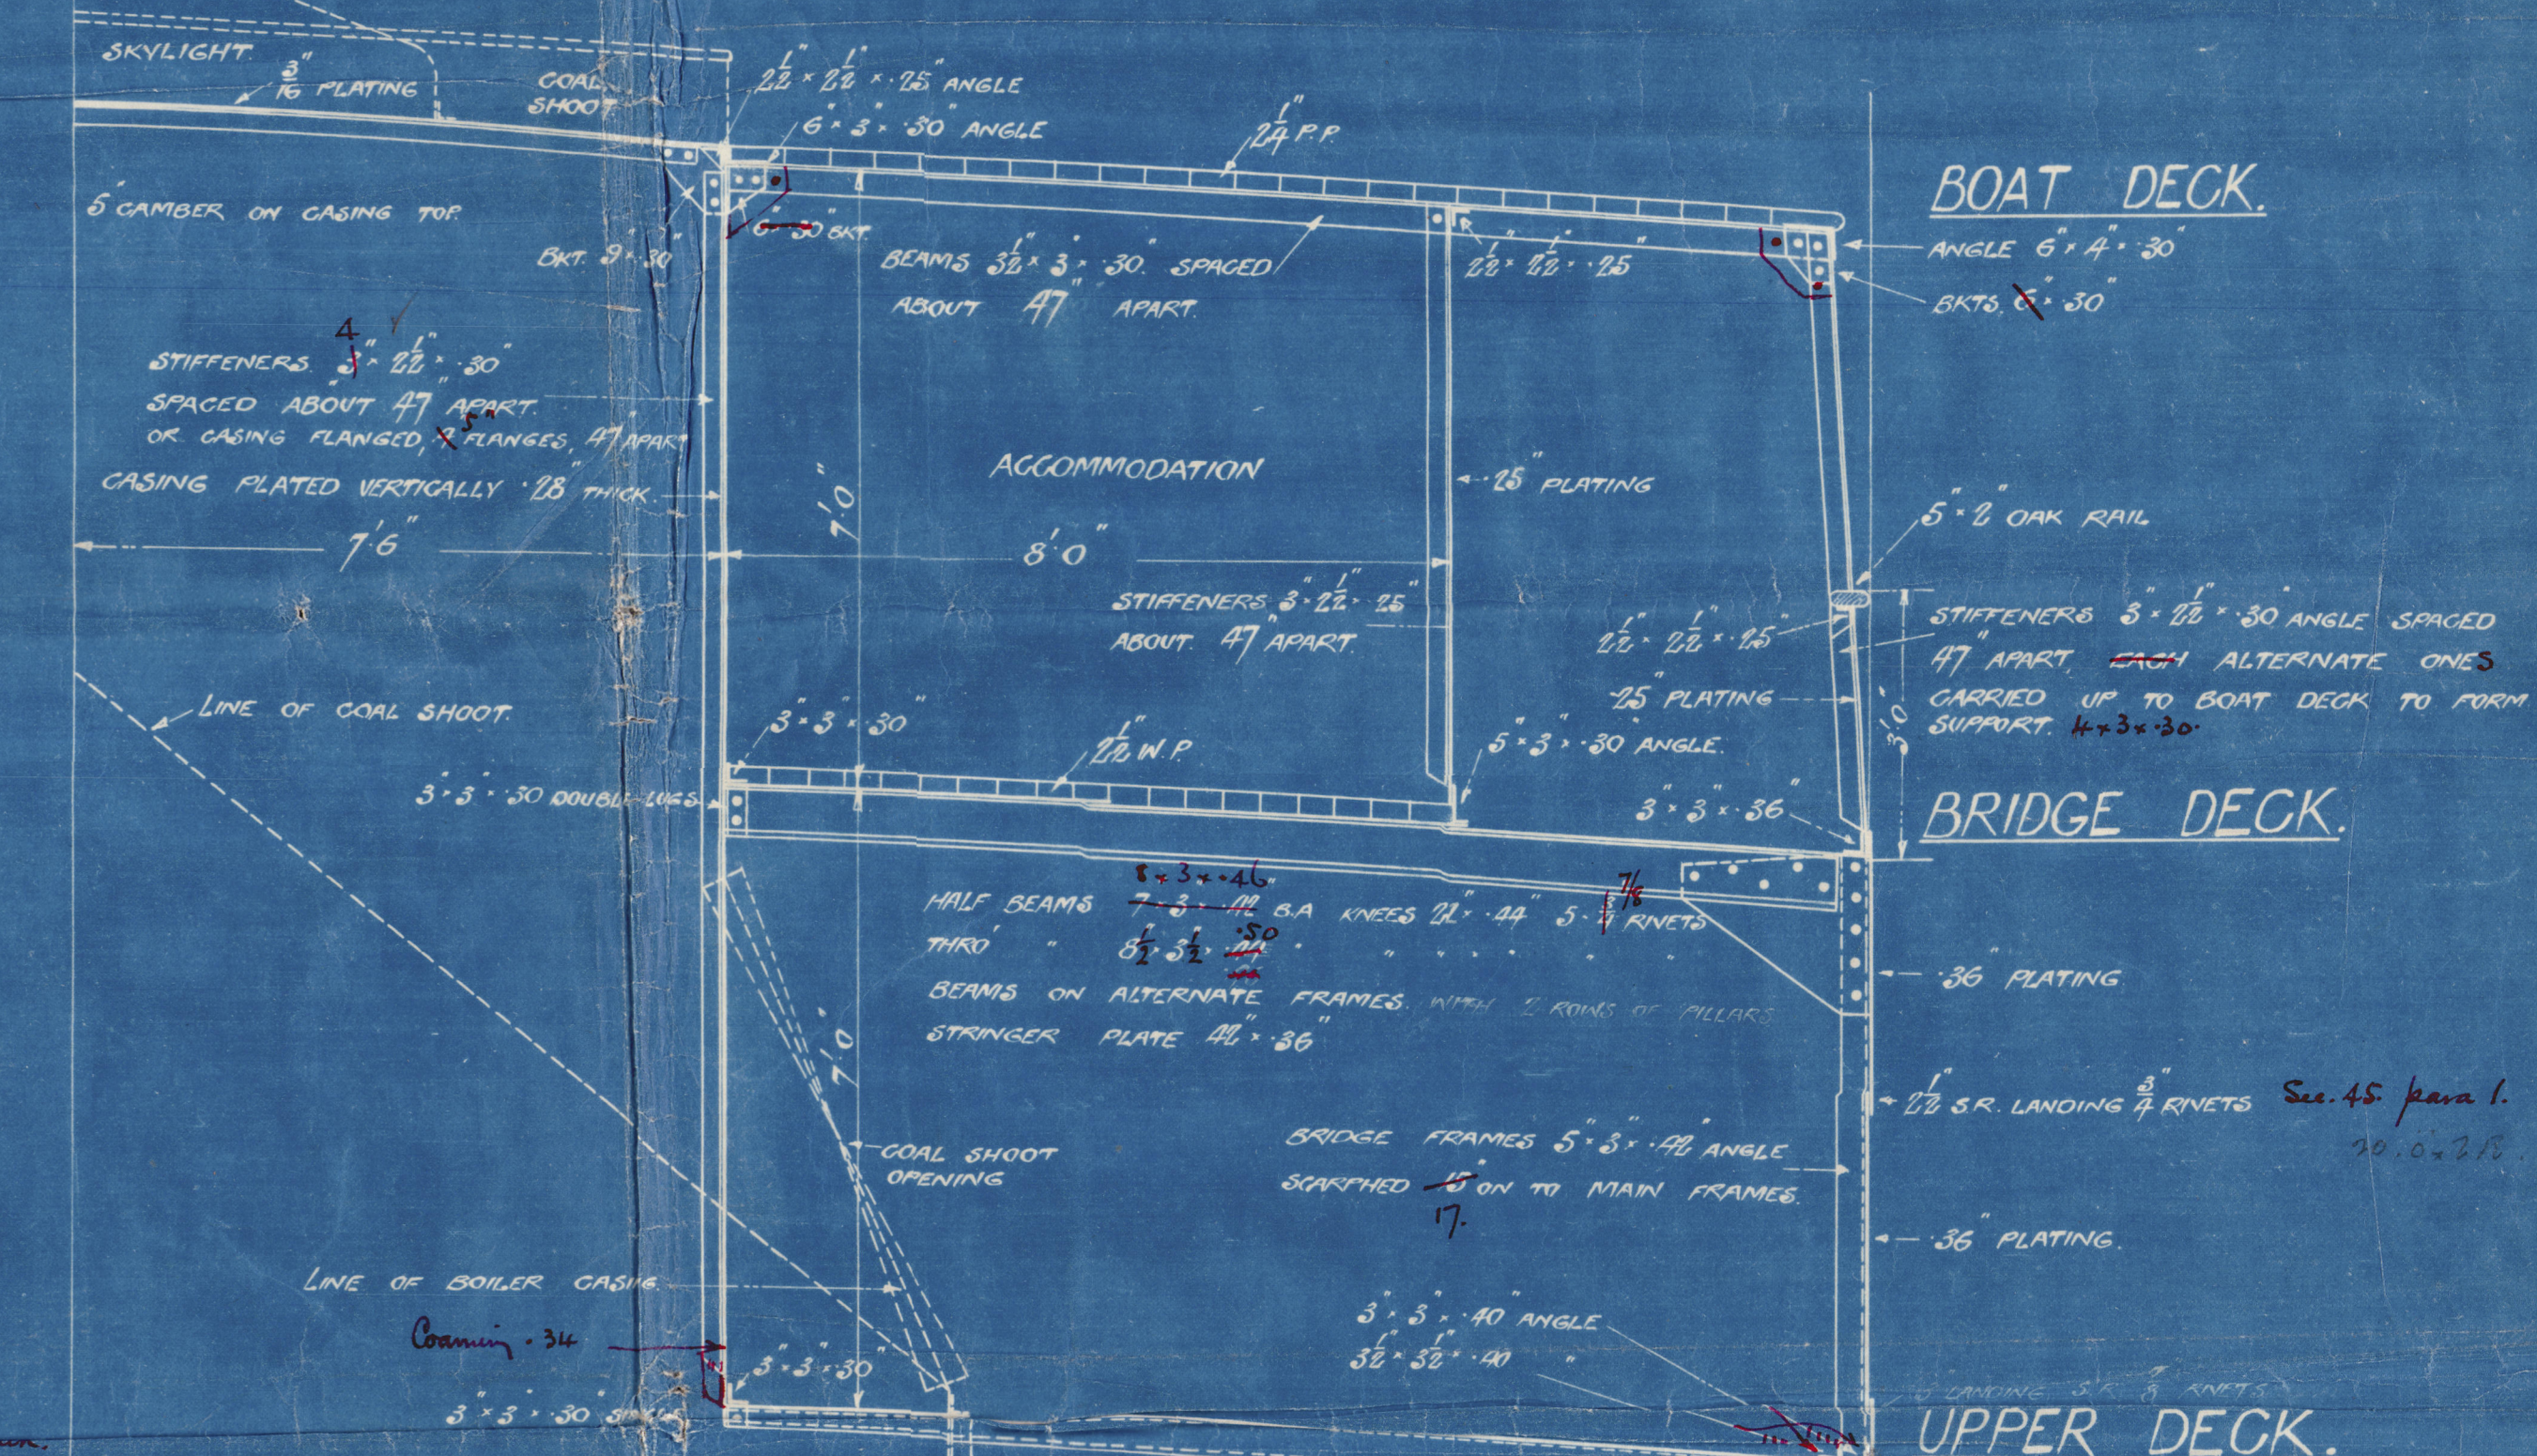


### RIVETING

KEEL PLATE, QUAD RIVETED OVERLAPS FOR 1/2 LEN TO TREBLE AT ENDS  
UPPER DECK SHEERSTRAKE QUAD RIVETED OVERLAPS FOR 1/2 LEN TO TREBLE & DOUBLE AT ENDS  
STRAKE BELOW TREBLE  
RAISED 2<sup>nd</sup> DECK QUAD  
STRAKE BELOW TREBLE  
KEEL TO UPPER TURN OF BILGE TREBLE  
UPPER TURN OF BILGE TO STRAKE BELOW SHEERSTRAKE TREBLE RIVETED OVERLAPS  
TREBLE TO DOUBLE AT ENDS  
UPPER DECK STRAINERS QUAD RIVETED OVERLAPS FOR 1/2 LEN TO DOUBLE AT ENDS  
R.Q. DECK PLATING DOUBLE RIVETED OVERLAPS FOR 1/2 LEN SINGLE AT ENDS  
CENTRE GIRDERS TREBLE  
MARGIN PLATE AND MIDDLE LINE STRAKE DOUBLE RIVETED OVERLAPS  
TANK TOP PLATING DOUBLE RIVETED OVERLAPS FOR 1/2 LEN SINGLE AT ENDS  
POOP, BRIDGE & FOKLE DECK STRAINERS PLATE TREBLE RIVETED OVERLAPS  
PLATING DOUBLE RIVETED OVERLAPS FOR 1/2 LEN SINGLE AT ENDS

### CELLULAR DOUBLE BOTTOM

FLOORS 54 ON EVERY 3<sup>rd</sup> FRAME 44 IN BOILER SPACE  
FLOORS ON EVERY FRAME IN ENGINE SPACE, UNDER BOILER BEARERS & AFOOD OF 1/2 LEN  
FLOORS AT ENDS 56

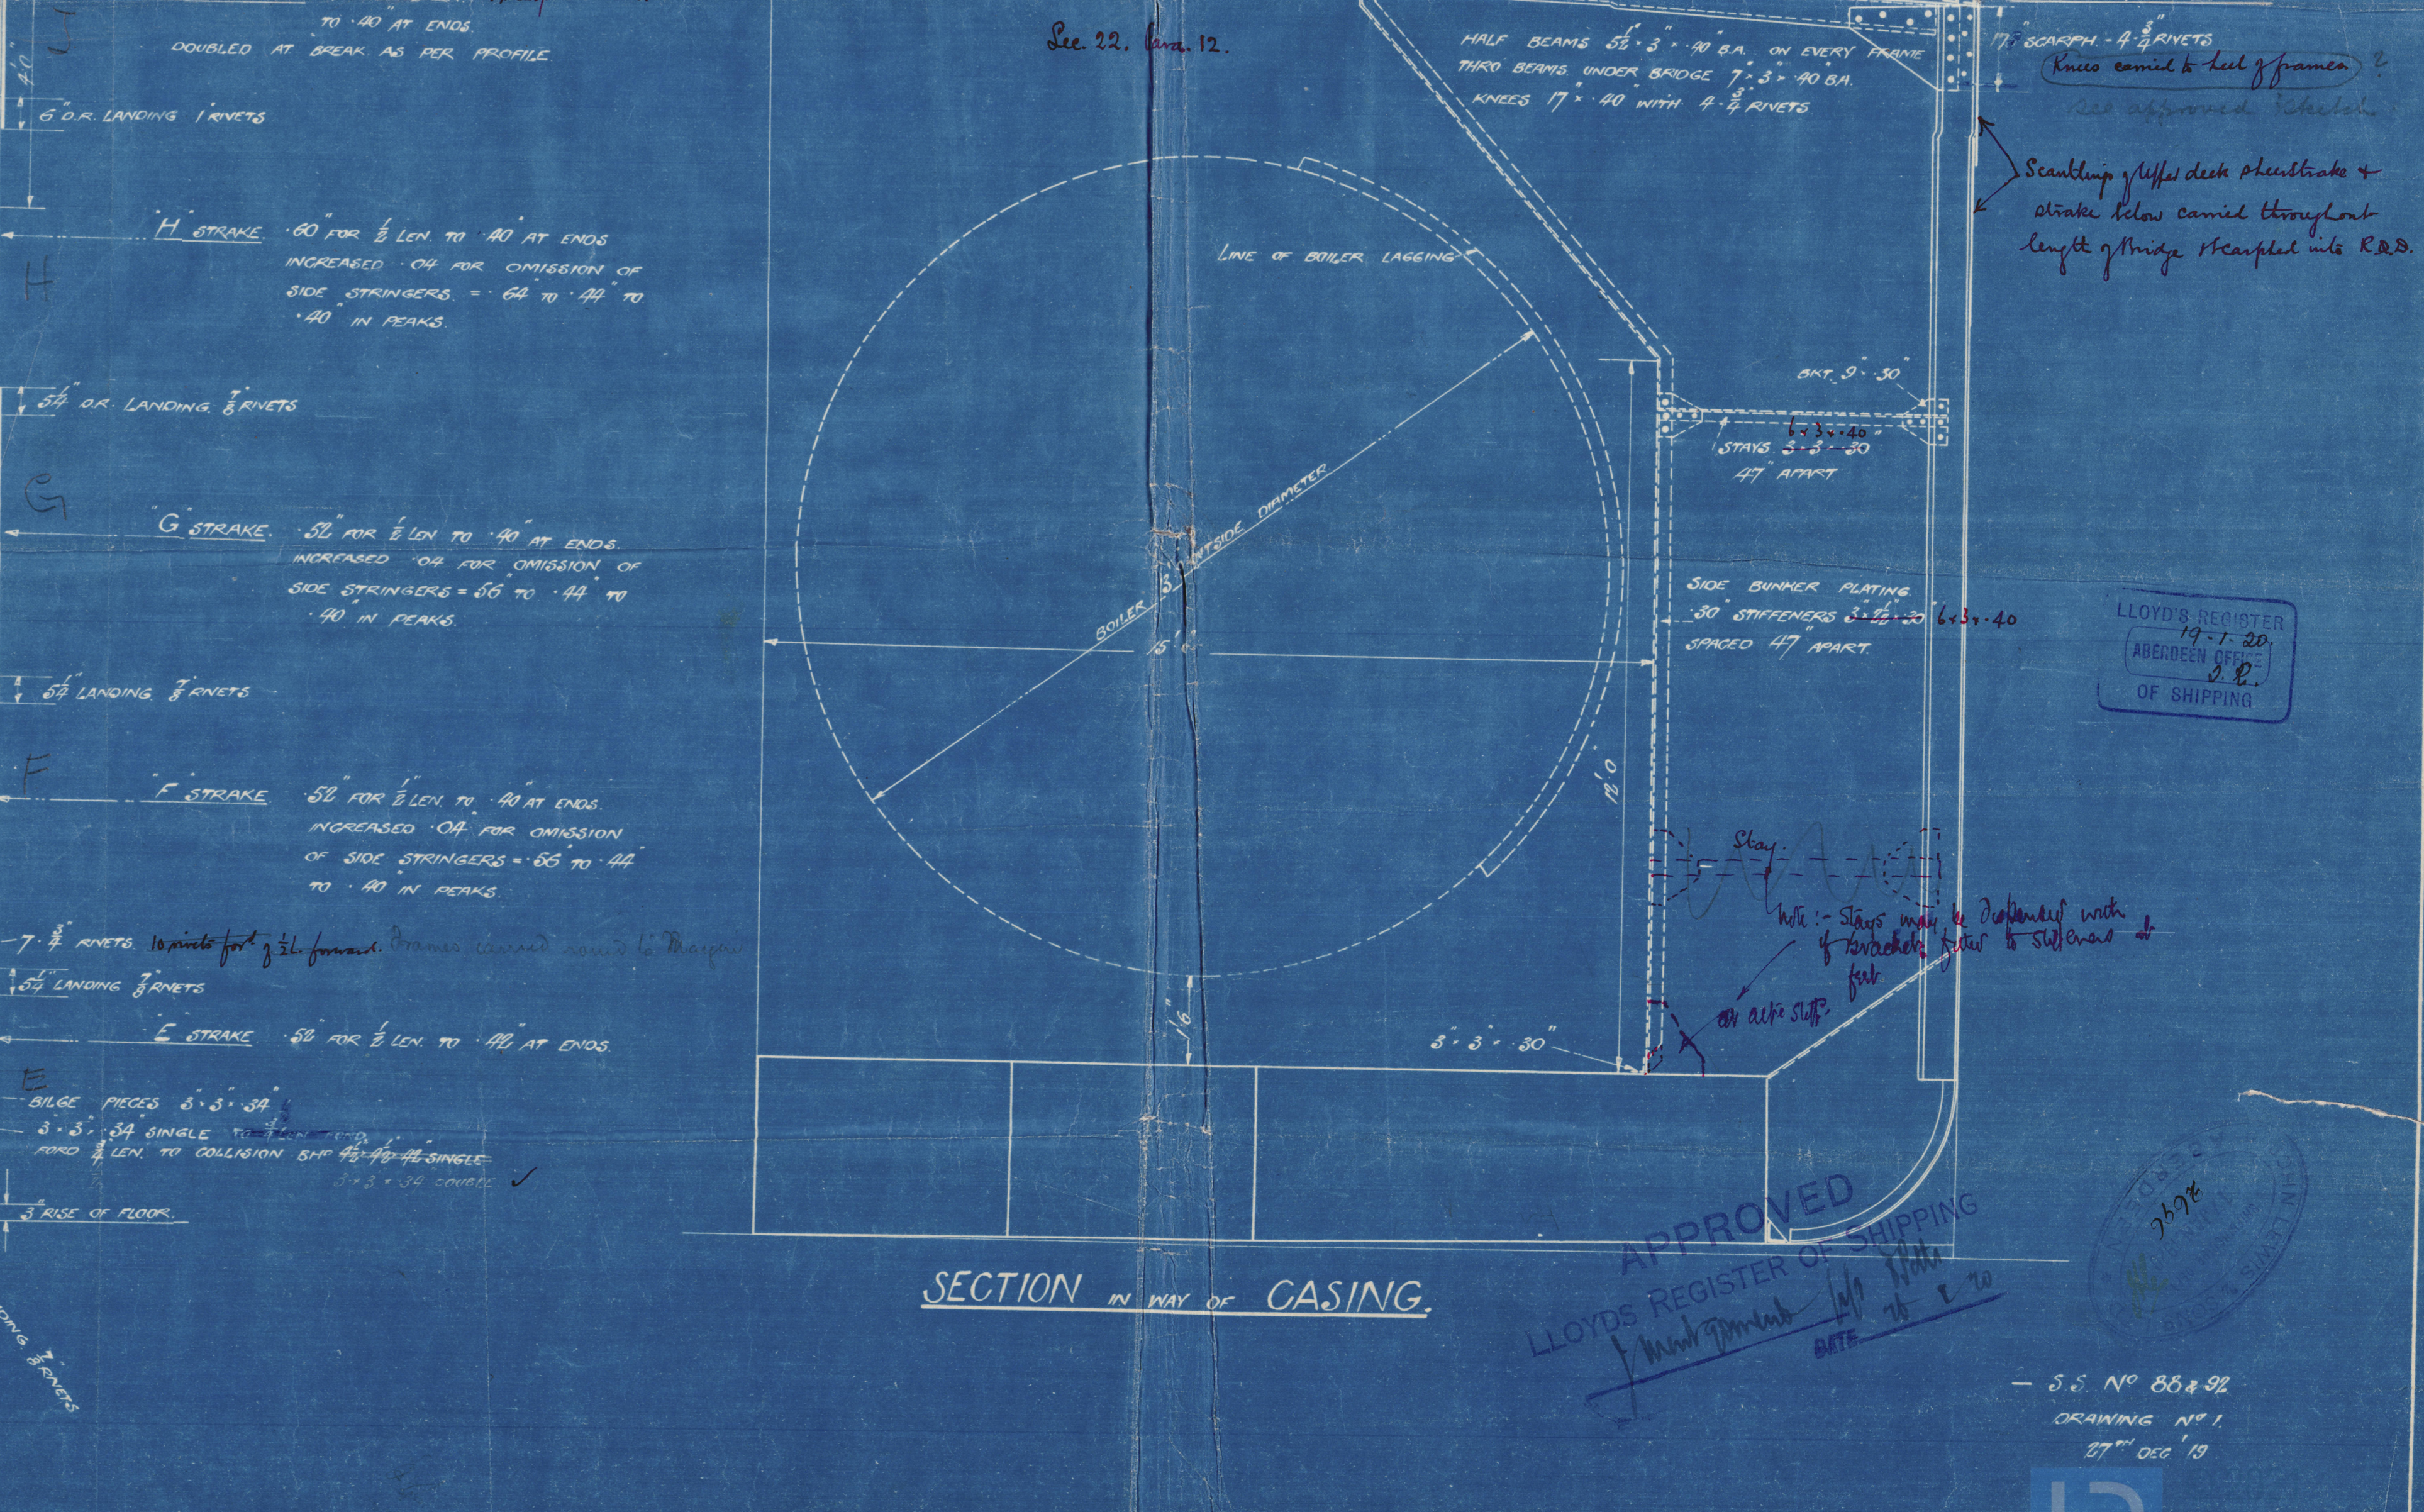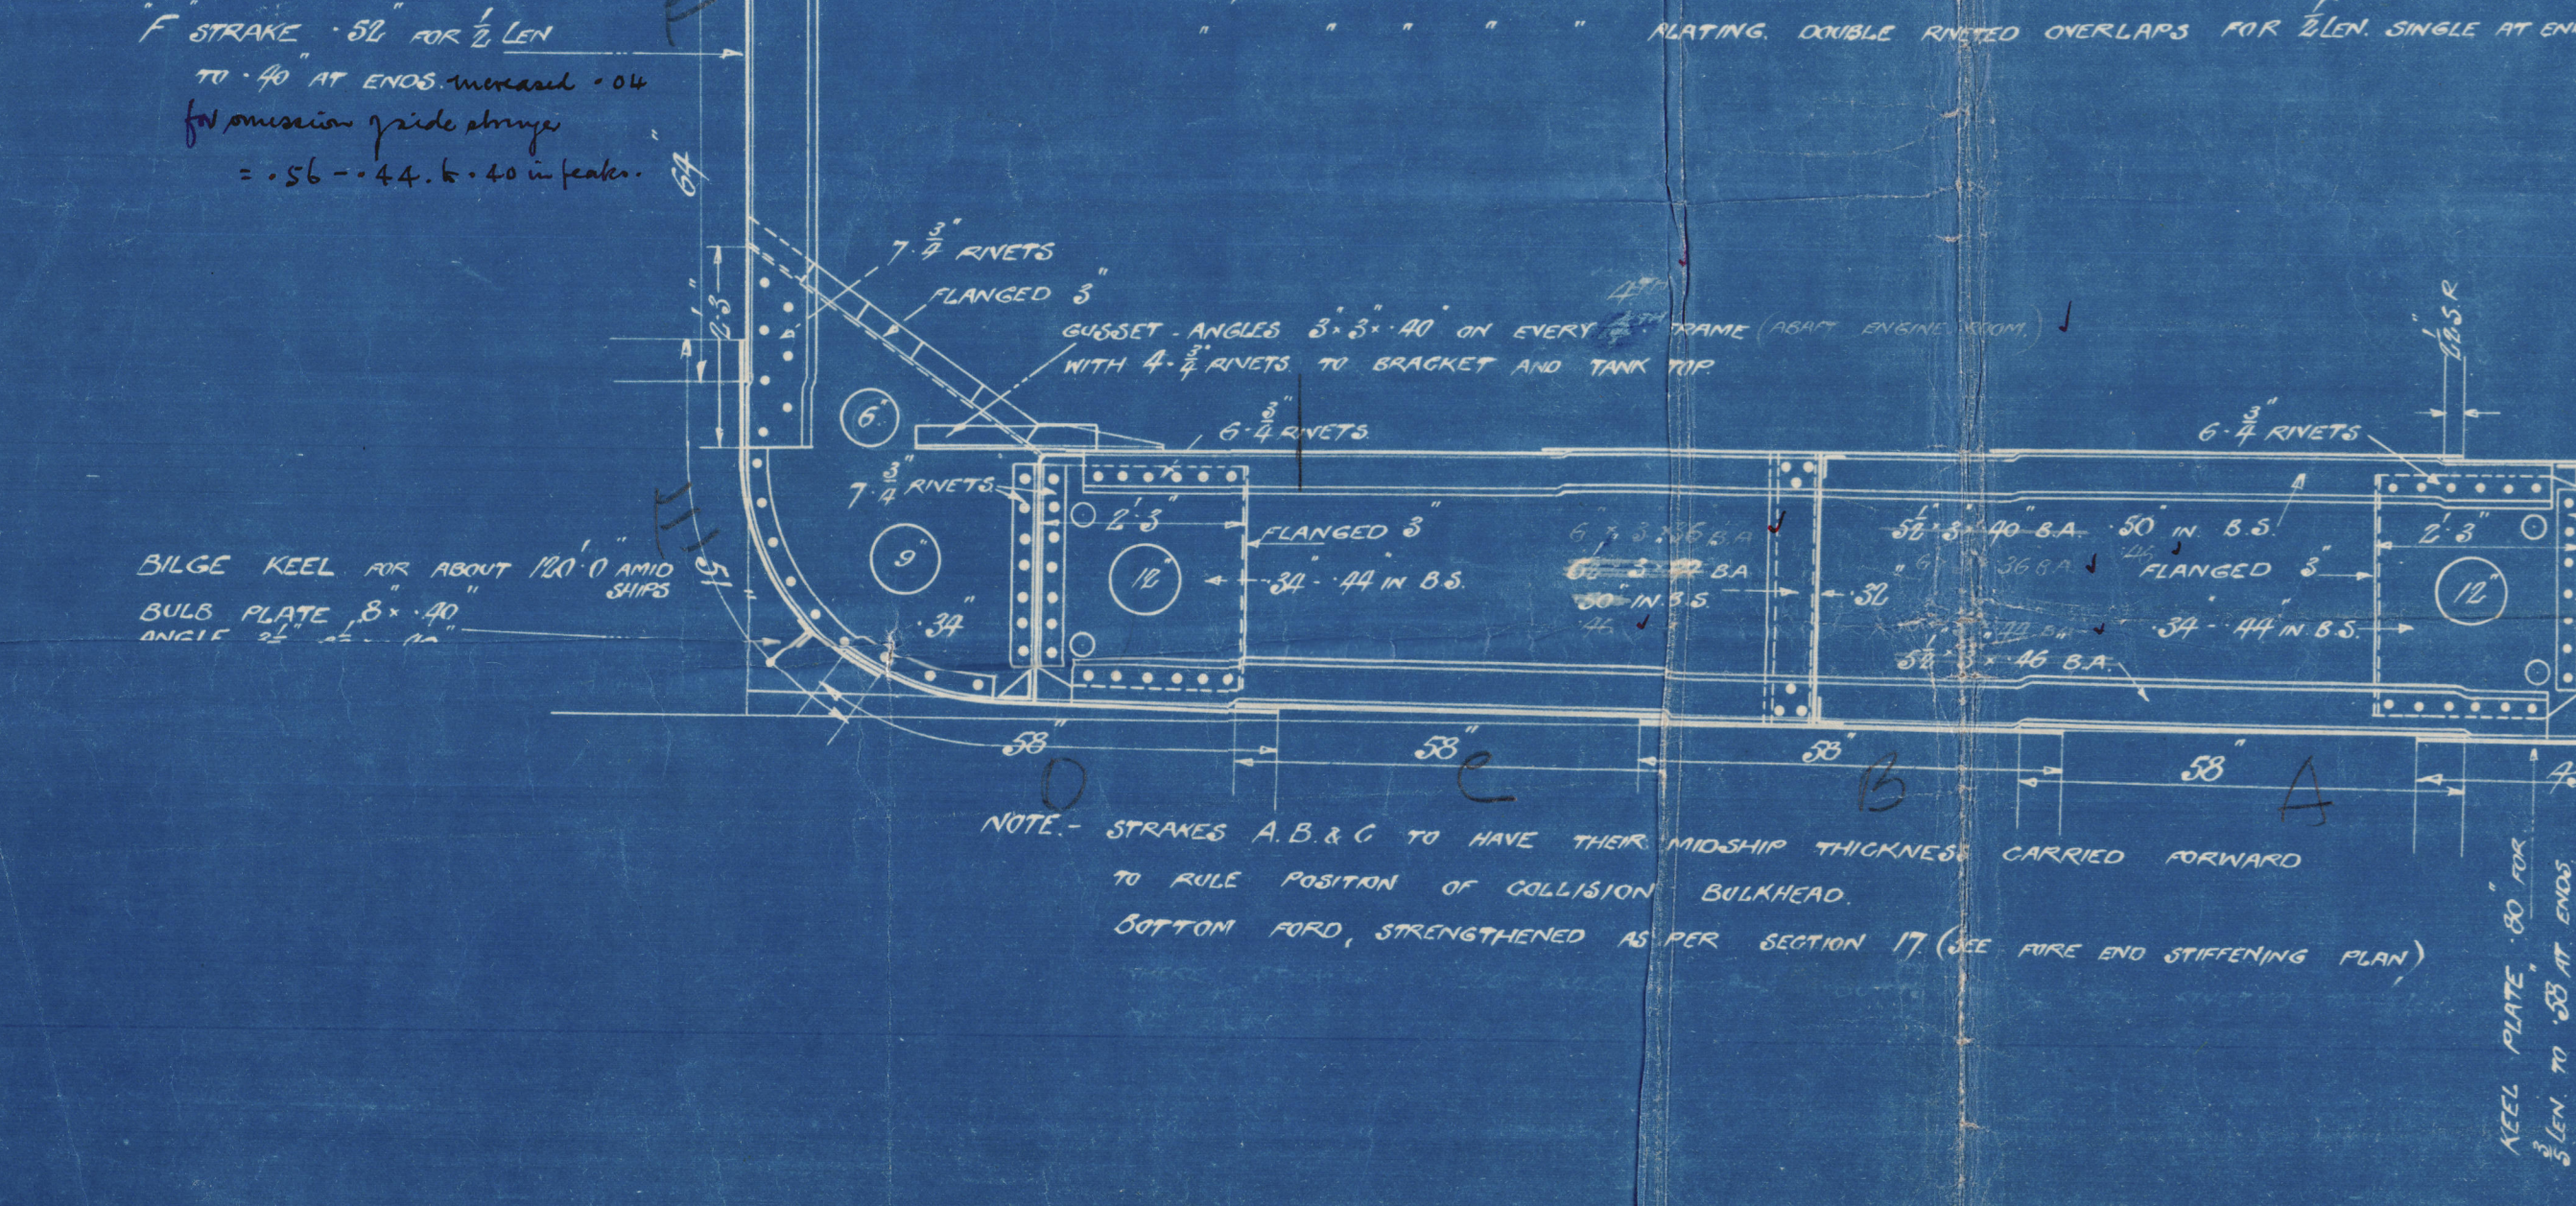

APPROVED  
LLOYD'S REGISTER OF SHIPPING  
19-7-20  
16531.07  
DATE 16-7-20

S.S. No 88 & 92  
DRAWING No 1  
27 DEC 19



S. S. N<sup>os</sup> 88+92.

MESSRS J. LEWIS & SONS LD

MIDSHIP SECTION.

N<sup>o</sup> 88. = ELAINE LLEWELLYN \*

ABN. REPORT N<sup>o</sup> 13196.

N<sup>o</sup> 92. = "BETTY LLEWELLYN".

ABN. REPORT N<sup>o</sup> 13506.

*Moyle*

*Leusmita*

*M. N. Sousanna Papadatu*

*\* Ex Master Nicolas '55 \**



© 2021

Lloyd's Register  
Foundation

009994-010003-0111

1110-80000-46660

009994-010003-0111

1110-80000-46660



© 2021

Lloyd's Register  
Foundation