

STEEL STEAM TUG SII.

SECTION AT FRAME 28 SCALE 1:20.

Equipment as per Rule



To Class 100 A1
"For towing purposes"

77' x 19'-9" x 10'-4"

Numeral

30.08 and 2316

$$\frac{L}{D} = 7.4$$

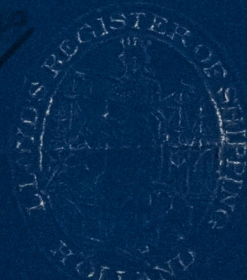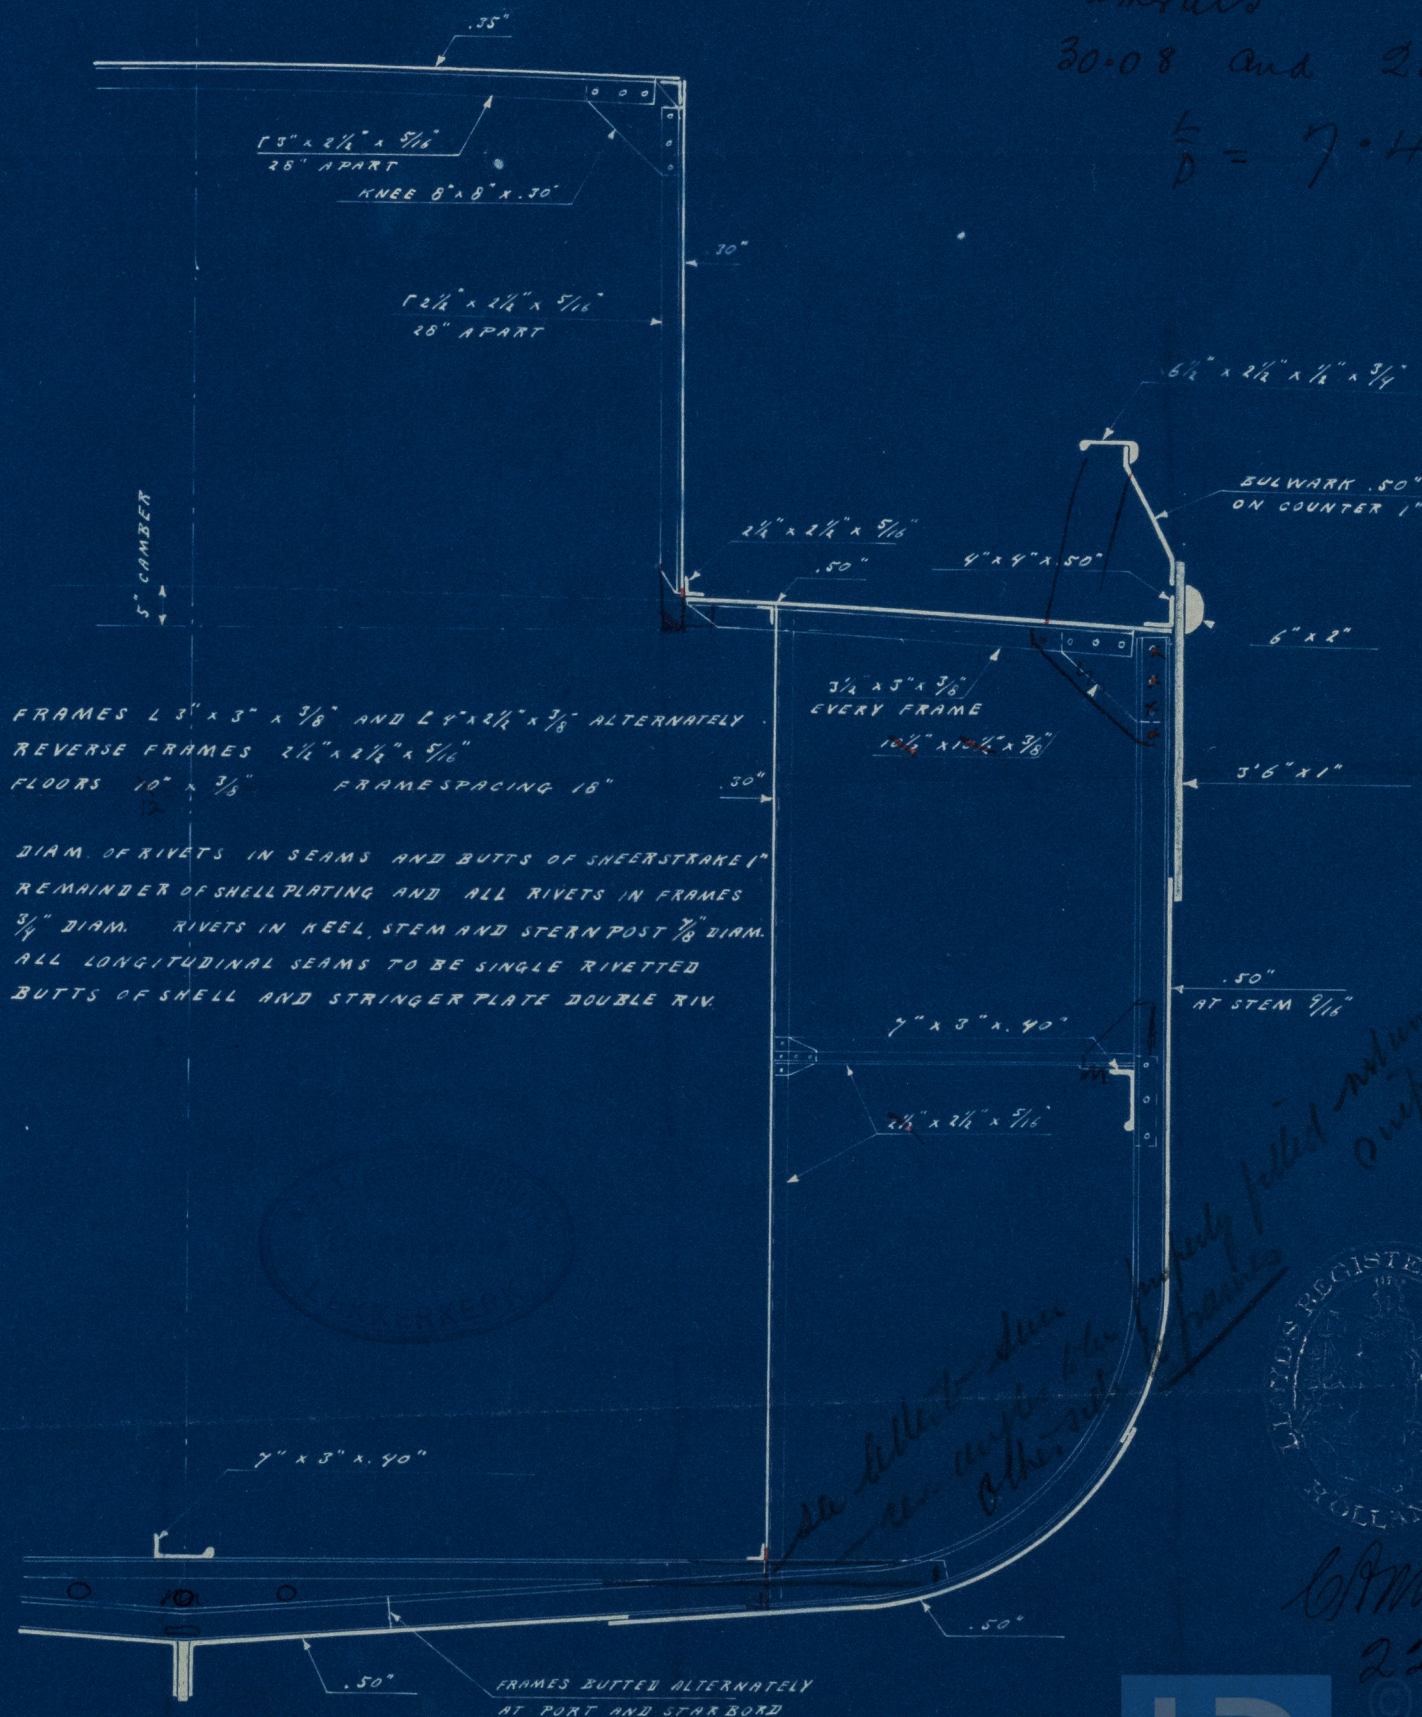

C. P. Mullan

22-11-25

© 2021

SII-3

Lloyd's Register Foundation

010012-010023-0107



Steel Single Screw Tag
S. II

T. van Duwendijk's
Scheepswerf

Lekkerkerk

Midship Section

~~Gen. No 11258~~

"Cainrock"
Rot. 13590

010012-010023-0107



© 2021

Lloyd's Register
Foundation