


RUDDER AND STERNFRAME

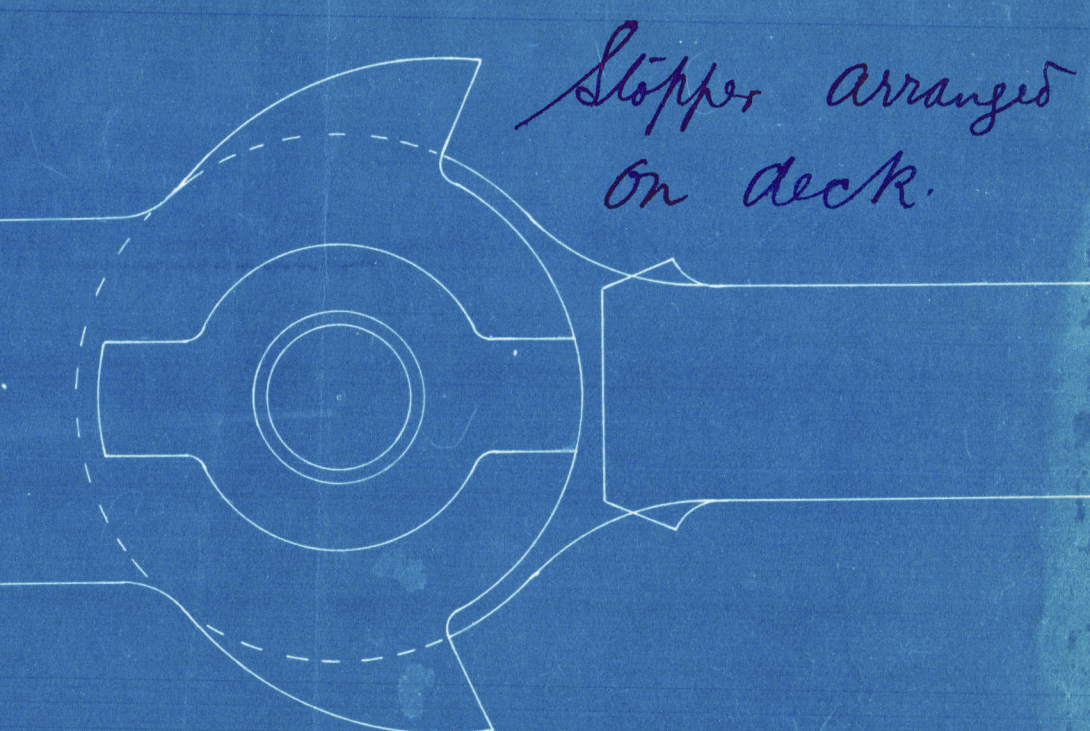

S 2-4.

22/11 '23

69 Miller
27-11-23

010012- 010023- 0100

T van Duwendijk's Scheepwerf
Steam Tug S.L.
Steelframe & Rudder

~~Gen. Box #258.~~

"Carnitrock"
Rot. 13590