

Lloyd's Register of Shipping.

(Report on Vessel No. _____ Port _____)

No.

SHIP FORGINGS ~~OR CASTINGS~~

I have to report that the undermentioned Iron ~~or Steel~~ Forgings ~~or Castings~~, manufactured by *Geb. N. & E. de Jongh* of *Bolnes* for the Vessel No. *52*, being built by *J. van Duwendyk's Scheepswerk of Beekkerkerk* have been inspected by me as set forth below and found to be, so far as can be seen, *sound and free from defects.*

Mark on Forgings or Castings.


Lloyd's
No. 131 & 132
LV 2-24

Rotterdam 25th of March 1924

[Signature]

	STERN FRAME.	RUDDER FRAME.	STEM.
Material*	<i>Scrap iron</i>	<i>Scrap iron</i>	/
How made	<i>Forged</i>	<i>Forged</i>	/
Dimensions	<i>5 1/4" x 2 1/4"</i>	<i>3 3/4" to 2 1/2" x 2 1/2"</i>	/
Progress on Inspection	<i>Forged and completed</i>	<i>Forged and completed</i>	/
Date when Inspected	<i>29/1 - 11-14/2 - 1924</i>	<i>29/1 - 11-14/2 - 1924</i>	/
CASTINGS.			
Tests on Standard Test Pieces.	/	/	/
Tensile Test—	/	/	/
Tons per square inch	/	/	/
Extension per cent. ...	/	/	/
Cold Bending Test—	/	/	/
Angle before fracture	/	/	/
Drop Test—	/	/	/
Height from ground ...	/	/	/
Hammering Test—	/	/	/
If made according to Rules and found satisfactory ...	/	/	/

SKETCHES OF FRAMES SHOWING POSITION AND DESCRIPTION OF WELDS OF FORGINGS.

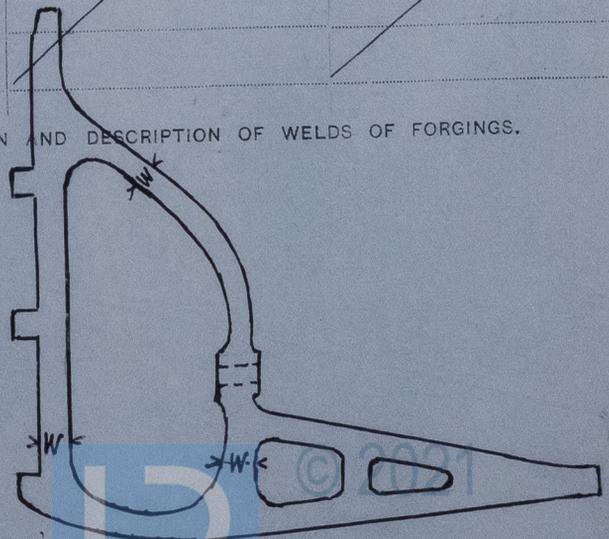

Fee (if any chargeable) £ _____
To be paid at *Rotterdam*.

If of Iron, state whether scrap or puddled Iron. If of Steel, state whether made on the Open Hearth process.

The words FORGINGS or CASTINGS, IRON or STEEL, should be struck out as may be required.