

D I K E S O L S

LENGTH 3. P. 180'-0" BREADTH 2 x 26'-6" DEPTH MLD 15'-0"

Is CLASS 100 A.1 AT LLOYDS "Single Deck"

✓ 2 SCALE

EQUIPMENT

LENGTH OF BRIDGE & POOP 10' 0" LENGTH OF FORECASTLE 37' 8 1/2"

DECK HOUSE 2-10" -

EQUIPMENT NO 11833 LETTER K

✓ 3 BOWERS. STOCKLESS. COLLECTIVE WEIGHT 54 $\frac{1}{2}$ CMTS

✓ 1 STREAM ANCHOR. EX STOCK 24

✓ KEDGE " " " " 22 "


✓ 210 FATHOMS OF 1 ⁵/₁₆ STUD CHAIN CABLE

60 34 STEEL WIRE STREAM

✓ 90 " 3" " TOWLINE

✓ 90 ... 24 ... ANSWER } if a

if with Owners
consent.

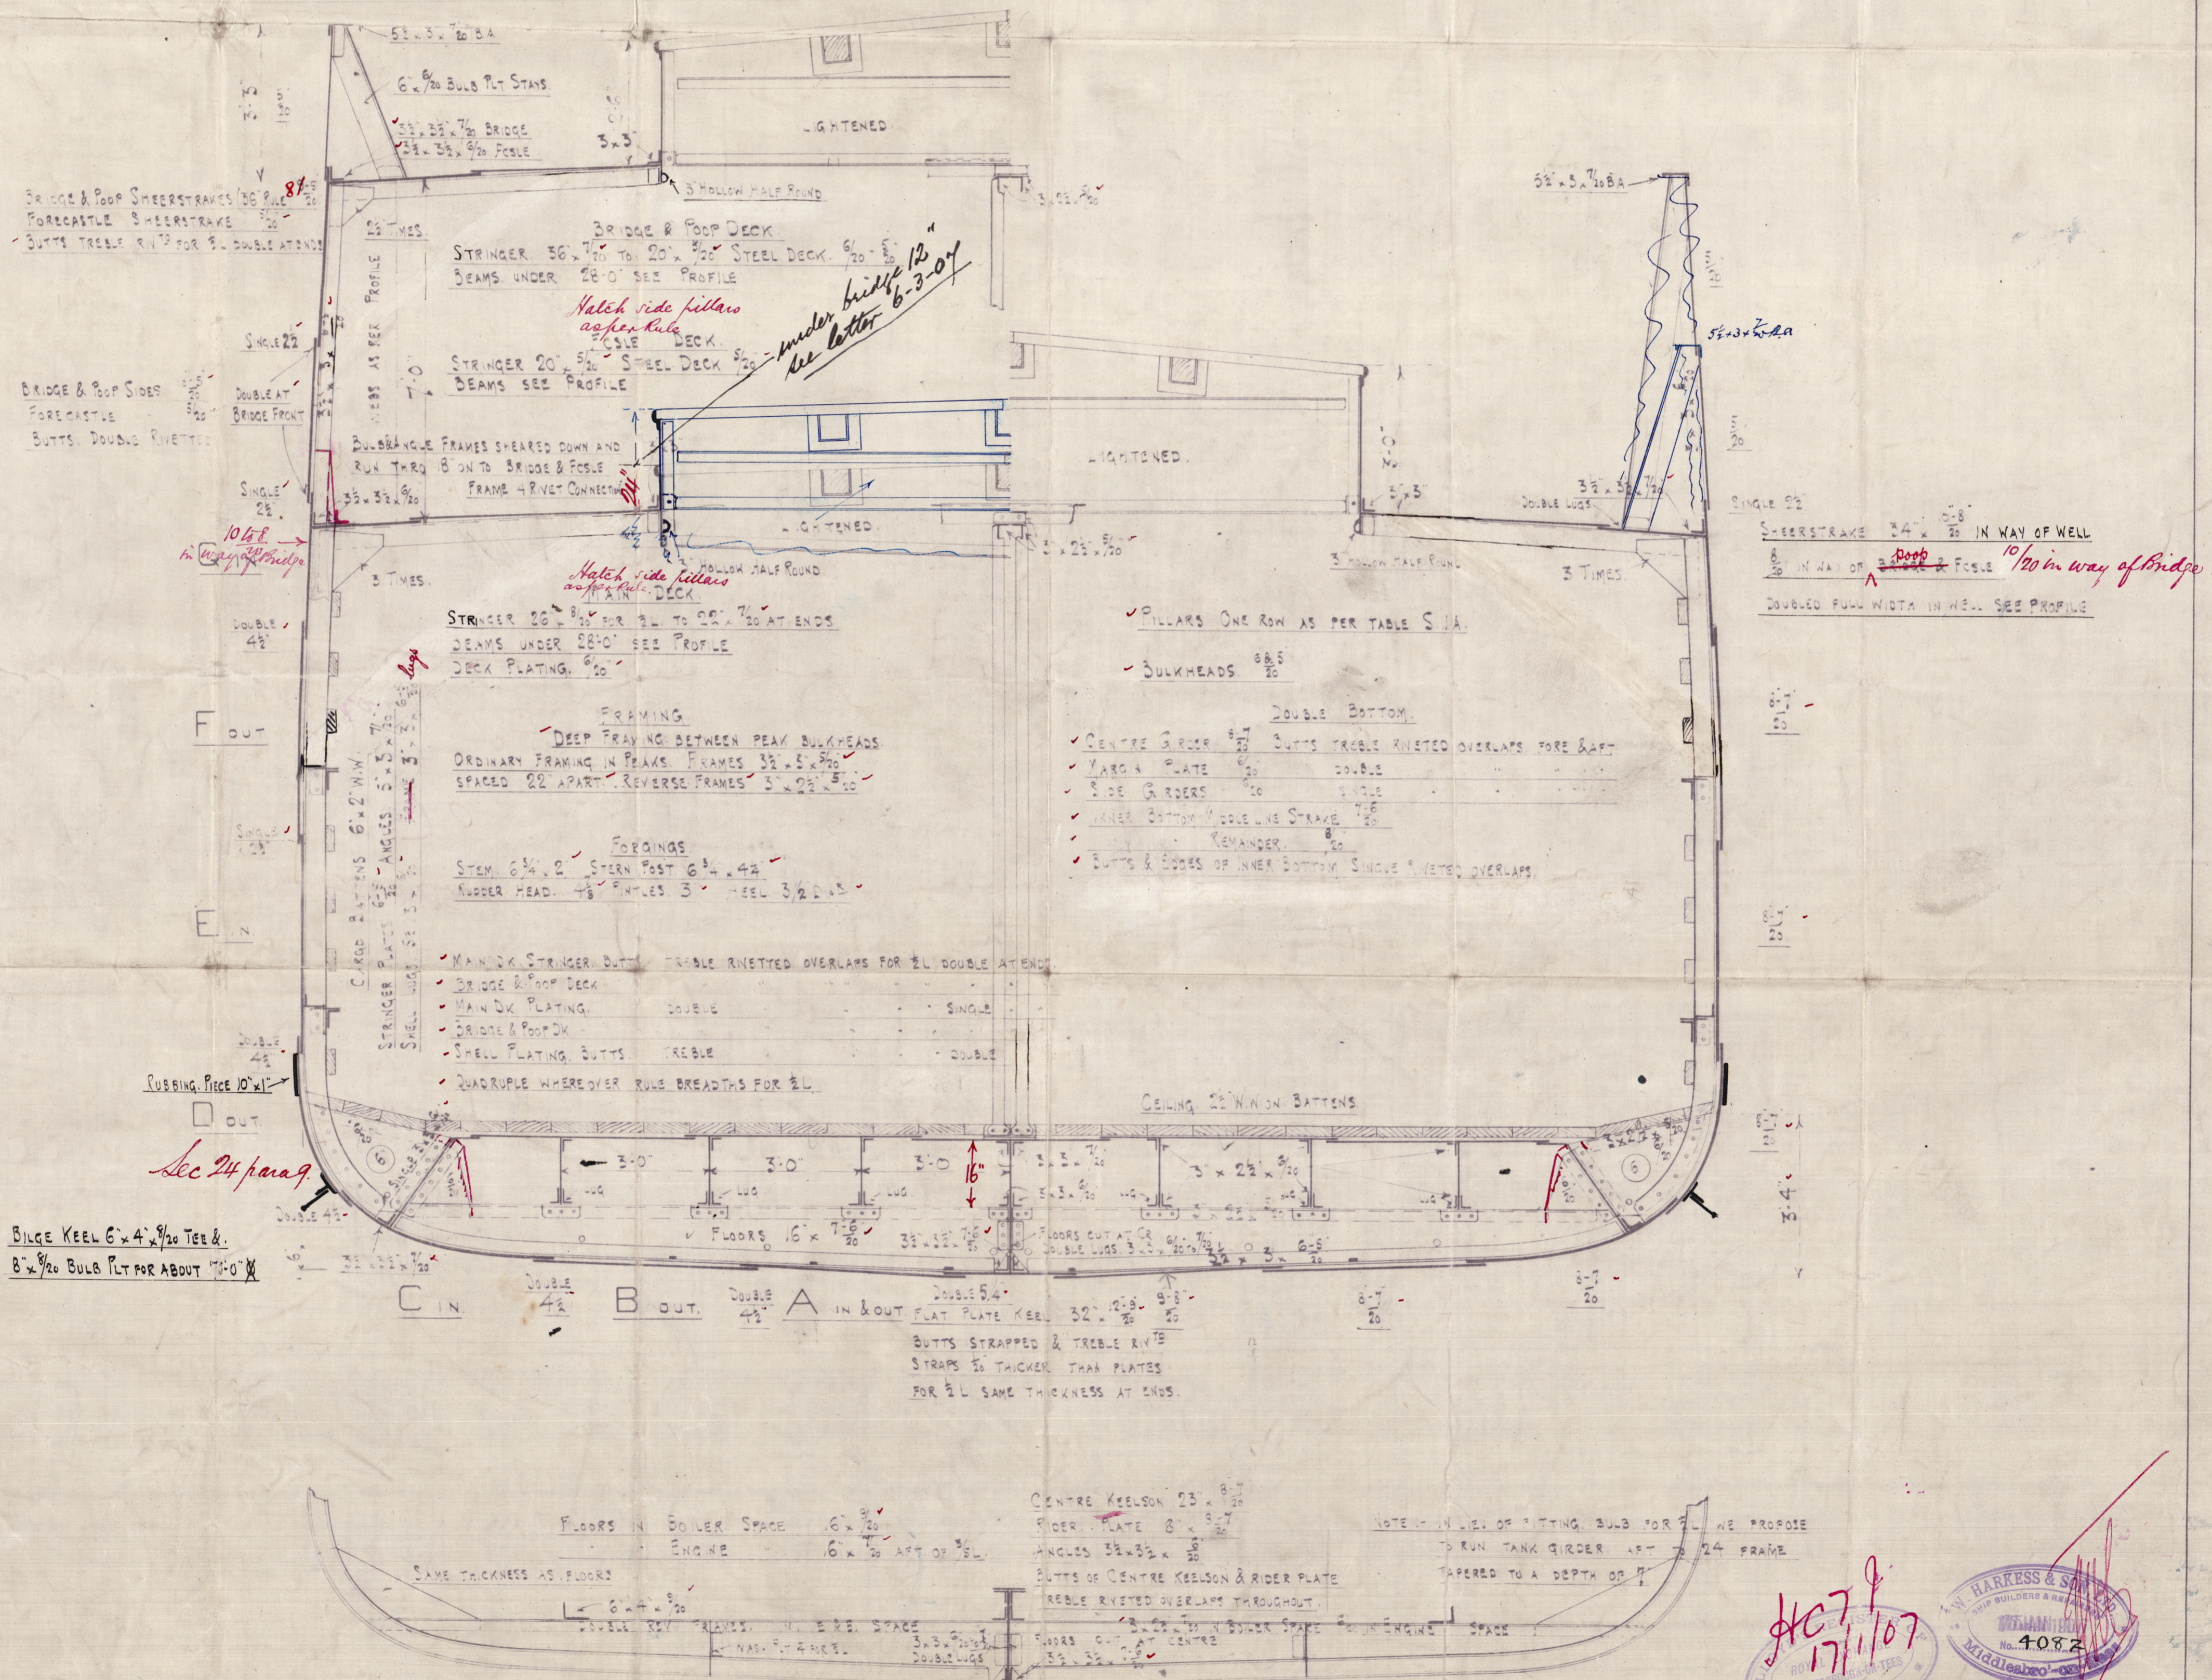

W. HARKNESS & SON LTD
SHIPBUILDERS & REPAIRERS
EAST SLIPWAY
MIDDLESBROUGH-ON-TEES

SECTION IN WAY OF E & B SPACE

CB
23.1.07
1.2.07

W. HARKESS & SON, LTD.
SHIP BUILDERS & REPAIRERS
THE MANTON
No. 4082
Middlesbrough

N

© 2021



Lloyd's Register
Foundation

010012-010023-0168

Harkness & Son




170

Midship Section

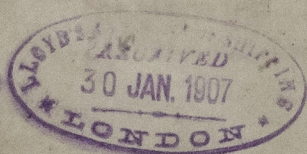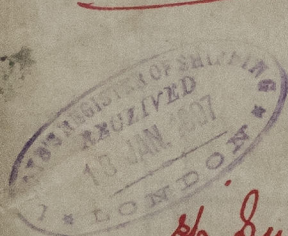

sp Sussex Coast

Indk report W-5214

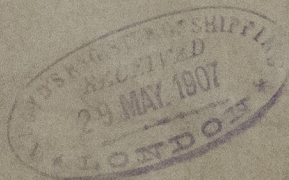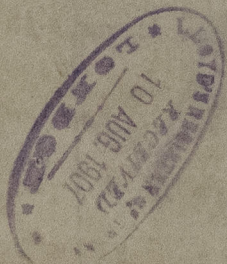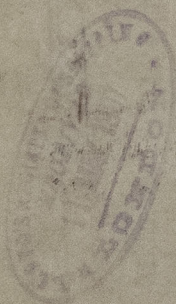

© 2021

Lloyd's Register
Foundation

010012-010023-0168