


Lloyd's Register of Shipping.

Ship's Name *M/V "CAIRNGORM."*


Official No. *165950.*

Memorandum of alterations reported since ship was surveyed for assignment of Load Lines in at date of build.

Sketch showing New Paint Room, Gunner's Accommodation under Forecastle deck.

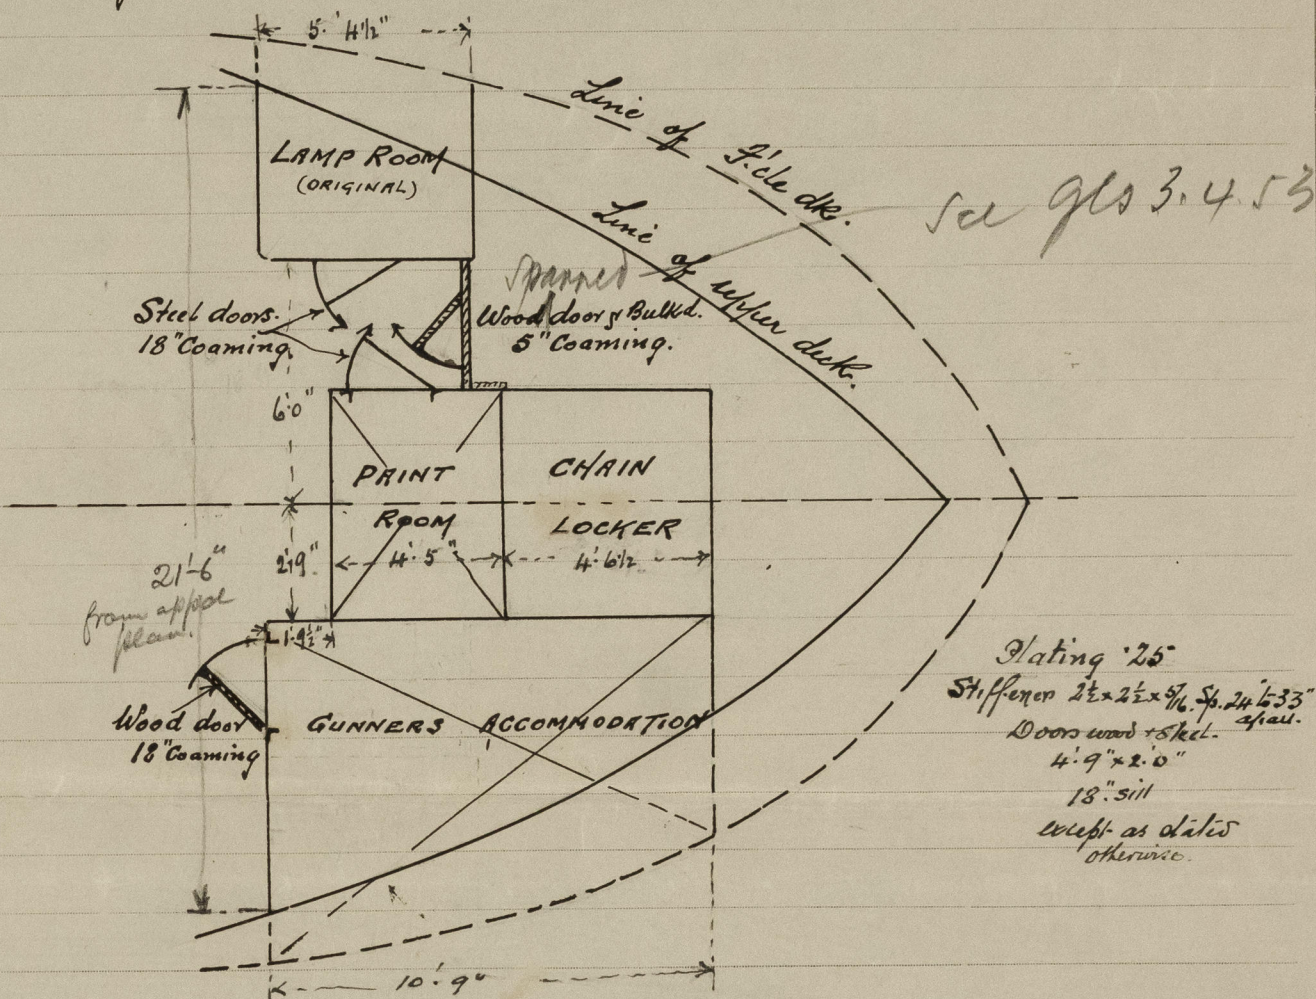

No. 2 Hatchway reduced in length by 3' 0"

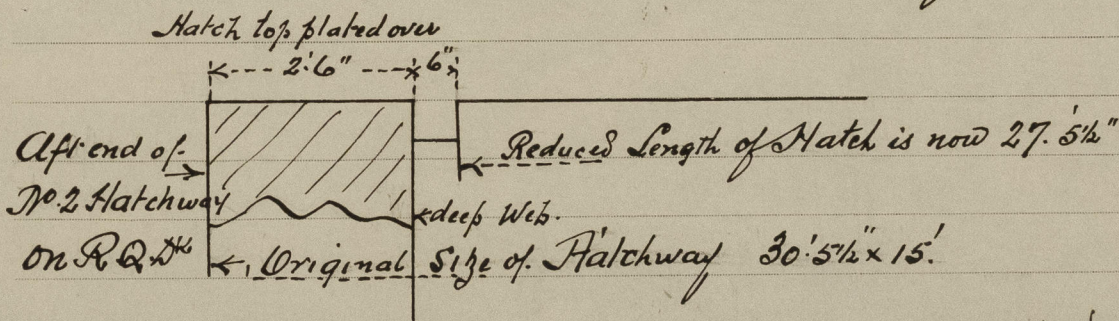

Will March 1944.