
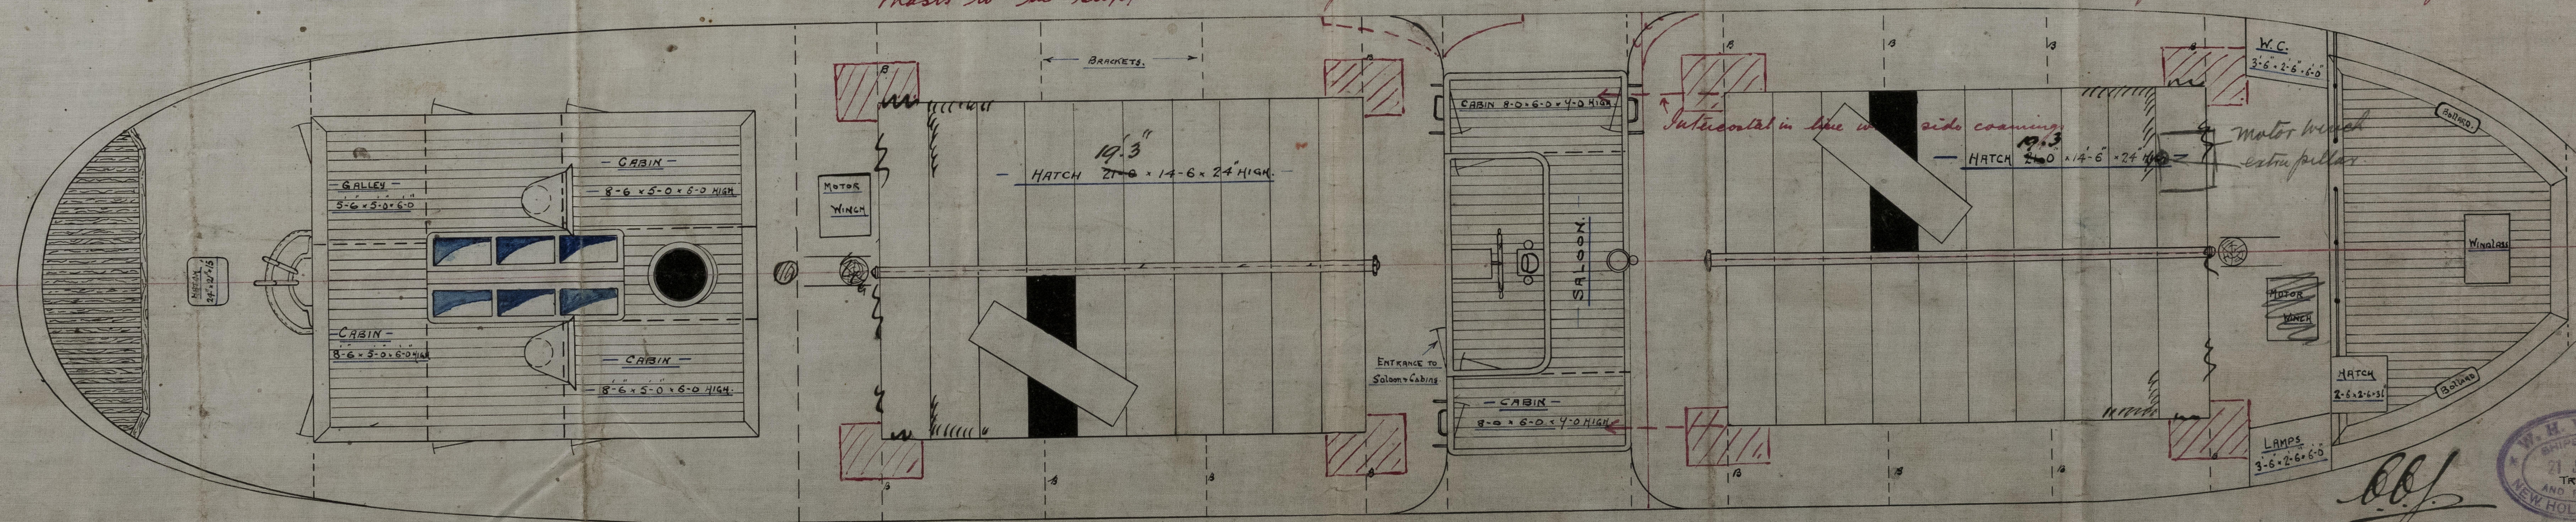


GENERAL ARRANGEMENT OF MOTOR COASTER.

110'-0" B.P. x 21'-0" Ex x 11'-0" MLD.

To CLASS 100A1.

SCALE: - 1/4" = 1 FT.

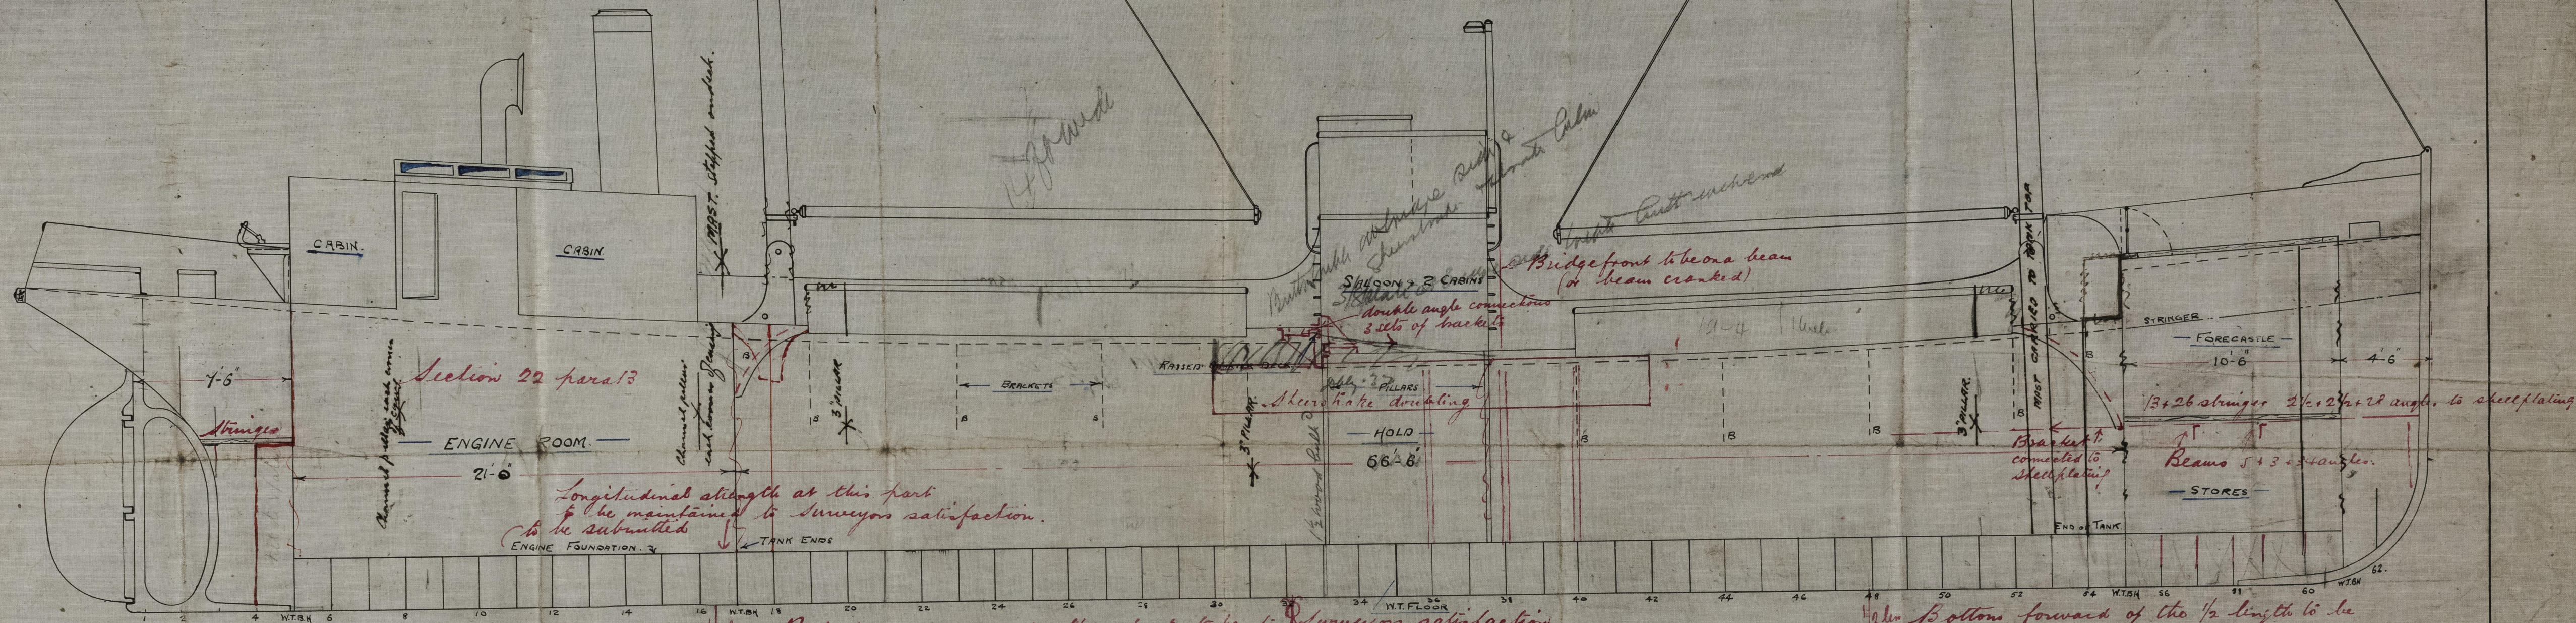

W. H. WARREN
SHIPBUILDER
21 JAN 1915
TR. N° 86
NEW HOLLAND, HULL

28. 1. 15.

Profile & Deck Plans

W. H. Warren

110 X 21.5 X 11

No 127

"Mary Birch Hull Hull Rpt
No 2985"

"Mary Birch Hull Rpt No
30,144."

1/2 "Vincenzo Domio"



© 2021

Lloyd's Register
Foundation

010037-010045-0206