


Edwin B. de Golia

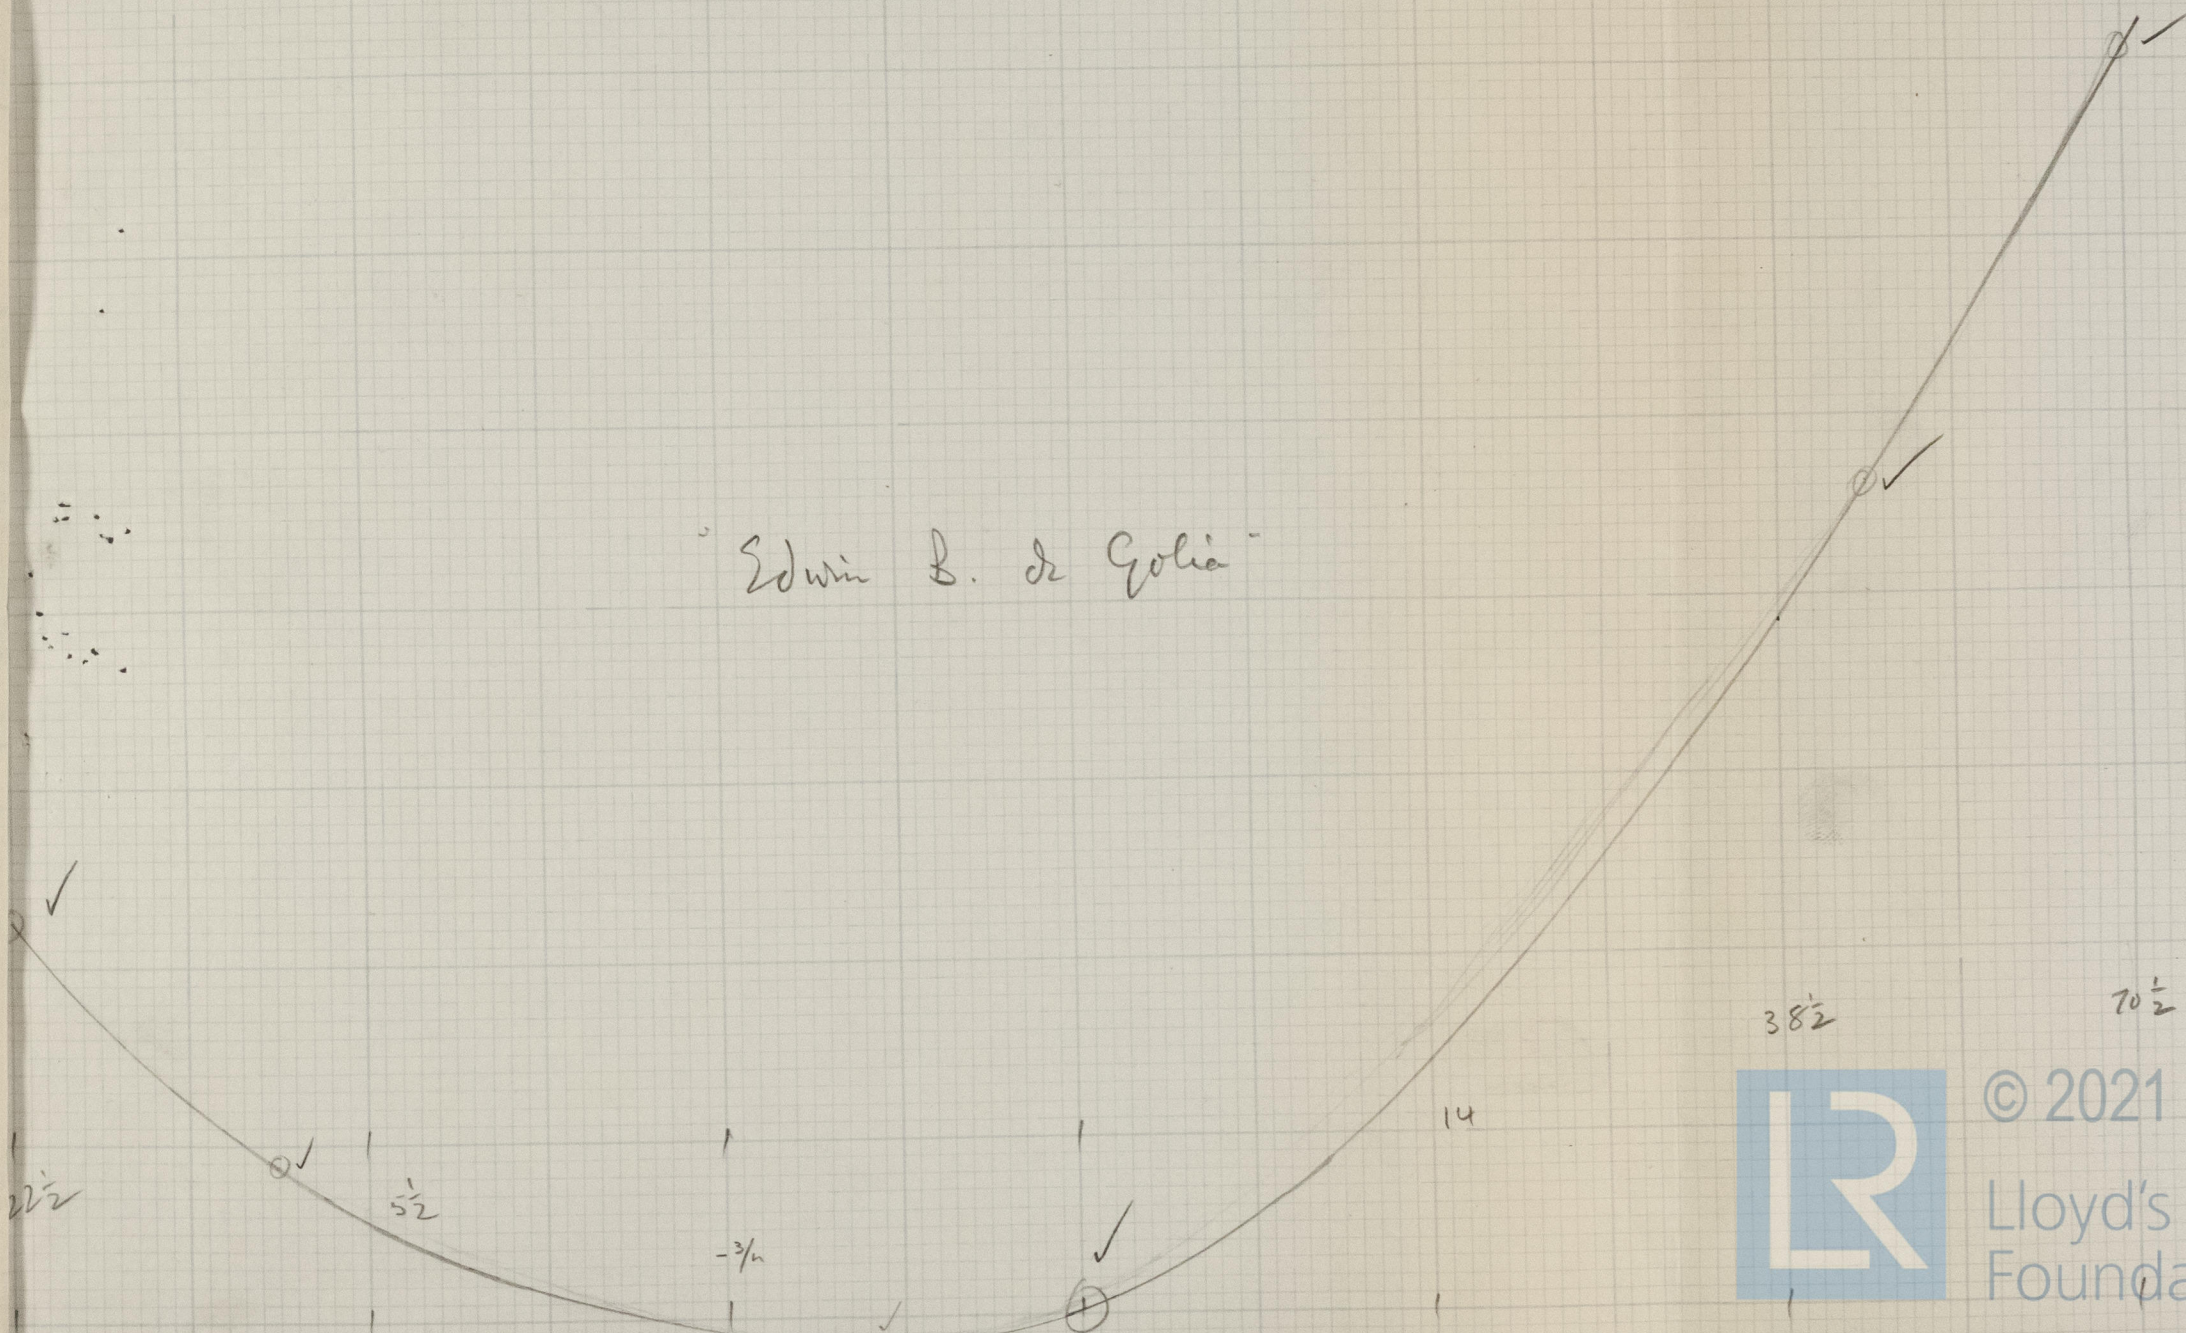

© 2021

Lloyd's Register
Foundation

010056-010066-0114

Tropical Fresh Water Line (above center of Disc)	12"	Tropical Fresh Water Freeboard	21"-7 1/2"
Fresh Water Line	6 1/2"	Fresh Water	16"-16"
Tropical Line	5 3/4"	Tropical	15"-15"