





Messrs Richardson Duck & Co



N<sup>o</sup> 662

Mid: Dec:

as built D.S. 315

J. Kenilworth

Mdb report N<sup>o</sup> 10057

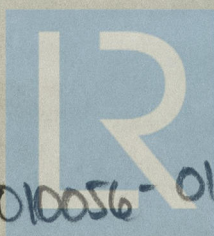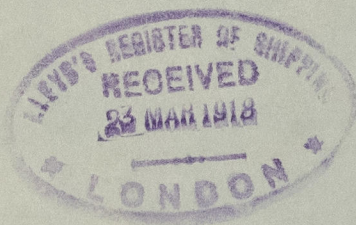

© 2021

010056-010066-0174

Lloyd's Register  
Foundation