

# — PROFILE AND DECK PLANS —

SCALE 1/8" = 1 FOOT


CLASS 100A1 LLOYDS

RULE DIMENSIONS 423'8" x 54'6" x 30'12"

TRANSVERSE No 8473


LONGITUDINAL No 36442

UNDERDECK TONNAGE 5203 TONS

 

SEE SEPARATE PLAN FOR STERN

PLAN OF SHELTER DECK

 

PLAN OF UPPER DECK

RICHARDSON DUCK & CO. LTD.  
SHIPBUILDERS  
STOCKTON-ON-TES

PLAN No 5768

18/3/18

010056-010066-0115




<sup>2</sup>  
Mess<sup>r</sup> Richardson Duck & Co  
No 662

Profile and deck  
as built DS 215

Sh. Kenilworth

M & M report No. 10057

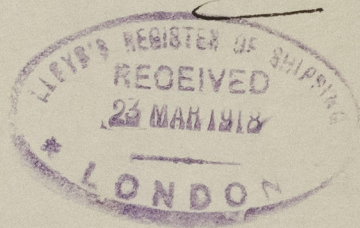

010056-010066-0175



© 2021

Lloyd's Register  
Foundation