


PILLARING THROUGHOUT TO SURVEYORS SATISFACTION

— N^{os} 677-8. —

DIMENSIONS 135'-O.B.P. x 23'-6" EXT x 13'-1" MLD
— SCALE 1/4" INCH —

PLAN No. 429
FOR ENCLOSURE TO
Messrs. Lloyd Pursey &
Part. FROM
COCHRANE & SONS, LTD.
SHIPBUILDERS, SELBY.
DATE 27/7/16 (J8W)

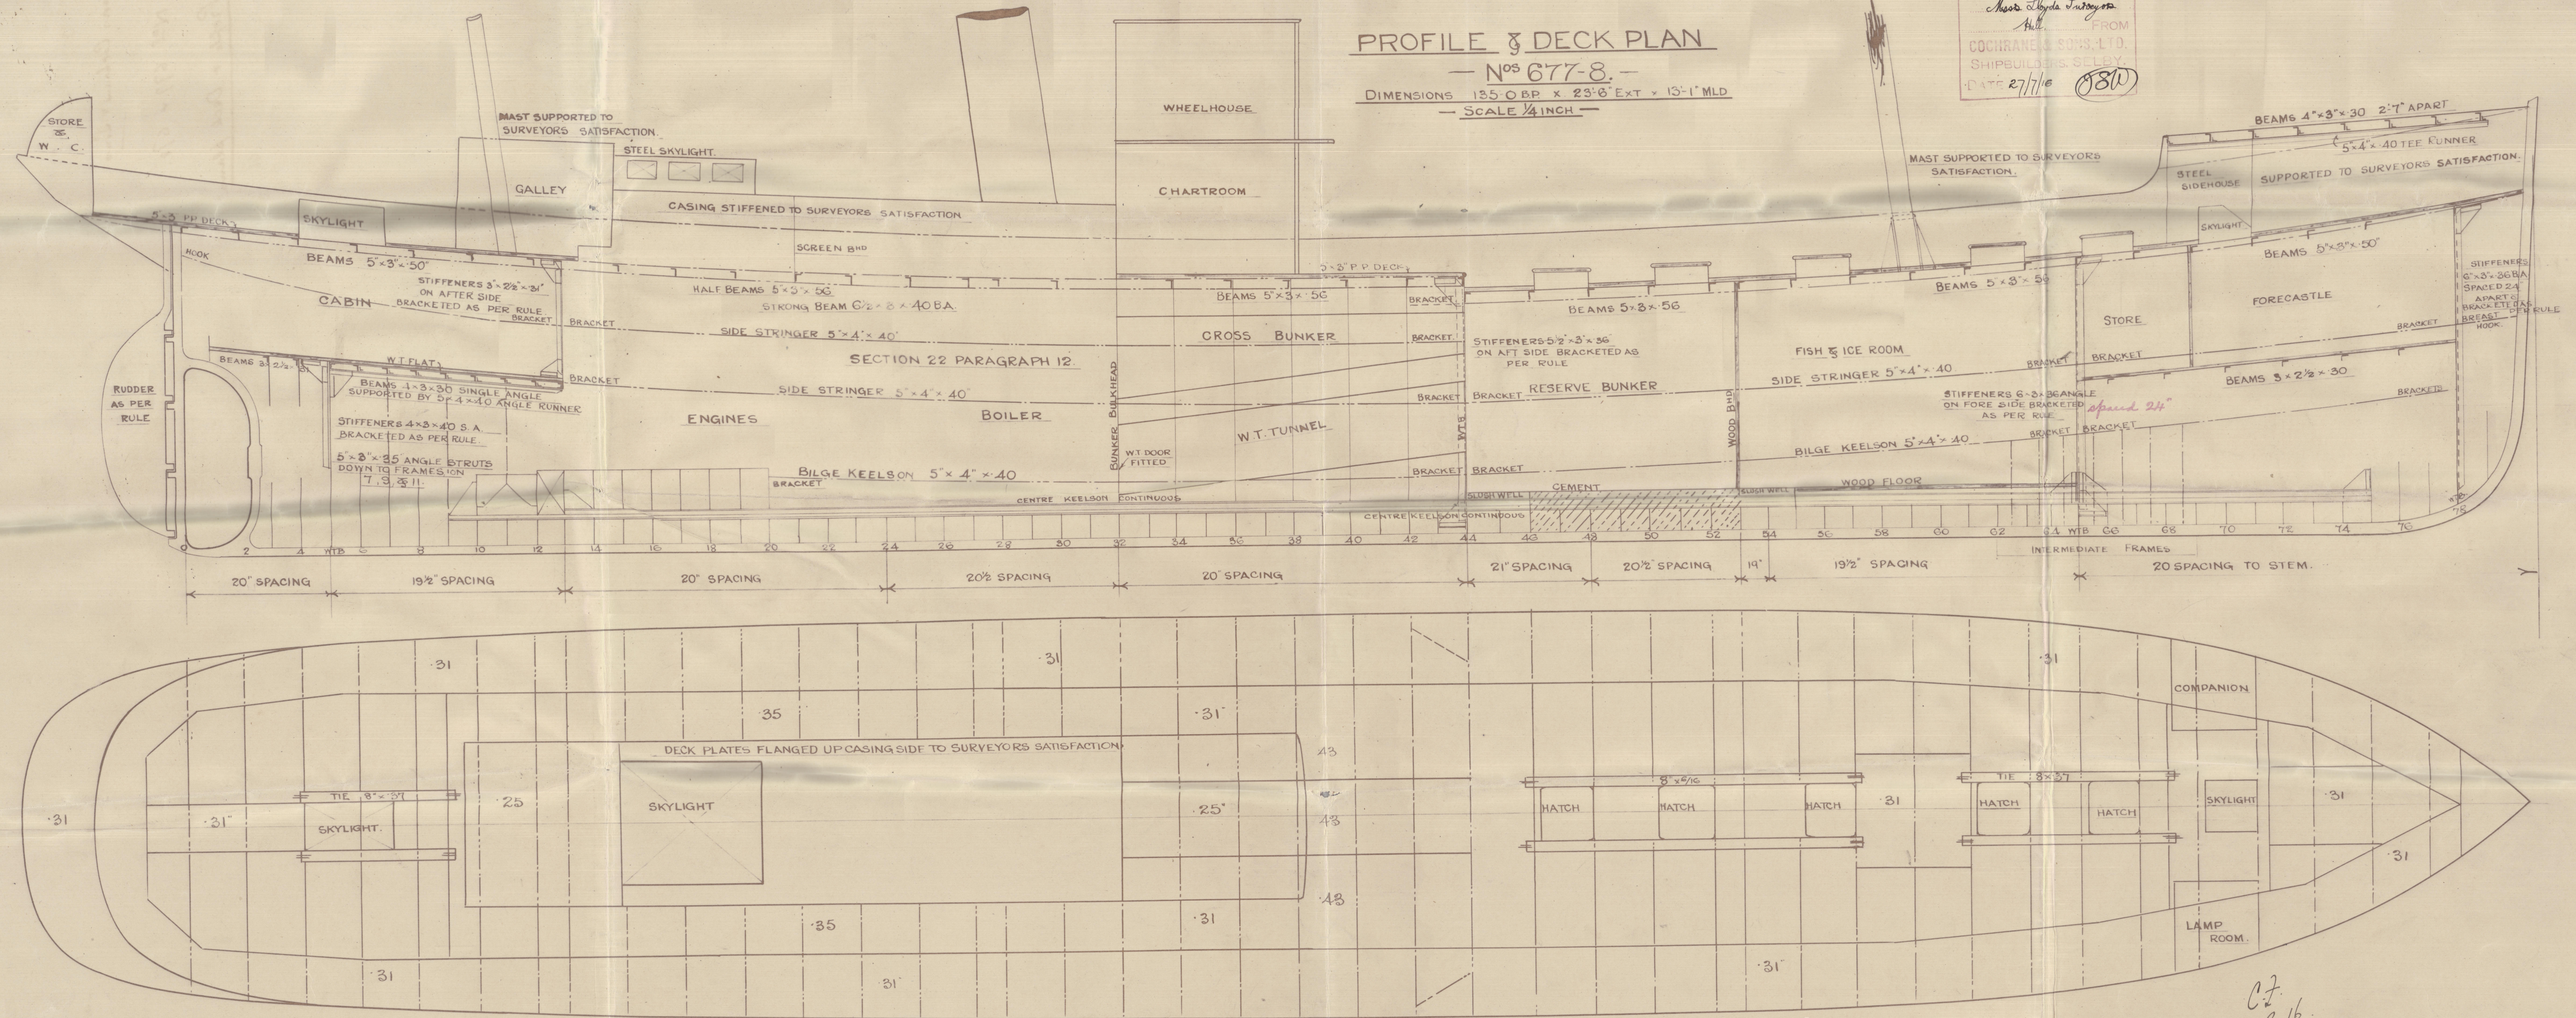

C.7.
2.8.16

"Sadora".



^{ex}
2/3 Vamby. Hull Rpt No. 30072,

Messrs Cochran & Sons

s/s Nos 677 & 678.

Profile & Deck plans

1/5 Venosta Hull Rpt No 30,146



© 2021

Lloyd's Register
Foundation

010056-010066-0291