


SCALE 1/4 INCH = 1 FOOT.
TO CLASS 100 A.I. AT LLOYDS.
RULE DIMS 401' 54" x 52' 73" M^{LD} x 30' 0" M^{LD} TO UPPER DECK.

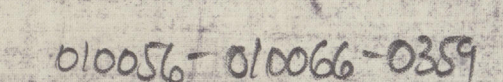

ROBERT DUNCAN & Coy L^d

N^o 357.

PROFILE & DECKS

"KURETAKE, MARU"
^{(AS BUILT).}
ex.

S.S. "BENICIA"

Grk Dep L^d 18399.

010056- 010066- 0359



© 2021

Lloyd's Register
Foundation